PREPARED FOR: TOM MARTIN KEEFE REAL ESTATE INC. 980-A N. WISCONSIN ST.


ELKHORN WI. 53121


PLAT OF SURVEY

- OF -

J.K. SURVEYING INC. N3705 WILLOWBEND LANE LAKE GENEVA, WI, 53147 262-248-3697

LOT 5 OF CALI ACRES SUBDIVISION, LOCATED IN SECTION 35, TOWN 4 NORTH, RANGE 16 EAST, TOWN OF LAGRANGE, WALWORTH COUNTY, WISCONSIN.

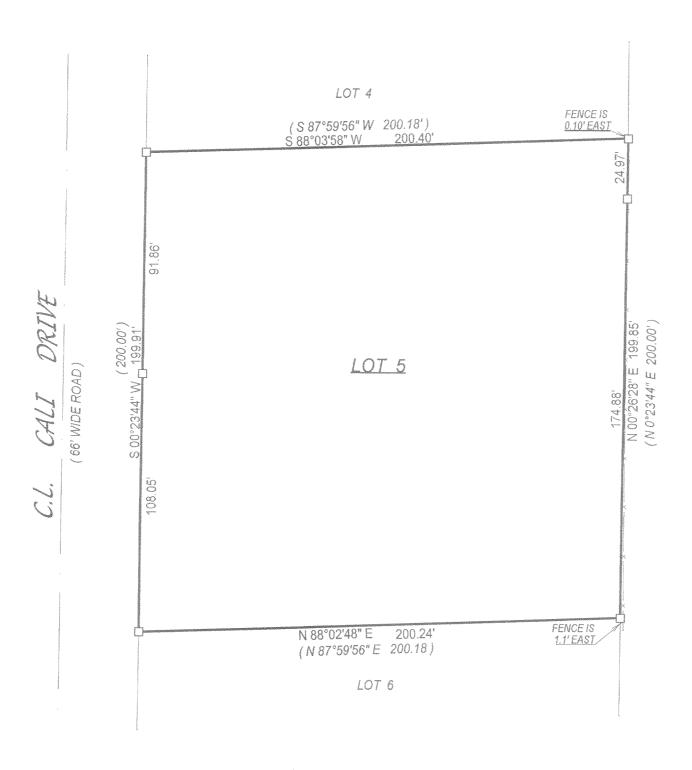

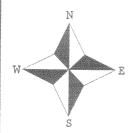

()= recorded as

= found iron bar

= found iron pipe

= set iron pipe

= set iron bar

SCALE 1" = 40'

JOB #03-617


TAX ID # HC00005

COMPARE LEGAL DESCRIPTION ABOVE AND DRAWING WITH DEED. FOR BUILDING RESTRICTIONS AND EASEMENTS NOT SHOWN, REFER TO DEED, ABSTRACT SOURCES AND LOCAL MUNICIPAL CODES. NOTIFY THE SURVEYOR IMMEDIATELY OF ANY DISCREPANCY.

\$\$\$\$

"I hereby certify that I have surveyed the above described property and that the above map is a true representation thereof and shows the size and location of all visible structures, apparent easements and encroachments

This survey is made for the present owners of the property, and those who purchase, mortgage, or guarantee the title thereto, within one year from the date hereof.

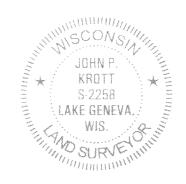

JOHN KROTT S - 2258 Wisconsin Registered Land Surveyor

(original if signed in red) DATED THIS THE 1st DAY OF OCTOBER 2003