

PLAT OF SURVEY



LEGEND

Symbol	Description
	1/2" REBAR FOUND
	2" IRON PIPE FOUND
	1" IRON PIPE FOUND
	SET 1X18" IRON PIPE @ 1.13 # PER L.F
	SWAMP LINE
	FENCE (X) LINE
	EDGE OF PAVEMENT
(100.00)	RECORDED AS BEARING OR DISTANCE

NOTE: MARSH AREA NOT SURVEYED AT THIS TIME.
AREA DRAWN FROM ORIGINAL SUBDIVISION PLAT

CURVE TABLE

CURVE #	DELTA	RADIUS	ARC	CHORD BEARING	CHORD
C1	81°15'36"	50.00'	70.91'	N23°44'12"E	65.12'
C2	60°00'00"	50.00'	52.36'	N46°53'36"E	50.00'
C3	99°54'12"	50.00'	87.18'	S53°09'19"W	76.55'

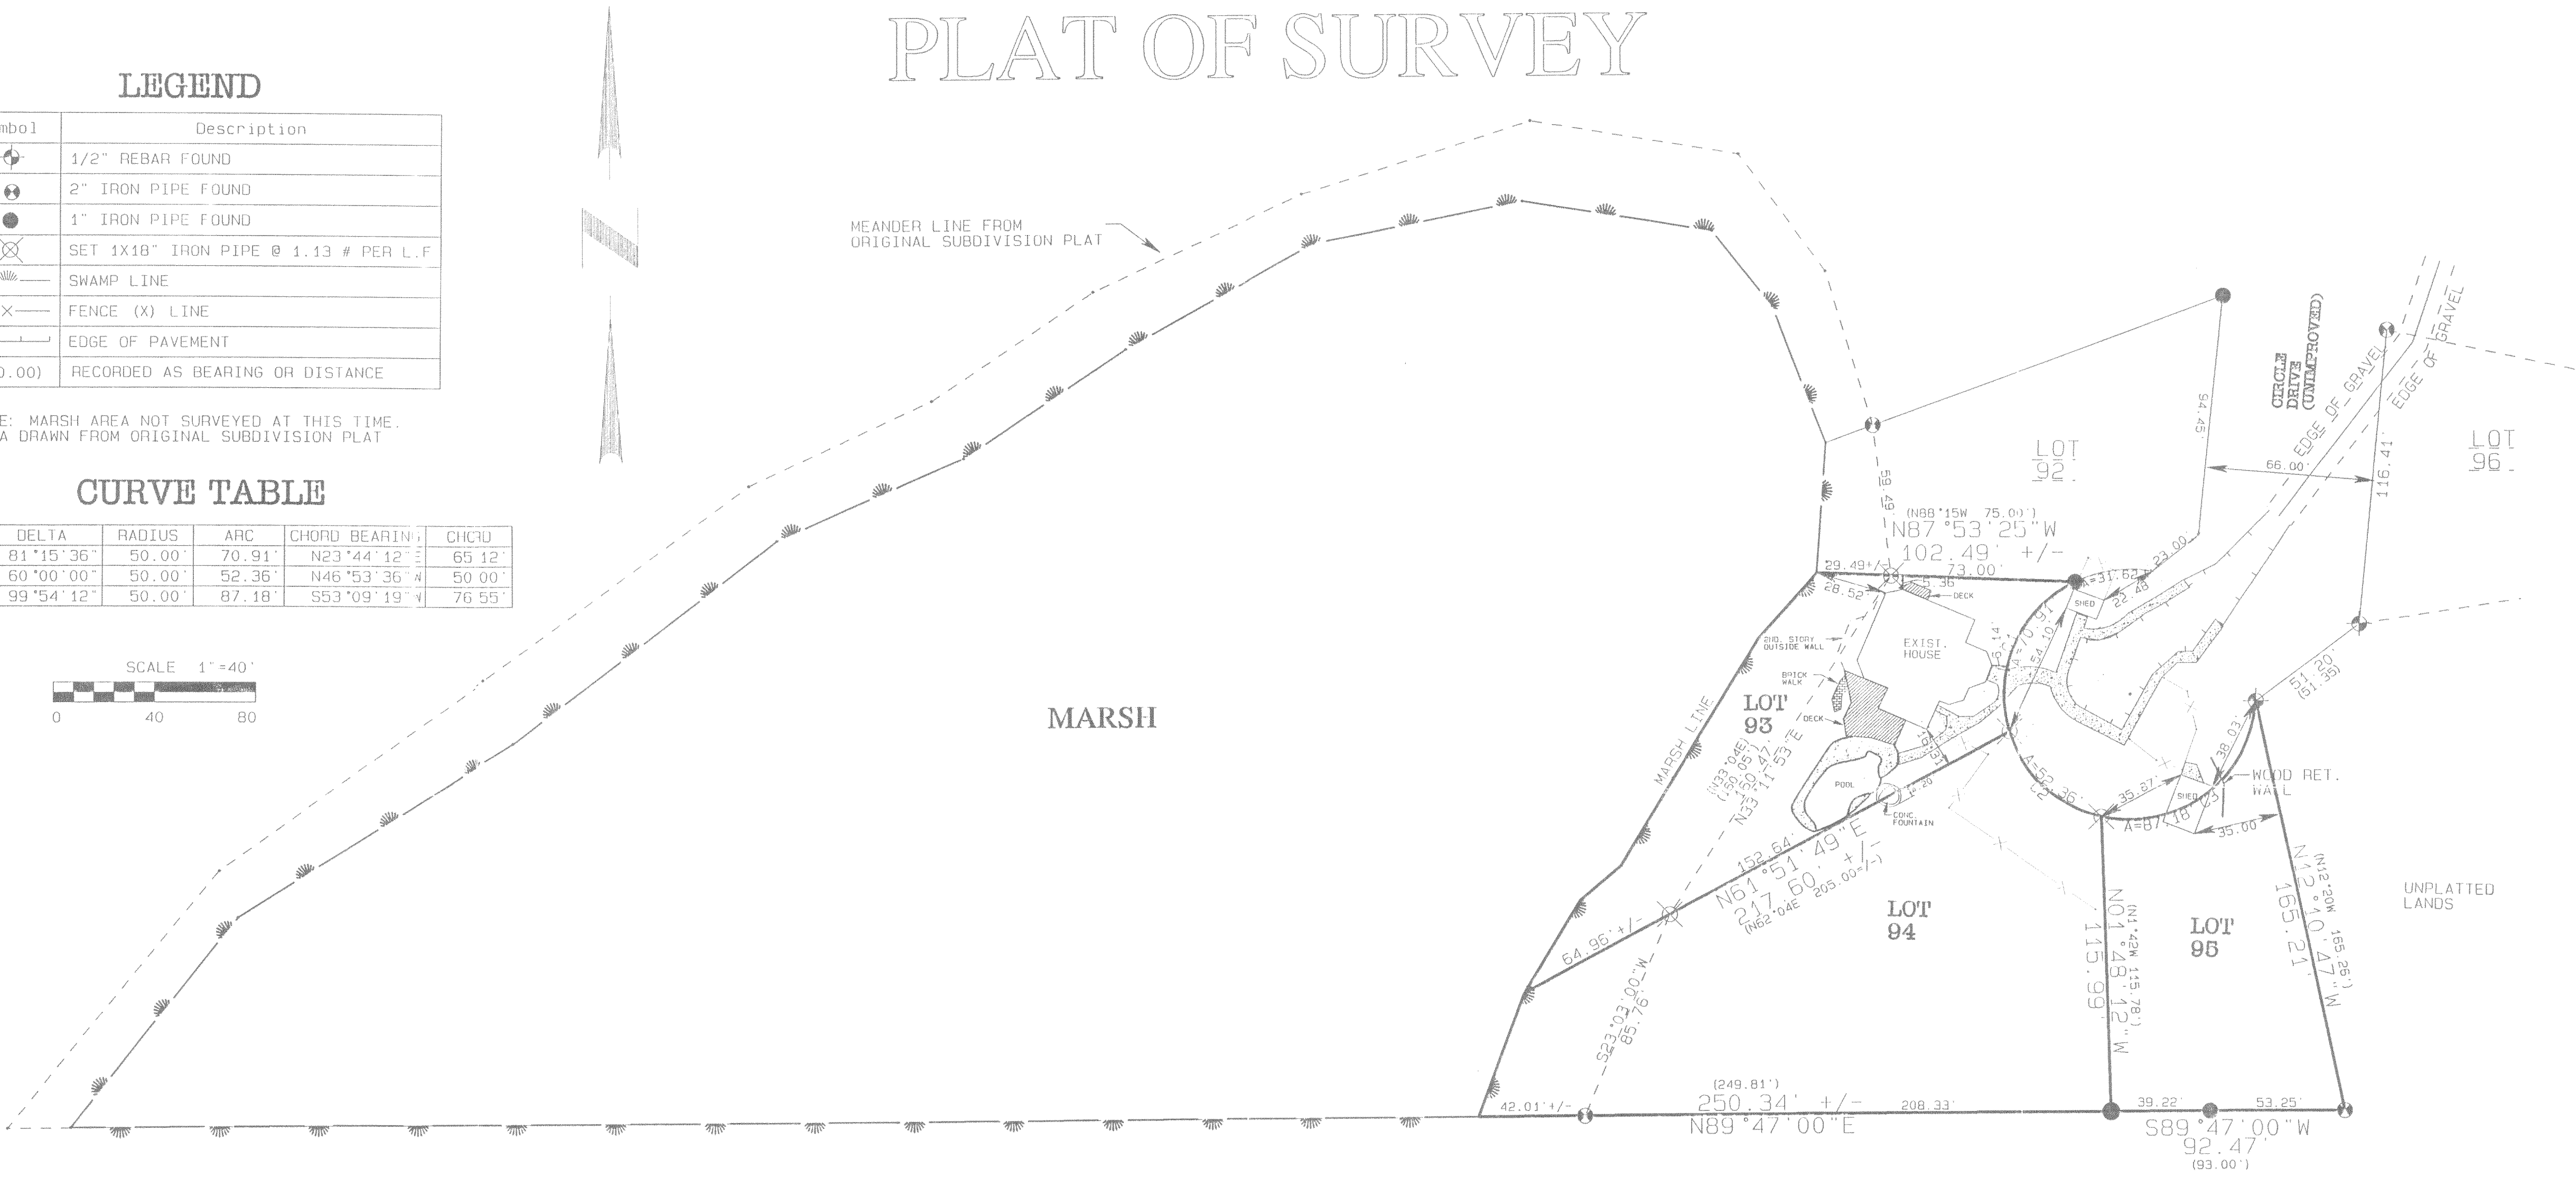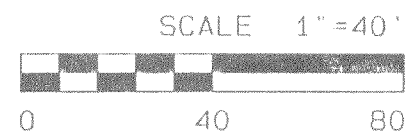

FOR: RUSSELL R. WALTON

DATE: 04/29/2003

DESCRIPTION: LOTS 93, 94, AND 95 OF BUBBLING SPRINGS SUBDIVISION, LOCATED IN THE NW 1/4 OF THE SE 1/4 AND THE NE 1/4 OF THE SE 1/4 AND THE SE 1/4 OF THE NE 1/4 OF SECTION 34, TOWN 4 NORTH, RANGE 16 EAST, WALWORTH COUNTY, WISCONSIN. ALSO, THE AREA DESIGNATED "MARSH" AND SHOWN ON SHEET 2 OF THE PLAT ENTITLED "SECOND ADDITION TO BUBBLING SPRINGS SUBDIVISION" RECORDED IN CABINET A SLIDE 128 & 129 WALWORTH COUNTY REGISTER OF DEEDS.

THE ABOVE MAP IS A TRUE REPRESENTATION THEREOF AND SHOWS THE SIZE AND LOCATION OF ALL THE PROPERTY, EXTERIOR BOUNDARIES, THE LOCATION OF ALL VISIBLE BOUNDARY FENCES, APPARENT EASEMENTS, ROADWAYS, AND VISIBLE ENCROACHMENTS, IF ANY.

THIS SURVEY IS MADE FOR THE USE OF THE PRESENT OWNERS OF THE PROPERTY, AND ALSO THOSE WHO PURCHASE, MORTGAGE OR GUARANTEE TITLE THERETO WITHIN ONE (1) YEAR FROM THE DATE HERETO.

THIS IS ORIGINAL
PRINT ONLY IF
SEAL IS UNPRINTED
& RED

BRADFORD L. SPENCER, R.L.S. #2069
RSV# RSVDATA6/BRADTDS/J03100.PRO

RSV
ENGINEERING, INC.

Engineers • Land Surveyors • Environmental Scientists
801 MAIN STREET • MILWAUKEE, WISCONSIN 53149 • (262) 363-2004

HB52-14
HB52-15
HB52-16

416-1937