

ABERNATHY and ASSOCIATES

Kenneth B. Abernathy Jr.

Wisconsin Registered Land Surveyor S-1594

W4056 BRAY RD.
ELKHORN, WI. 53121

PHONE: (262) 723-4260 (OFFICE)
(262) 723-7209 (FAX)


Email: abernathy@elknet.net

PLAT OF SURVEY

LOT 9 OF STRAWBERRY BANK PLANTATION, A
SUBDIVISION LOCATED IN SECTION 36, TOWN
4 NORTH, RANGE 16 EAST, LAGRANGE
TOWNSHIP, WALWORTH COUNTY, WISCONSIN.

OWNER: DAVID and SANDRA KEILMAN
619 ROSEDALE RD
ROSELLE, IL. 60172.

LAUDERDALE LAKES
100 YEAR FLOOD ELEV. = 886.00'
FALLS ALONG LAKE SIDE OF RTP-RAP

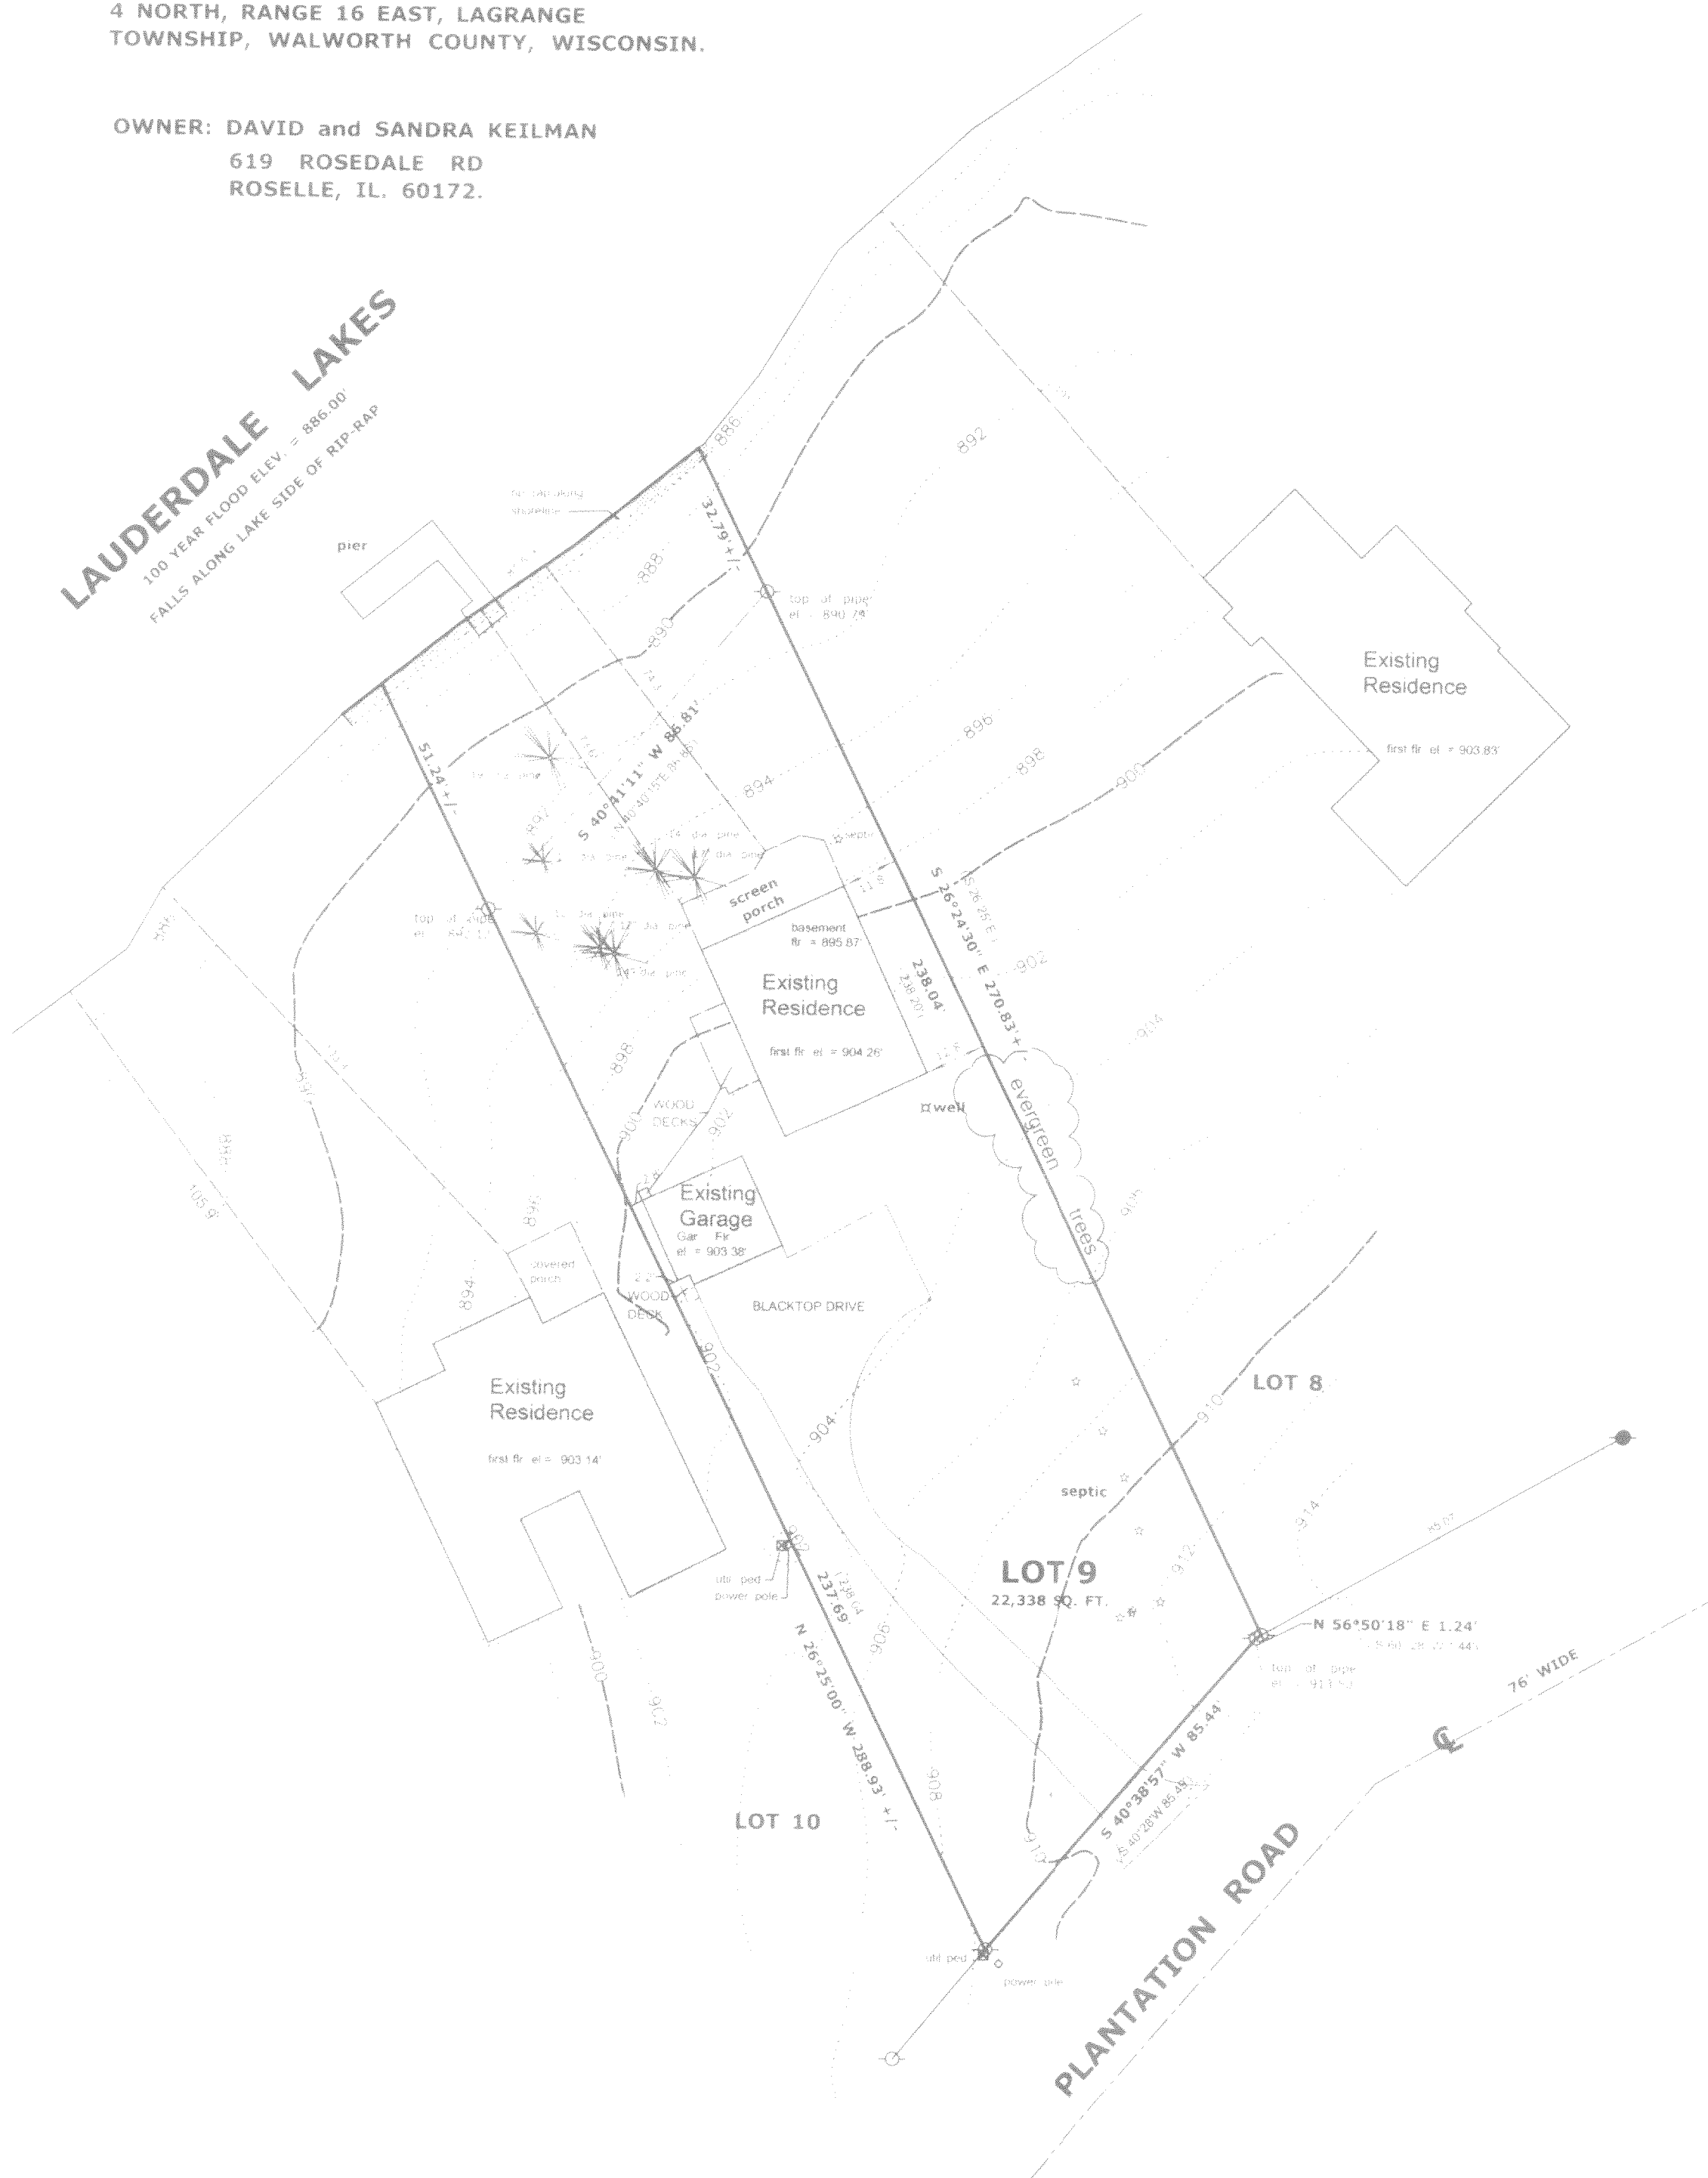

LEGEND

- FOUND IRON PIPE
- FOUND IRON ROD
- ⊗ FOUND BRASS CAPPED MONUMENT
- ⊗ FOUND CONCRETE MONUMENT
- + CHISEL CUT IN CONCRETE
- SET IRON ROD, 24" LONG, WEIGHING 1.5 LBS./LINEAL FT., 3/4" DIA.
- SET IRON ROD, 30" LONG, WEIGHING 4.5 LBS./LINEAL FT., 1-11/16" DIA.
- (x x x) RECORDED AS DIMENSION
- * * * * * EXISTING FENCE

THE "WEST" LINE OF LOT 9
WAS ASSUMED TO BEAR N 66° 25' A

SCALE: 1" = 30 FEET

"I hereby certify that the above described property has been surveyed by me or under my direction and that the above map is a true representation thereof and shows the size and location of the property, its exterior boundaries, the location of all visible structures and dimensions of all principal buildings thereon, boundary fences, apparent easements, roadways and visible encroachments, if any."

"This survey is made for the use of the present owners of the property, and also those who purchase, mortgage, or guarantee the title thereto within one year from the date hereof."

Kenneth B. Abernathy Jr.

KENNETH B. ABERNATHY, JR. S-1594
WISCONSIN REGISTERED LAND SURVEYOR

DATED DEC 15 2003 Job No. 03 1201

HSP-9

416-1974