ABERNATHY and ASSOCIATES

Kenneth B. Abernathy Jr.

W4056 BRAY RD. ELKHORN, WI. 53121

PHONE: (262) 723-4260 (OFFICE) (262) 723-7209 (FAX)

Wisconsin Registered Land Surveyor

S-1594


Email: abernathy@elknet.net

PLAT 0 F SURVEY

LOT 8, BLOCK 2, BAYVIEW MANOR, LOCATED IN TOWN 4 NORTH, RANGE 16 EAST, WALWORTH COUNTY, WISCONSIN

Ordered by: Schauder Building, Inc. 4115 North U.S. Highway 51 Janesville, Wi. 53545-9674

Client Reference: Lutz

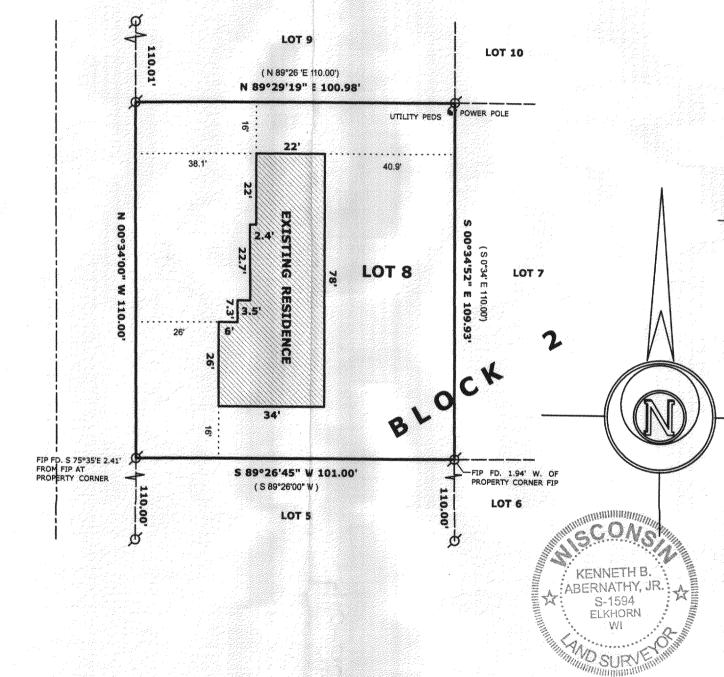

PLAT REVISED

AS BUILT RESIDENCE

LOCATED ON MAR. 4, 2004.

Legend

FOUND IRON PIPE

FOUND IRON ROD

Ø

(xx)

FOUND BRASS CAPPED MONUMENT

FOUND CONCRETE MONUMENT

CHISEL CUT IN CONCRETE

SET IRON ROD, 24" LONG, WEIGHING 1.5 LBS./LINEAL FT., 3/4" DIA.

SET IRON ROD, 30" LONG, WEIGHING 4.5 LBS./LINEAL FT., 1-11/16" DIA.

RECORDED AS DIMENSION

EXISTING FENCE

SCALE: 1" = 30 FEET

"I hereby certify that the above described property has been surveyed by me or under my direction and that the above map is a true representation thereof and shows the size and location of the property, its exterior boundaries, the location of all visible structures and dimensions of all principal buildings thereon, boundary fences, apparent easements, roadways and visible encroachments, if any." if anv."

"This survey is made for the use of the present owners of the property, and also those who purchase, mortgage, or guarantee the title thereto within one year from the date hereof."

KENNETH B. ABERNATHY, JR.

WISCONSIN REGISTERED LAND SURVEYOR, Date: Nov. 7, 2003

S-1594 Job No. 03. 1010

HB 00033