

PREPARED FOR:
ANDY SZYMANSKYJ
KEEFE REAL ESTATE
980-A N. WISCONSIN ST.
ELKHORN, WI 53121


PLAT OF SURVEY

-OF-

LOT 61 1ST ADDITION TO BUBBLING SPRINGS SUBDIVISION, LOCATED IN
TOWN 4 NORTH, RANGE 16 EAST, IN THE TOWN OF LAGRANGE, WALWORTH
COUNTY, WISCONSIN.

J.K. SURVEYING INC.
N3705 WILLOWBEND LANE
LAKE GENEVA, WI 53147
(262) 248-3697

RIDGE ROAD
(66' WIDE)

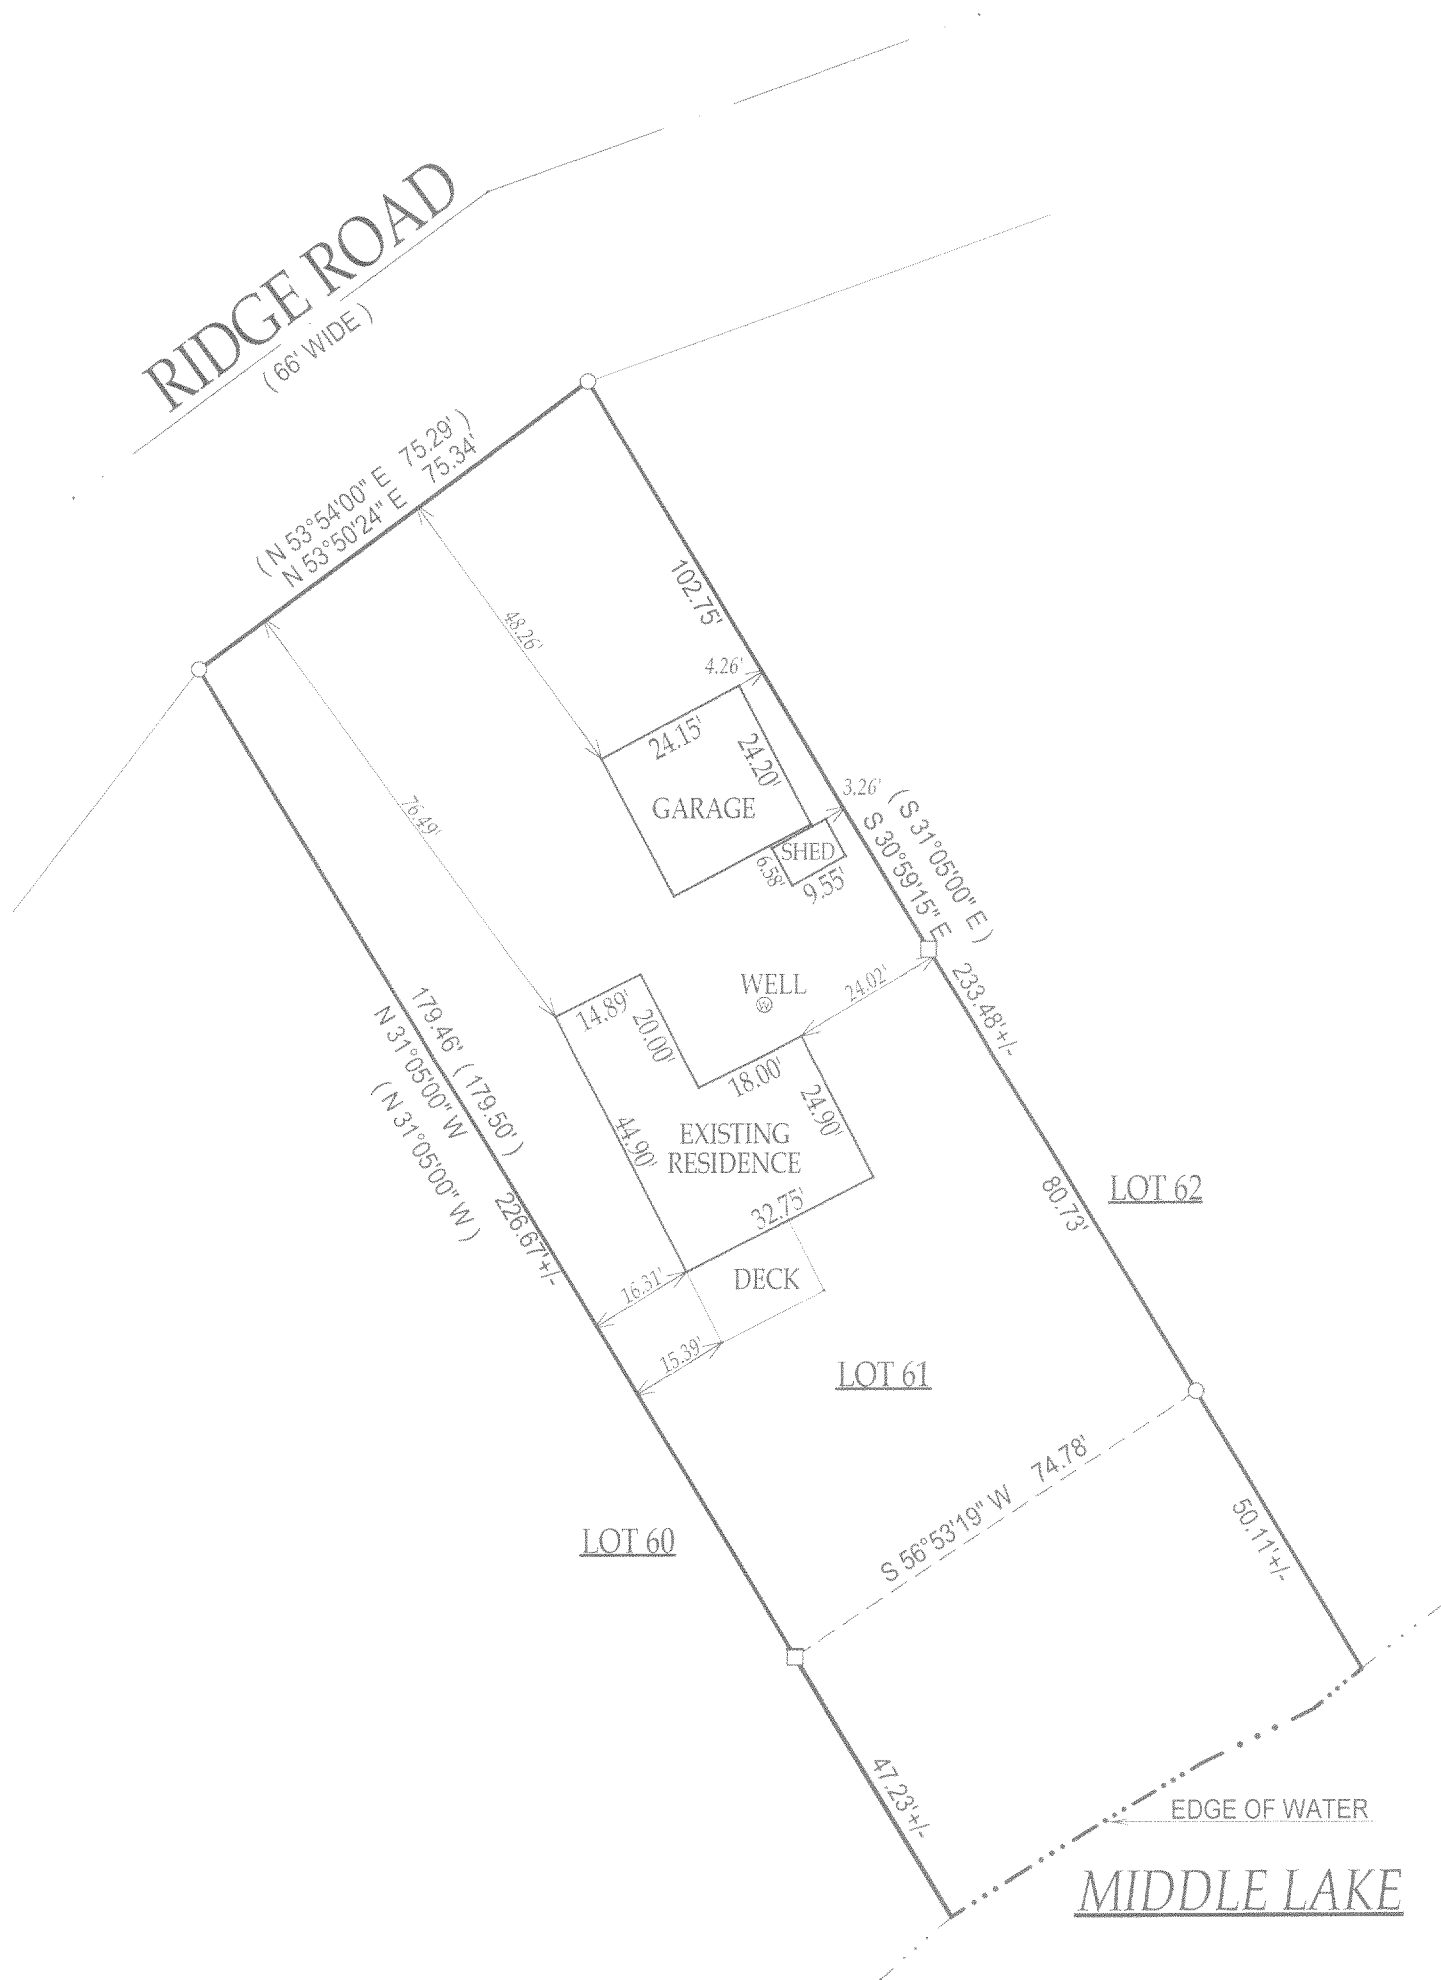

() = RECORDED AS

□ = FOUND IRON BAR

○ = FOUND IRON PIPE

● = SET IRON PIPE

■ = SET IRON BAR

SCALE: 1" = 30'


JOB #: 05-121

TAX ID #: HBS1 00030

NOTE: BASIS OF BEARING IS RECORD PLAT.

COMPARE LEGAL DESCRIPTION ABOVE AND DRAWING WITH DEED. FOR BUILDING RESTRICTIONS AND
EASEMENTS NOT SHOWN REFER TO DEED, ABSTRACT SOURCES AND LOCAL MUNICIPAL CODES. NOTIFY
THE SURVEYOR IMMEDIATELY OF ANY DISCREPANCY.

"I hereby certify that the above described property was surveyed under my
supervision and that the above map, to the best of my knowledge and
belief, is a true representation thereof and shows the size and location of all
visible structures, apparent easements and encroachments if any."
This survey is made for the present owners of the property, and those who
purchase, mortgage, or guarantee the title thereto, within one year from
the date hereof.

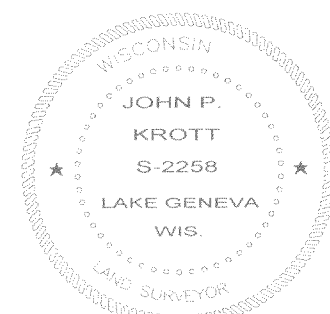

JOHN KROTT S - 2258
Wisconsin Registered Land Surveyor
(original if signed in red)

DATED THIS 18th DAY OF MARCH, 2005