


PREPARED FOR
RON AMANN
R.J. AMANN BUILDERS
P.O. BOX 643
LAKE GENEVA, WI
53147

PLAT OF SURVEY

- OF -

J.K. SURVEYING INC.
N705 WILLOWBEND LANE
LAKE GENEVA, WI 53147
262-248-5697

LOTS 7 AND 8, BLOCK 1, GREEN LAKE PARK SUBDIVISION, LOCATED IN GOVERNMENT LOT 5, SECTION 25, TOWN 4 NORTH, RANGE 16 EAST, WALWORTH COUNTY, WISCONSIN, EXCEPT BEGIN AT THE SOUTHWESTERLY CORNER OF SAID LOT 8; THENCE N 51°45' E 127.56 FEET MORE OR LESS, ALONG THE WEST LINE OF LOT 8 TO THE SHORE OF GREEN LAKE; THENCE SOUTHEASTERLY ALONG THE SHORE 25.00 FEET MORE OR LESS TO A POINT; THENCE S 52°32'48" W 120.6 FEET MORE OR LESS TO THE PUBLIC ROAD; THENCE N 67°00' W 25 FEET TO THE POINT OF BEGINNING.

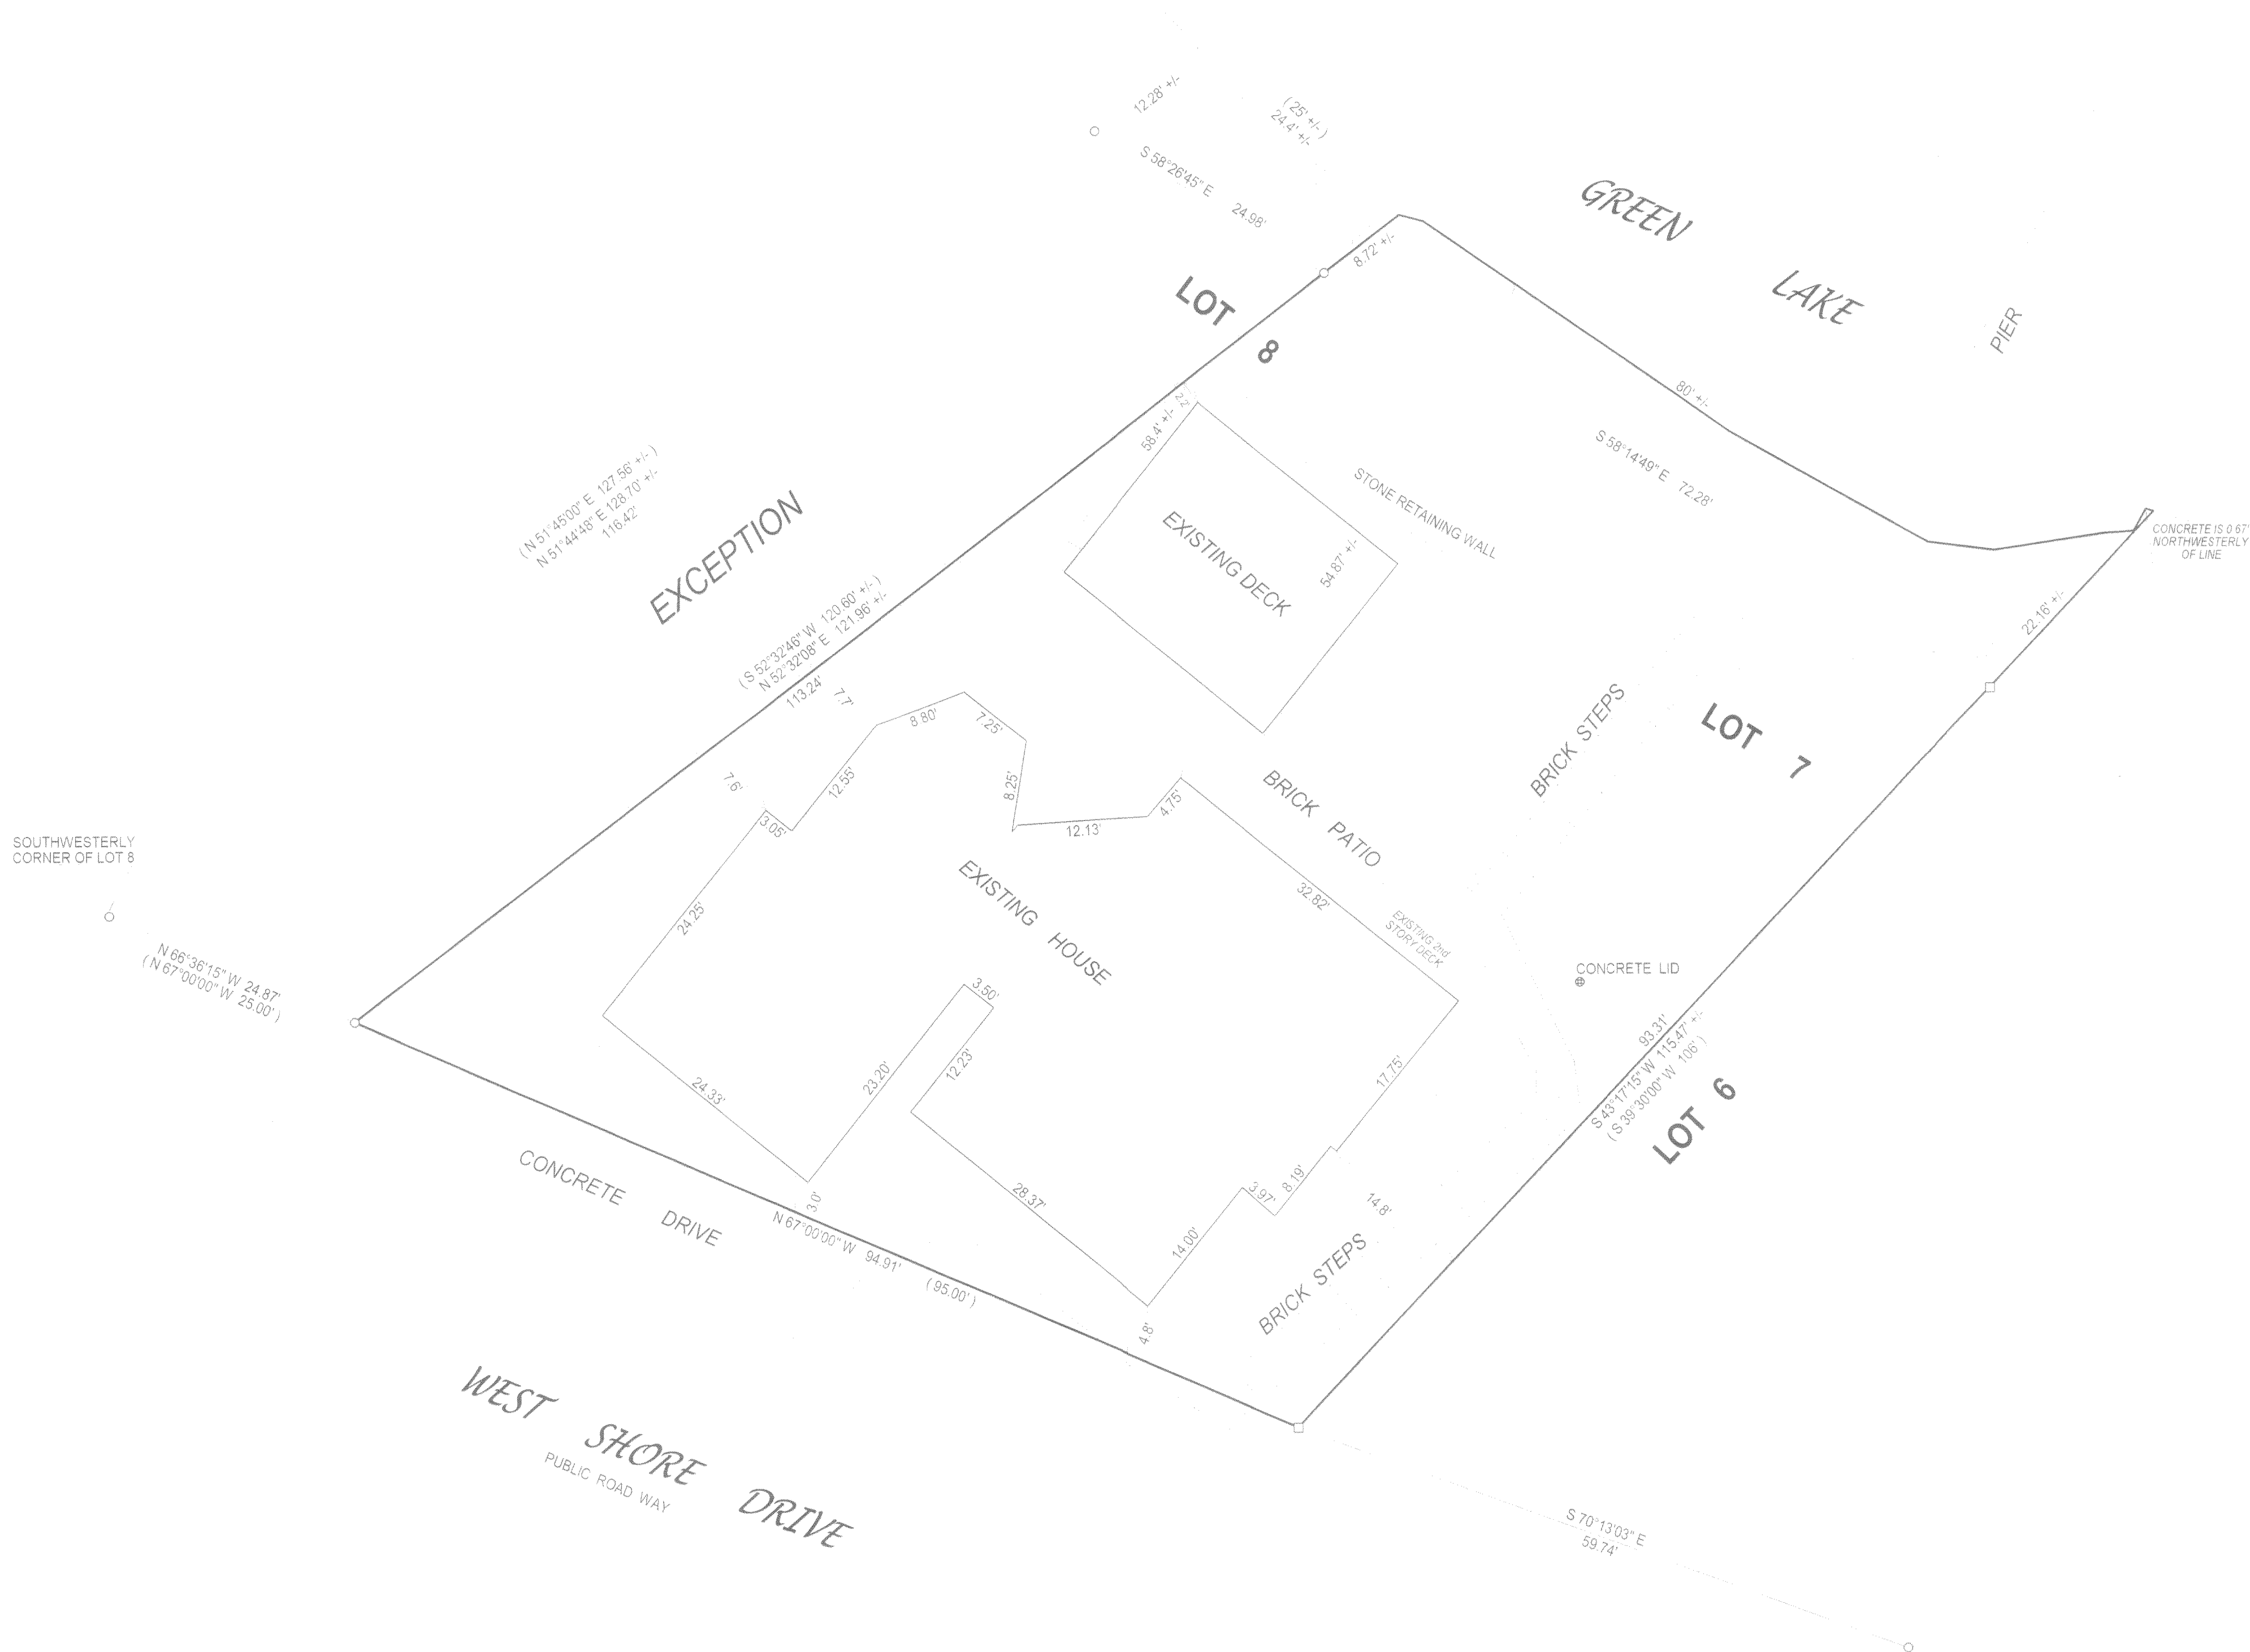


() = recorded as
= found iron bar
= found iron pipe
● = set iron pipe
■ = set iron bar

SCALE 1" = 10'

JOB # 04-484AB


TAX ID # HGP00007

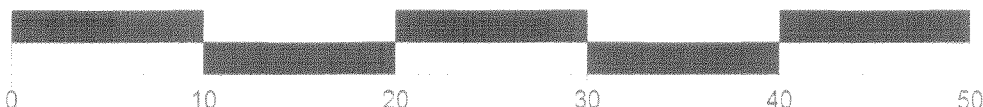

COMPARE LEGAL DESCRIPTION ABOVE AND DRAWING WITH DEED, IF NO BUILDING RESTRICTIONS AND EASEMENTS NOT SHOWN, REFER TO DEED ABSTRACT SOURCES AND LOCAL MUNICIPAL CODES. NOTIFY THE SURVEYOR IMMEDIATELY OF ANY DISCREPANCY.

"I hereby certify that I have surveyed the above described property and that the above map, to the best of my knowledge and belief, is a true representation thereof and shows the size and location of all visible structures, apparent easements and encroachments if any."
This survey is made for the present owners of the property, and those who purchase, mortgage, or guarantee the title thereto within one year from the date hereof.

2005

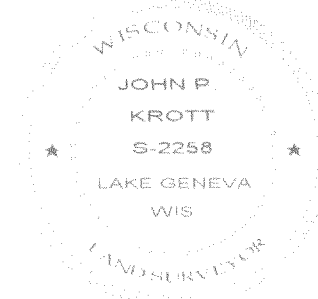

JOHN KROTT S-2258
Wisconsin Registered Land Surveyor
(original if signed in red)
DATED THIS 10th DAY OF SEPTEMBER 2004.
DATE OF LAST REVISION 03-02-04

10-2117