

Plat of Survey


of

Lot 73 of the 1st Addition to
Bubbling Springs Subdivision

located in the Northwest 1/4 and the Southwest 1/4 of
Section 35, Town 4 North, Range 16 East, Town of
LaGrange, Walworth County, Wisconsin.

Surveyed for: **David & Patricia Rehm**
227 Wimbledon Place
Bloomington, Illinois. 60108

Survey Date: June 1, 2005.
Revisions:



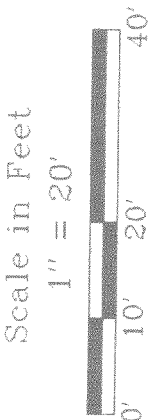


Jensen & Olson Land Surveying, LLC
45 South Wisconsin Street
Elkhorn, Wisconsin 53121
Telephone (262) 723-3434
Facsimile (262) 723-8044

Legend
Found County Section Corner
Found Iron Pipe
Set Iron Rod 3/4" dia
Recorded Information
Utility Pole
Septic Vent
Asphalt Surface

Sheet 1 of 1 Sheets
Job Reference Number
2004.210

2004.210

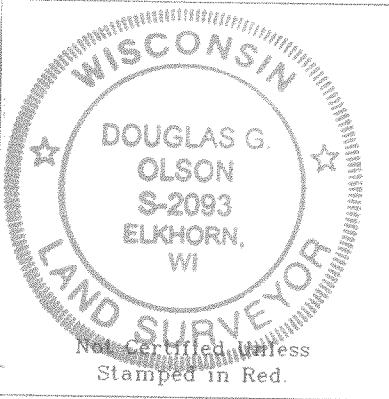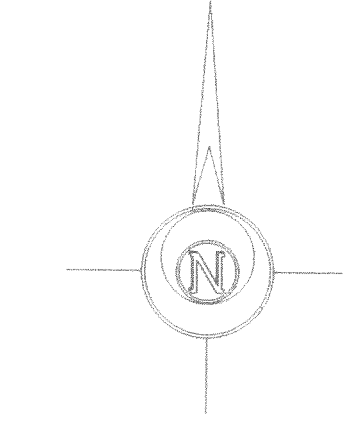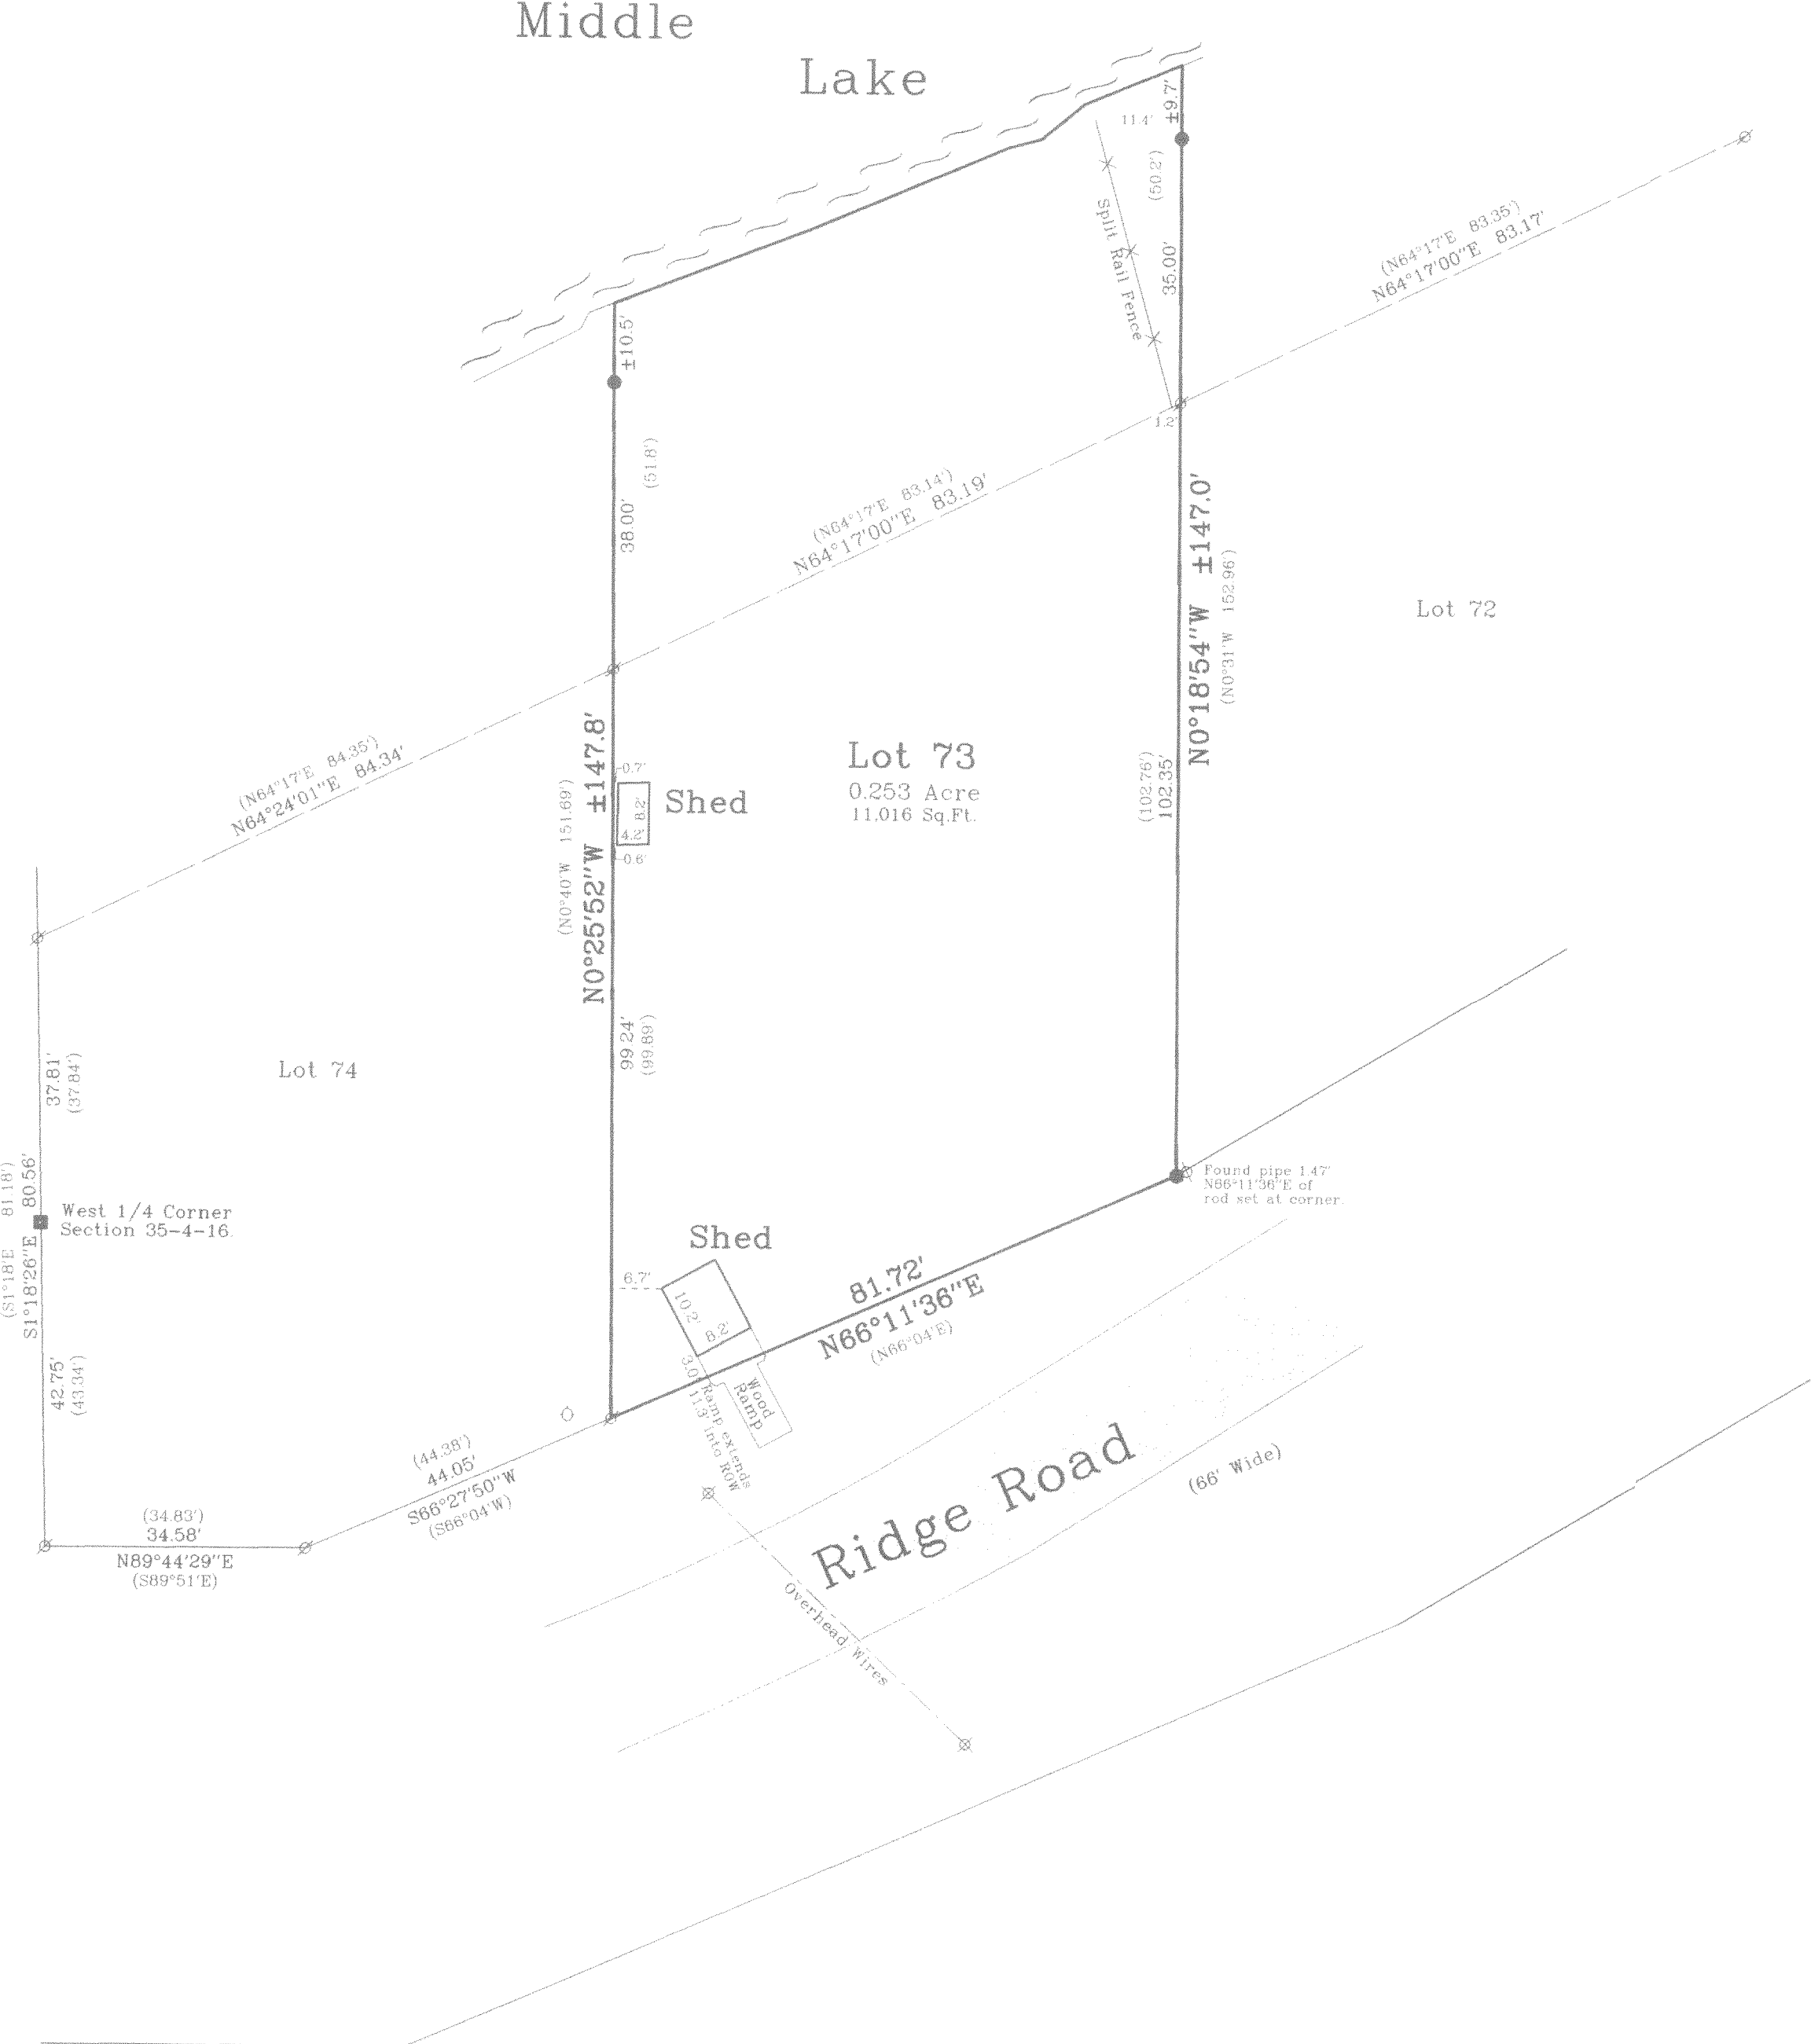

Notes: 1) This survey plat is not certified unless signed and sealed in red ink.
2) This survey is subject to Wisconsin lien laws. This Plat of Survey is the notice of intent to file lien. Lien waiver required.

Copyright © 2005 by Jensen & Olson Land Surveying, LLC.
All rights reserved. No part of this survey plat may be reproduced or transmitted in any form by any means - graphic, electronic, or mechanical, including photocopying, tracing, or information storage and retrieval systems - without permission in writing from Douglas G. Olson, Jensen & Olson Land Surveying, LLC.

I, Douglas G. Olson, Wisconsin Registered Land Surveyor, do hereby certify that this survey was performed by me or under my direction in full compliance with the owner's/agent's instructions and Chapter A-E 7 of the Wisconsin Administrative Code "Minimum Standards for Property Surveys", and that this map is an accurate representation thereof to the best of my knowledge and belief.

Douglas G. Olson
Wisconsin Registered Land Surveyor - 2093