
## ABELL

## SURVEYING & MAPPING

DELAVAN, WISCONSIN 53115 414-728-6737

## PLAT OF SURVEY OF

LOT 25 OF MARINER HILLS SUBDIVISION, LOCATED IN TOWN 4 NORTH, RANGE 16 EAST, WALWORTH COUNTY, WI.

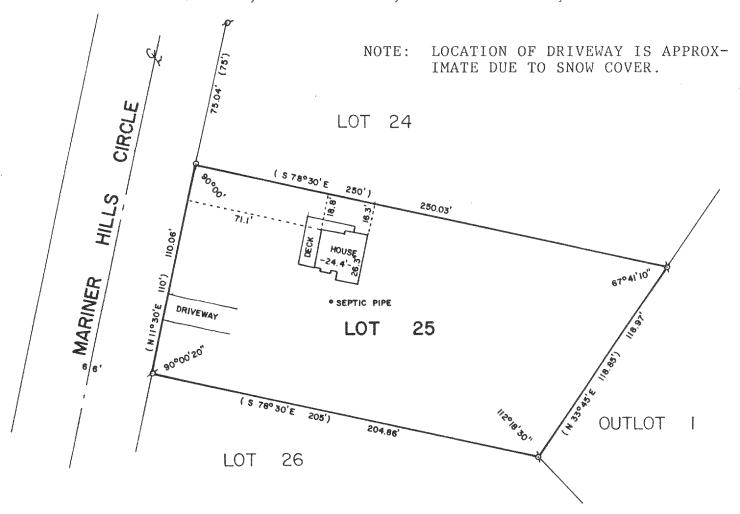

ORDERED BY:

ANCHOR SAVINGS & LOAN

500 E. WALWORTH

DELAVAN, WI. 53115

OWNER: GERALD W. KRAFT





SCALE

- 1"=50'

LEGEND

ø − IRON ROD FOUND
ø − IRON ROD SET

( )- RECORDED AS

I, DAVID F. ABELL, DO HEREBY CERTIFY THAT I HAVE SURVEYED THE PROPERTY HEREON DESCRIBED ACCORDING TO THE OFFICIAL RECORDS AND THAT THE PLAT HEREON IS A CORRECT REPRESENTATION OF THE PROPERTY LINES TO THE BEST OF MY KNOWLEDGE AND BELIEF.

DAVID F. ABELL

WISCONSIN REGISTERED LAND SURVEYOR, S-1596

DATE

JOB NUMBER - 88005 NOTE: THIS IS NOT A CERTIFIED COPY UNLESS SEALED.