


of

Lot 12 in Block 2 of Carswell's Park Subdivision, Town of LaGrange, Walworth County, Wisconsin. Also a part of Block 4 of Carswell's Park Subdivision, which subdivision is located in Section 35 and 36 T4N, R16E Walworth County, Wisconsin described as follows, to-wit: Commencing at the Northwest corner of Lot 19 in Block 3 of said subdivision; thence North 5° 0' West on a prolongation of the West line of said Lot 19, 19.8 feet to a point; thence North 85° 57' West 143.2 feet; thence North 2° 37' West 351.7 feet; thence South 88° 48' East 290.70 feet to the point of beginning which is the Northwest corner of premises sold to Melvin C. Schultz et ux by deed recorded in Vol. 486 of Deeds page 137; thence South 10° 58' East along the West line of said Schultz parcel 120 feet; thence North 88° 48' West 125 feet to a point; thence North 10° 58' West 120 feet to a point; thence South 88° 48' East 125 feet to the place of beginning.

Tax Key No. HCA 00056

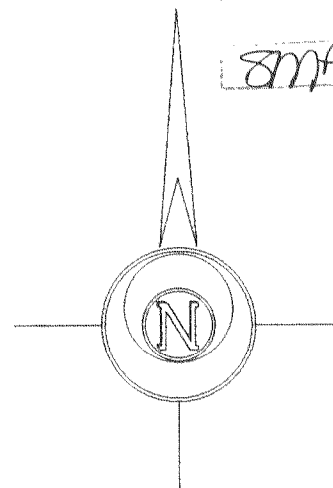


Bearings referenced to previous surveys.

Surveyed for:

Century 21 Pagliarini Group, Inc.

252 Center Street
Lake Geneva, Wisconsin. 53147

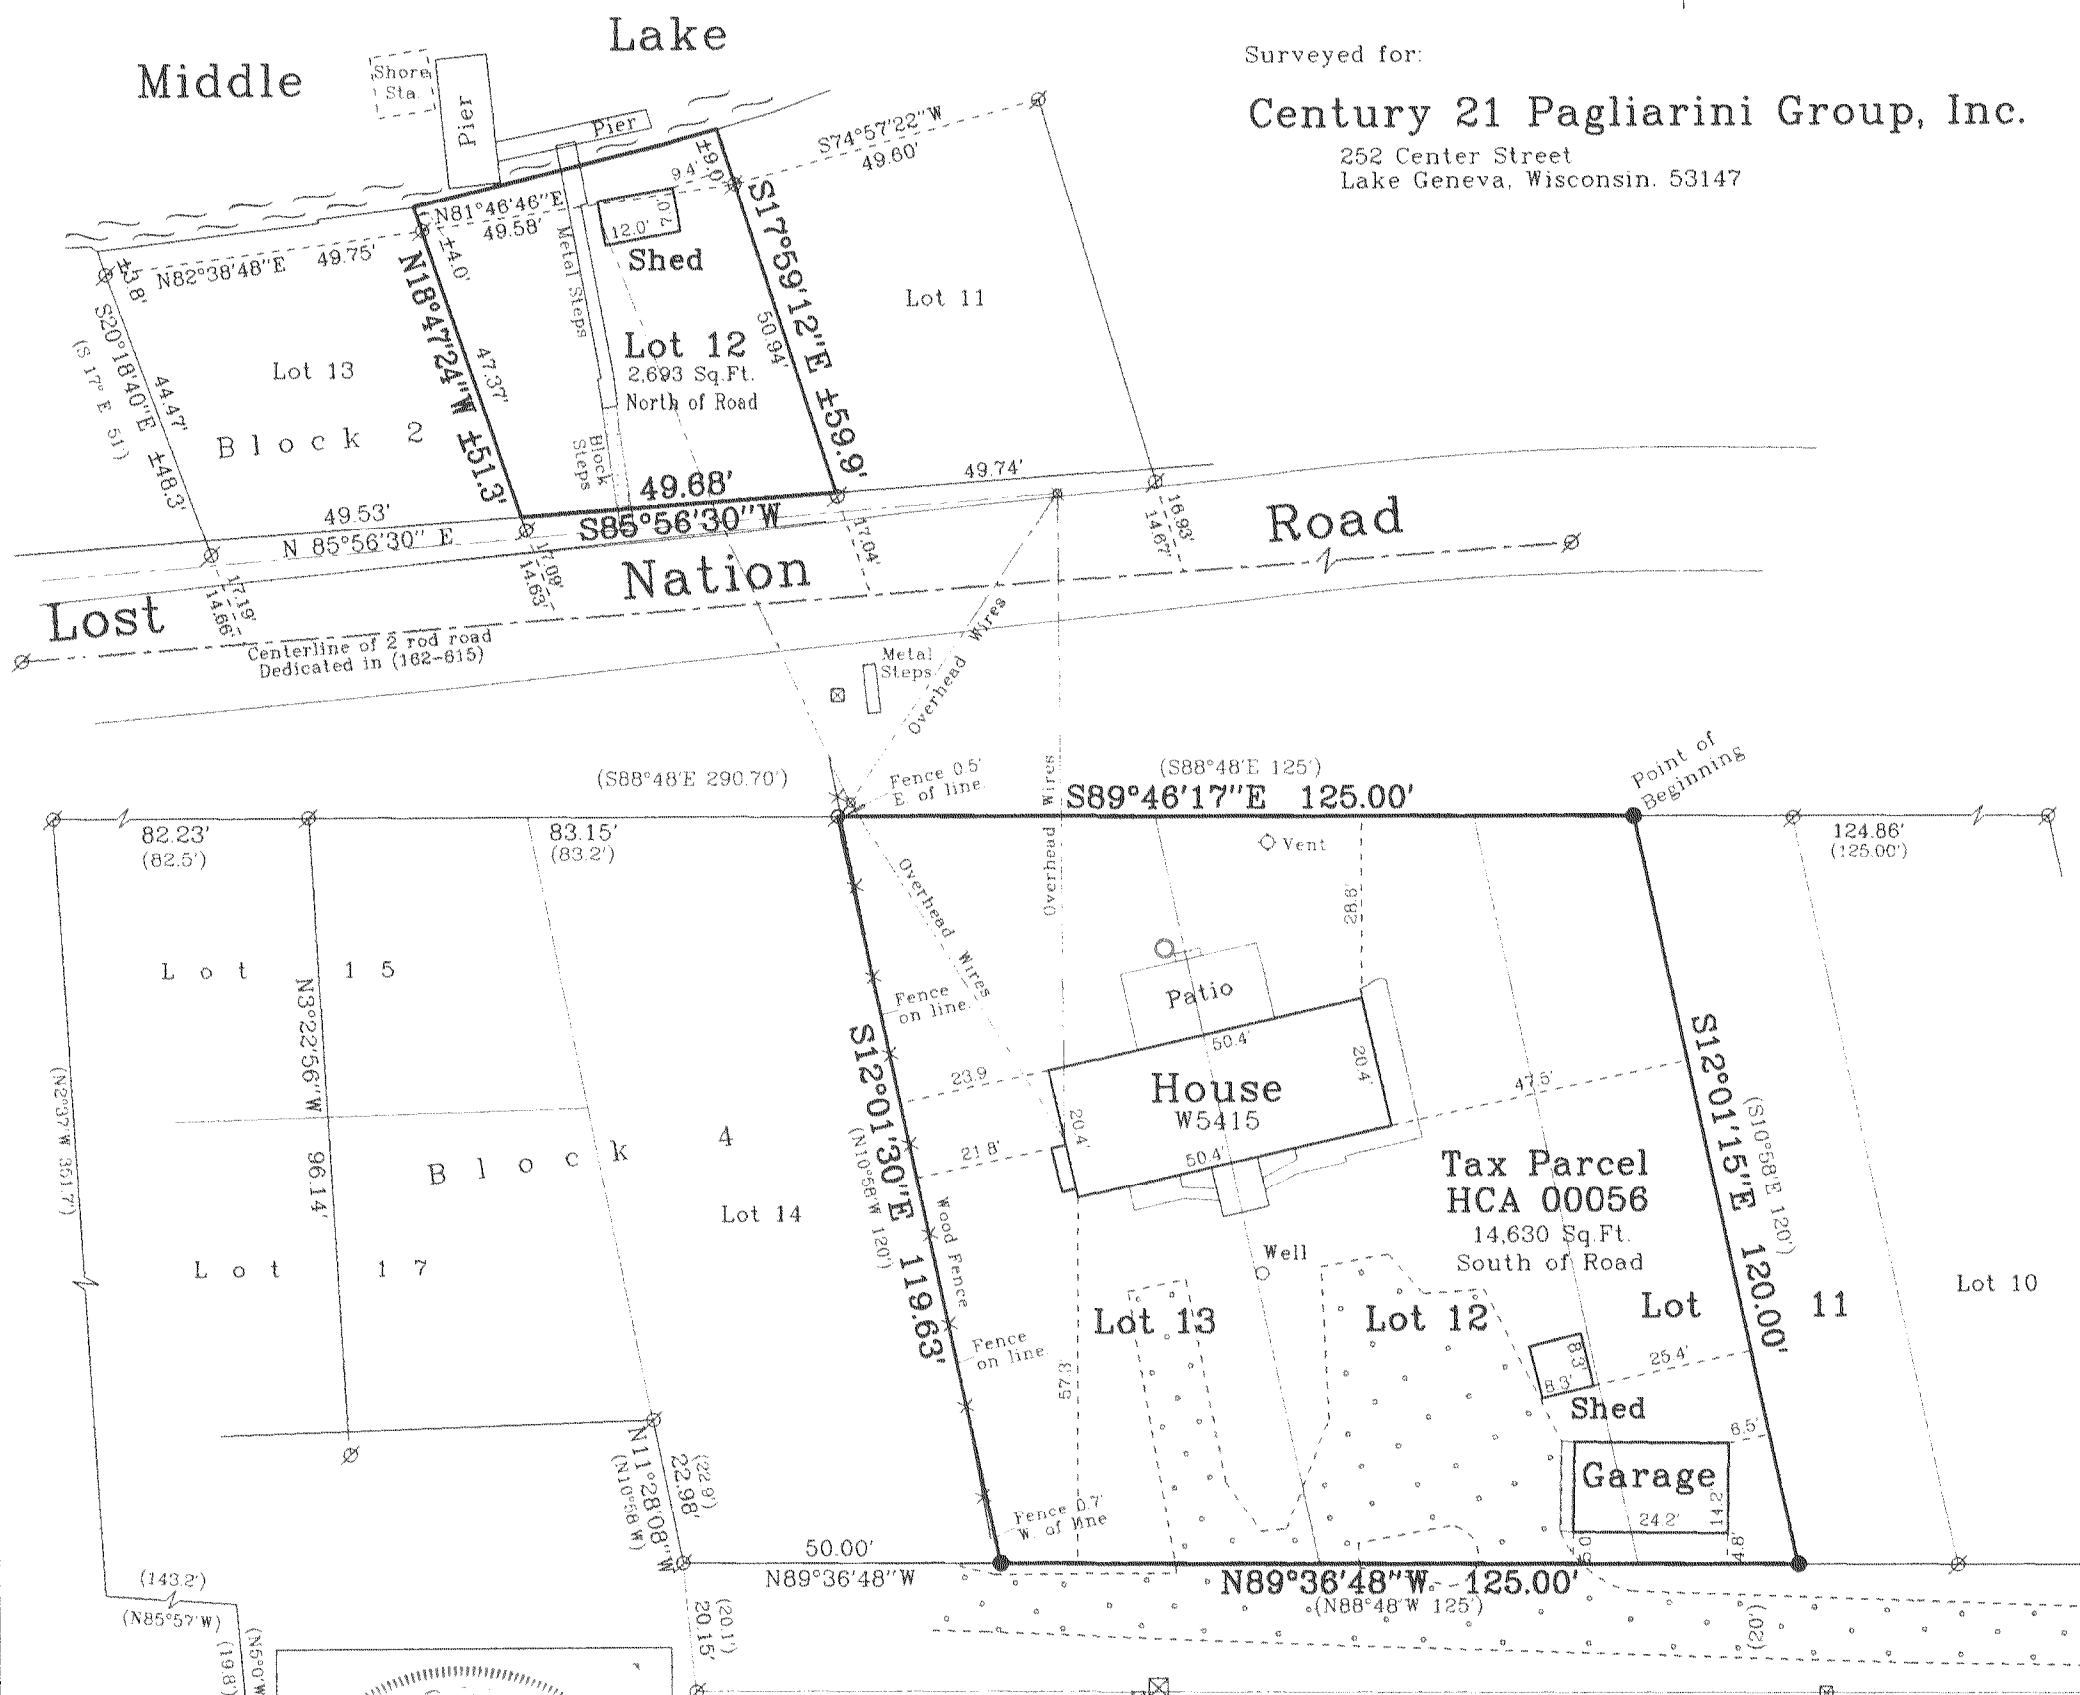

Copyright c 2006 by Jensen & Olson Land Surveying, LLC.

All rights reserved. No part of this survey plat may be reproduced or transmitted in any form by any means - graphic, electronic, or mechanical, including photocopying, tracing, or information storage and retrieval systems - without permission in writing from Douglas G. Olson, Jensen & Olson Land Surveying, LLC.

I hereby certify that I have surveyed the above described property and the map hereon is correct to the best of my professional knowledge and belief and shows the size and location of the property, its exterior boundaries, the location and dimensions of all visible structures thereon, boundary fences, apparent easements and roadways and visible encroachments, if any.

This survey is made for the exclusive use of the present owners of property, and also those who purchase, mortgage or guarantee title thereto, within one year from the date hereof.

Douglas G. Olson
Wisconsin Registered Land Surveyor - 2093

Notes:

- 1) This survey plat is not certified unless signed and sealed in red ink.
- 2) This survey is subject to Wisconsin lien laws. This Plat of Survey is the notice of intent to file lien. Lien waiver required.

Survey date: May 18, 2006.

Revisions:

Sheet 1 of 1 Sheets.

Job Reference Number:

2006.058

Legend

- Ø Found Iron Pipe
 ● Found Iron Rod
 () Recorded Information
 ✕ Utility Pole
 ⊠ Utility Pedestal
 ○ Septic Cover
 _____ Asphalt Surface
 _____ Gravel Surface
 _____ Concrete Surface

Jensen & Olson Land Surveying, LLC

45 South Wisconsin Street P.O. Box 322

Elkhorn, Wisconsin. 53121

Facsimile: (262) 723-8044

Scale: 1" = 30'



HCA - 50

416-2242