


PLAT OF SURVEY
TOPOGRAPHICAL MAPPING

LOTS 9 AND 9A OF ARROWHEAD PARK
LOCATED IN PART OF THE NORTHWEST 1/4 OF THE SOUTHEAST 1/4 OF SECTION 35,
TOWN 1 NORTH, RANGE 16 EAST, WALWORTH COUNTY, WISCONSIN

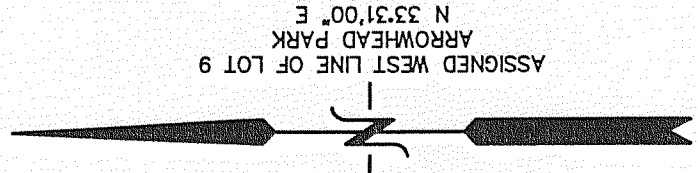


TOTAL AREA
15,266 S.F.
0.35 AC.


LEGEND
O = FOUND IRON PIPE STAKE
[XXX] = RECORDED AS

LEGEND
O = FOUND IRON PIPE STAKE
● = FOUND IRON REBAR STAKE
(XXX) = RECORDED AS
ALL RETAINING WALLS ARE WOOD

NOTE: COPIES OF THIS MAP TO WHICH THE FOLLOWING CERTIFICATE
WILL APPLY SHOW THE SURVEYOR'S ORIGINAL SEAL AND SIGNATURE
WHICH DO NOT REPRESENT THE SURVEYOR'S MARKING OPERATIONS
I HEREBY CERTIFY THAT THE ABOVE DESCRIBED PROPERTY HAS BEEN
SURVEYED UNDER MY DIRECTION AND THAT THE ABOVE MAP IS A TRUE
AND CORRECT REPRESENTATION OF THE PROPERTY AND ITS EXTERIOR BOUNDARIES. THIS SURVEY IS
ALSO THE PROPERTY OF THE SURVEYOR AND THE SURVEYOR'S OFFICE, AND
IT IS NOT TO BE REPRODUCED OR USED FOR ANY OTHER PURPOSE
WITHOUT THE WRITTEN CONSENT OF THE SURVEYOR.
DATED: JANUARY 30, 2007

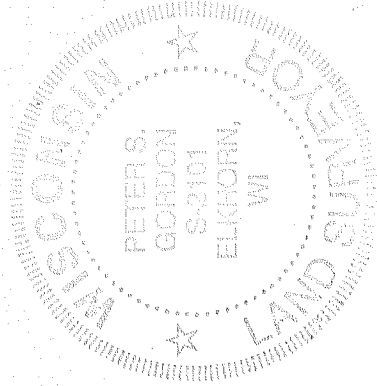

PETER S. GORDON
REGISTERED LAND SURVEYOR
WISCONSIN
DATE: 01/30/2007
SHEET NO. 1 OF 1

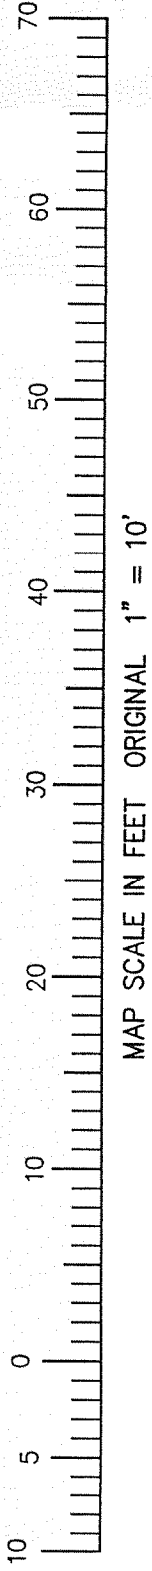

HAP-13 HAP-14

416-2858