


PLAT OF SURVEY
& TOPOGRAPHIC MAPPING

THE WESTERLY 1/2 OF LOT 8 AND ALL OF LOT 9 IN THE PLAT OF MORRIS PARK, A SUBDIVISION LOCATED IN THE SW 1/4 OF SECTION 26, TOWN 4 NORTH, RANGE 16 EAST, WALWORTH COUNTY, WISCONSIN

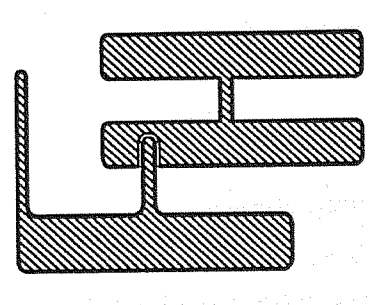


PLAT OF SURVEY
TOPOGRAPHIC MAPPING

— WORK ORDERED BY —
THELEN TOTAL CONSTRUCTION
P.O. BOX 17
ELKHORN, WI. 53121

FARRIS, HANSEN & ASSOCIATES, INC.
ENGINEERING — ARCHITECTURE — SURVEYING
7 RIDGWAY COURT P.O. BOX 437
ELKHORN, WISCONSIN 53121
OFFICE: (262) 723-2098 FAX: (262) 723-5886

REVISIONS
09/17/2005 INITIAL
09-13-2005
ADD REVISED SHORELINE
10-13-2005
ADD REVISED TPOD AT
SHORE AND 100-YEAR
FLOOD INSURANCE RATE
MAP
10-16-2007-40
TO SHOW SIZE AND
LOCATION OF PROPOSED
RESIDENCE

PROJECT NO.
6383
DATE
09/25/2003
SHEET NO.
1 OF 1

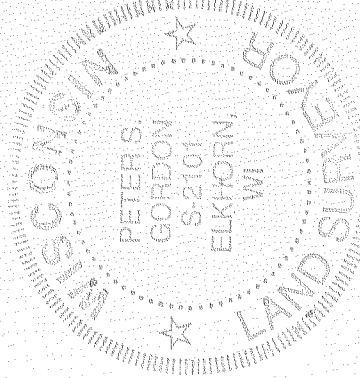

NOTE: COPIES OF THIS MAP TO WHICH THE FOLLOWING CERTIFICATE WILL APPLY SHOW THE SURVEYOR'S ORIGINAL SEAL AND SIGNATURE WHICH DO NOT REPRESENT THE SURVEYOR'S WORK PROVIDED I HEREBY CERTIFY THAT THE ABOVE DESCRIBED PROPERTY HAS BEEN SURVEYED UNDER MY DIRECTION AND THAT THE ABOVE MAP IS A TRUE REPRESENTATION THEREOF AND SHOWS THE SIZE AND LOCATION OF THE PROPERTY AND THE LOCATION OF THE SURVEYED POINTS AND THE TITLE THEREON WITHIN ONE YEAR FROM THE DATE HEREOF

DATED: 9-25-2003
TO AND AS BUILT FOUNDATION, WALLS, AND SLAB ON SHORE

PETER S. GORDON R.L.S. 2101

HMP-6