


SOUTH LINE OF LOT 10
INGLESIDE POINT ASSUMED
N 75°00'00" W

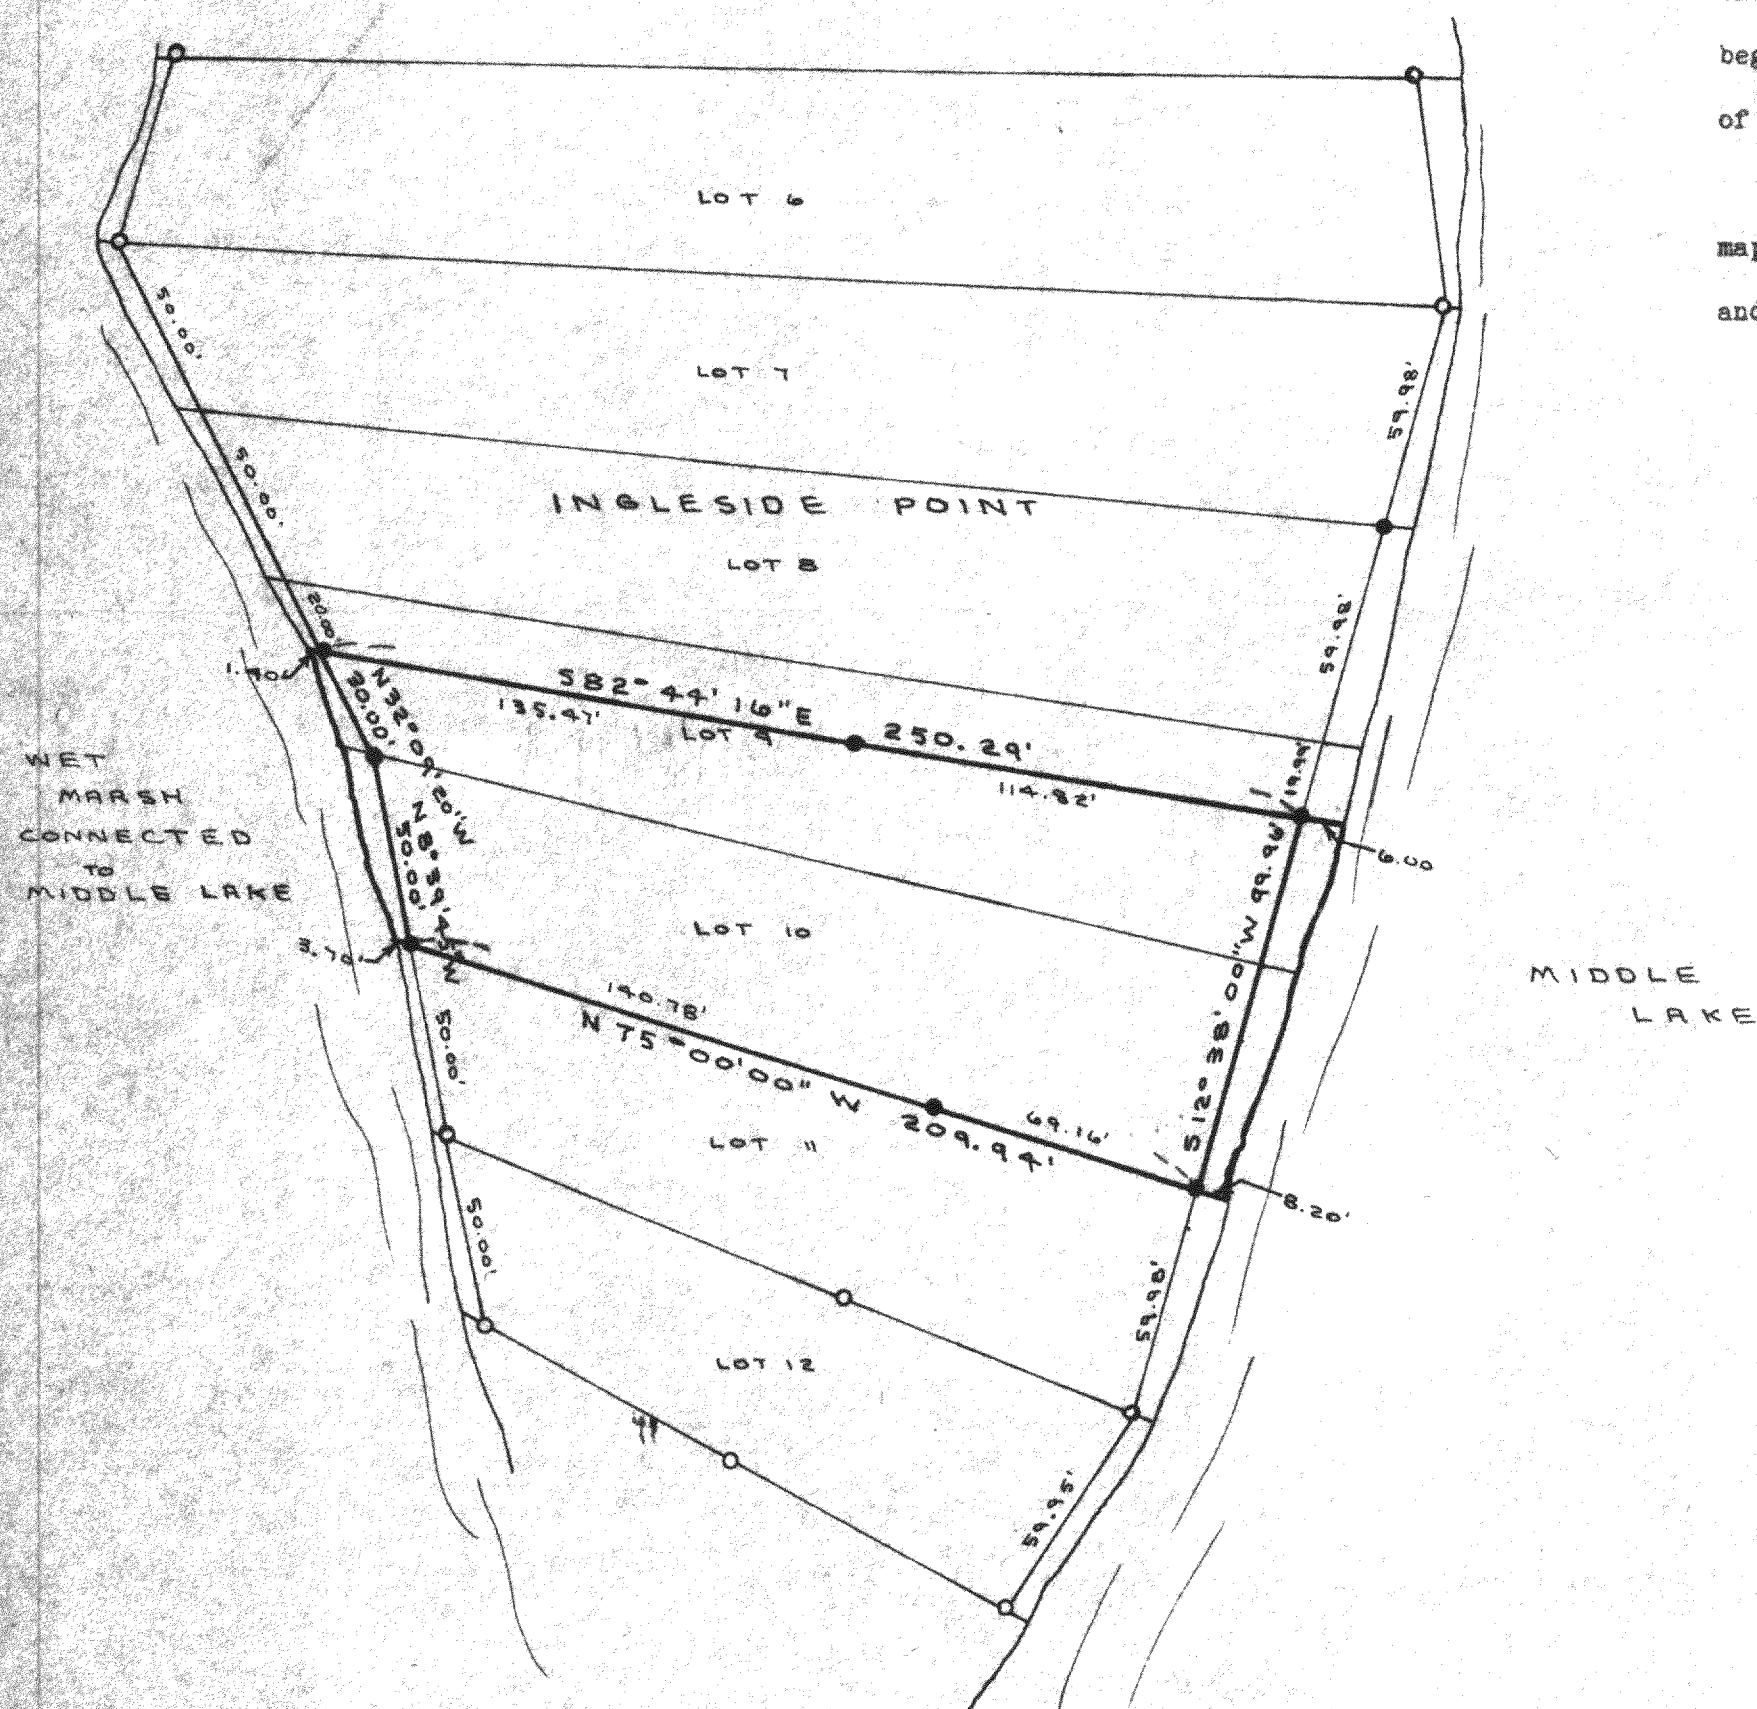

LEGEND
● SET IRON ROD 3/4" DI. X 30" LONG
○ FOUND IRON PIPE 1" O. DI.

SCALE 1" = 50'

HIP-1C


Plat of survey of Lot 10 and part of Lot 9 of Ingleside Point in the Southeast 1/4 of Section 26, Town 4 North, Range 16 East, Town of La Grange, Walworth County, Wisconsin, more particularly described as follows:

Beginning at an iron rod on a meander line at the Southeast corner of Lot 10 of said Ingleside Point, said iron rod located North 75°00'00" West, 8.20 feet more or less from the shore of Middle Lake; thence North 75°00'00" West, 209.94 feet to an iron rod on a meander line, said rod is located South 75°00'00" East, 3.70 feet more or less from the shore of a marsh; thence along the said meander line, North 8°39'45" West, 50.00 feet; thence North 32°09'20" West, 30.00 feet to an iron rod on the end of said meander line, said rod is located South 82°44'16" East, 1.40 feet more or less from a marsh; thence South 82°44'16" East, 250.29 feet to an iron rod on a meander line, said iron rod is located North 82°44'16" West, 6.00 feet more or less from the shore of Middle Lake; thence along the said meander line, South 12°38'00" West, 99.96 feet to the point of beginning, also all the land between the above described meander lines and the shore of Middle Lake on the East and the marsh on the West, containing 0.46 acres more or less.

The above described property has been surveyed under my direction and the above map is a true representation thereof and shows the size and location of the property and its exterior boundaries to the best of my knowledge and ability.

Dated this 9th day of August, 1976.

Lloyd L. Jensen
Lloyd L. Jensen, Registered Land
Surveyor No. S-211

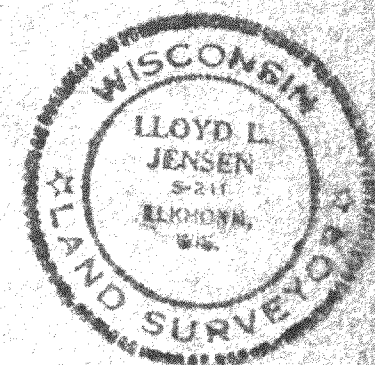

OWNER: WILLIAM FLAIG
SURVEYED FOR: ANGIE STENSTROM

PLAT OF SURVEY OF

Lot 10 and part of Lot 9 of Ingleside Point in the Southeast 1/4 of Section 26, Town 4 North, Range 16 East, Town of La Grange, Walworth County, Wisconsin.

Lloyd L. Jensen
SURVEYOR

SCALE 1" = 50'

DATE Aug. 9, 1976

416-233 x