
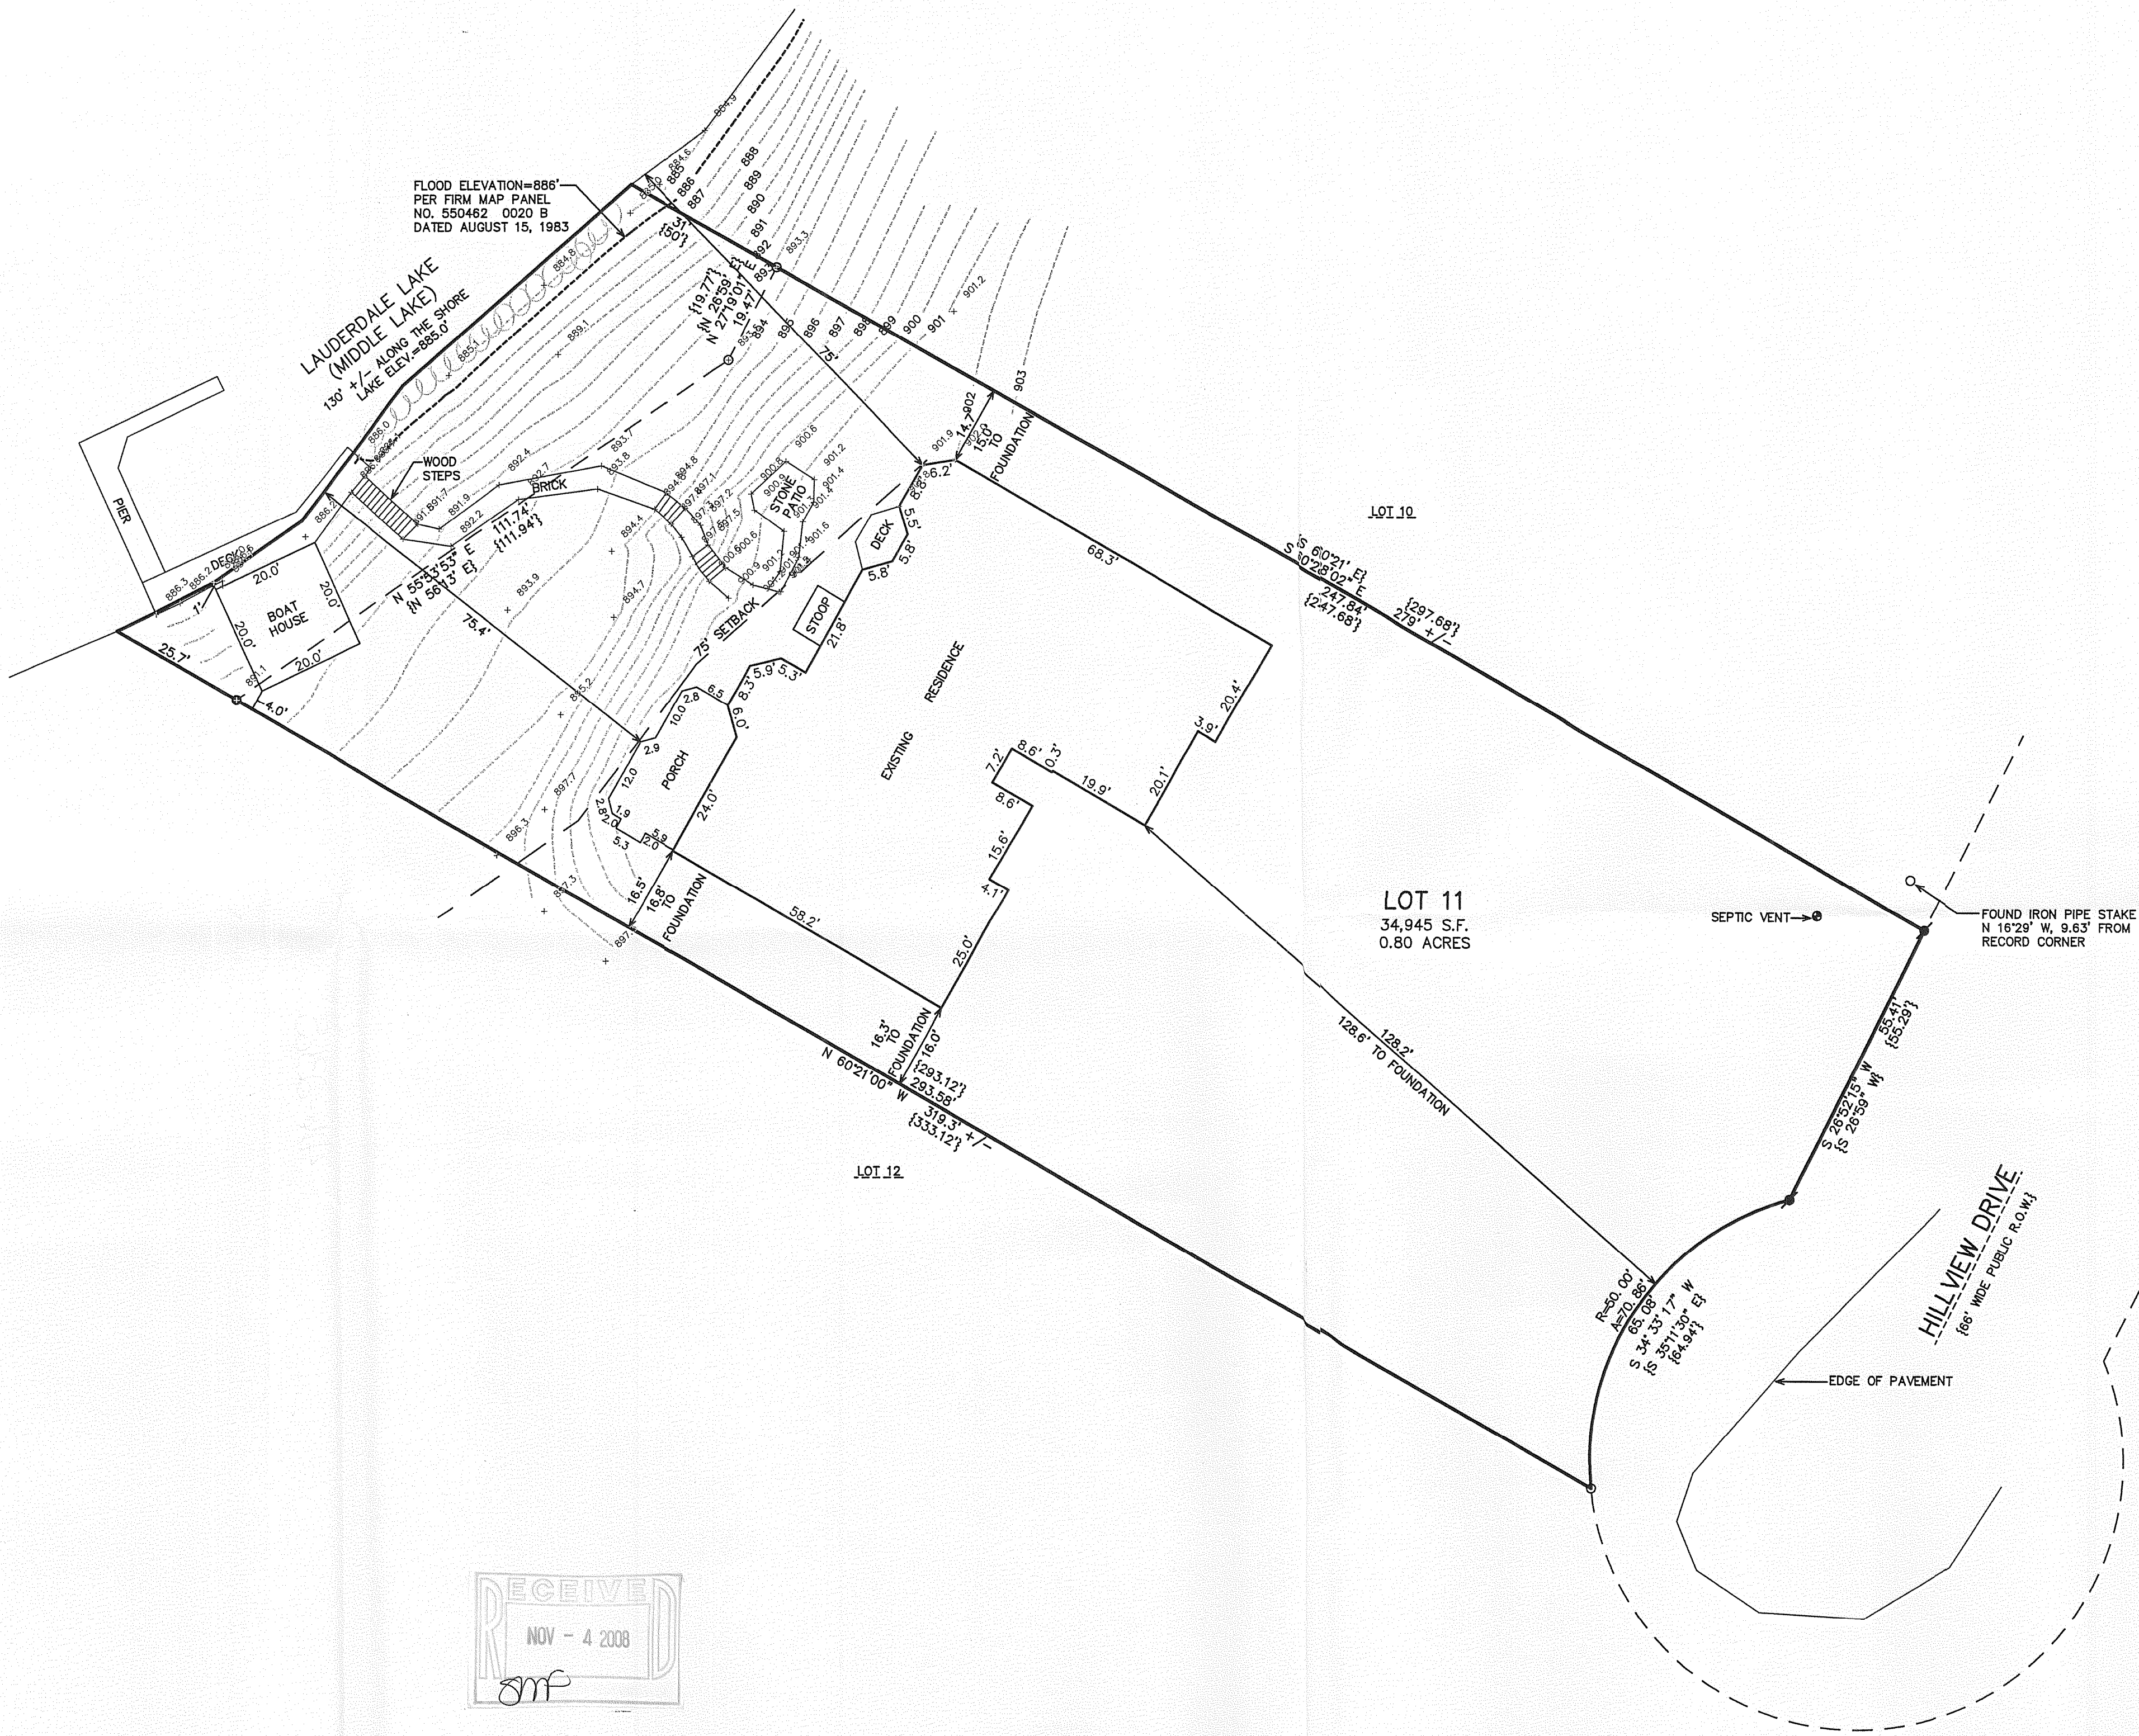



ASSIGNED SOUTHEAST LINE OF LOT 11
N 80°21'00" W

PLAT OF SURVEY
LOT 11 OF HILLVIEW PARK SUBDIVISION
LOCATED IN THE SOUTHEAST 1/4 OF THE NORTHWEST 1/4 OF
SECTION 35, TOWN 4 NORTH, RANGE 16 EAST, WALWORTH COUNTY, WISCONSIN

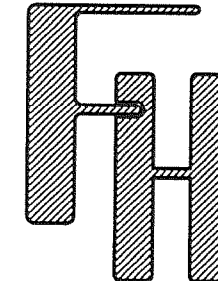

RECEIVED
NOV - 4 2008
SM

- LEGEND
- = FOUND IRON PIPE STAKE
 - = FOUND IRON REBAR STAKE
 - ⦿ = SET IRON REBAR STAKE
 - {xxx} = RECORDED AS

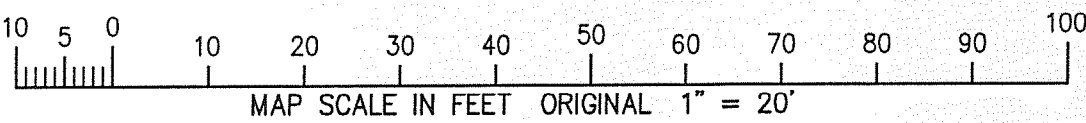

NOTE: COPIES OF THIS MAP TO WHICH THE FOLLOWING CERTIFICATE
WILL APPLY SHOW THE SURVEYOR'S ORIGINAL SEAL AND SIGNATURE
IN RED INK. COPIES BY ANY OTHER MEANS MAY HAVE ALTERATIONS
WHICH DO NOT REPRESENT THE SURVEYOR'S WORK PRODUCT.

I HEREBY CERTIFY THAT THE ABOVE DESCRIBED PROPERTY HAS BEEN
SURVEYED UNDER MY DIRECTION AND THAT THE ABOVE MAP IS A TRUE
REPRESENTATION THEREOF AND SHOWS THE SIZE AND LOCATION OF
THE PROPERTY AND ITS EXTERIOR BOUNDARIES. THIS SURVEY IS
MADE FOR THE USE OF THE PRESENT OWNERS OF THE PROPERTY, AND
ALSO THOSE WHO PURCHASE, MORTGAGE, OR GUARANTEE THE TITLE
THERE TO WITHIN ONE YEAR FROM THE DATE HEREOF.



DATED: OCTOBER 30, 2007

PETER S. GORDON R.L.S. 2101

REVISED 08-22-2008
TO SHOW PROPOSED PORCH
REVISED 09-30-2008
TO SHOW AS-BUILT PORCH

WORK ORDERED BY -
FARRIS, HANSEN & ASSOCIATES, INC.
THELEN, WISCONSIN
P.O. BOX 17
ELKHORN, WI 53121

FARRIS, HANSEN & ASSOCIATES, INC.
ENGINEERING - ARCHITECTURE - SURVEYING
7 RIDGWAY COURT P.O. BOX 437
ELKHORN, WISCONSIN 53121
OFFICE: (262) 723-2098 FAX: (262) 723-5886

REVISIONS

PROJECT NO.
7472

DATE
10/30/2007

SHEET NO.
1 OF 1

HHV-11

416-2365