




SCALE 1"=40'
●- CONC. MONU.
○- IRON PIPE

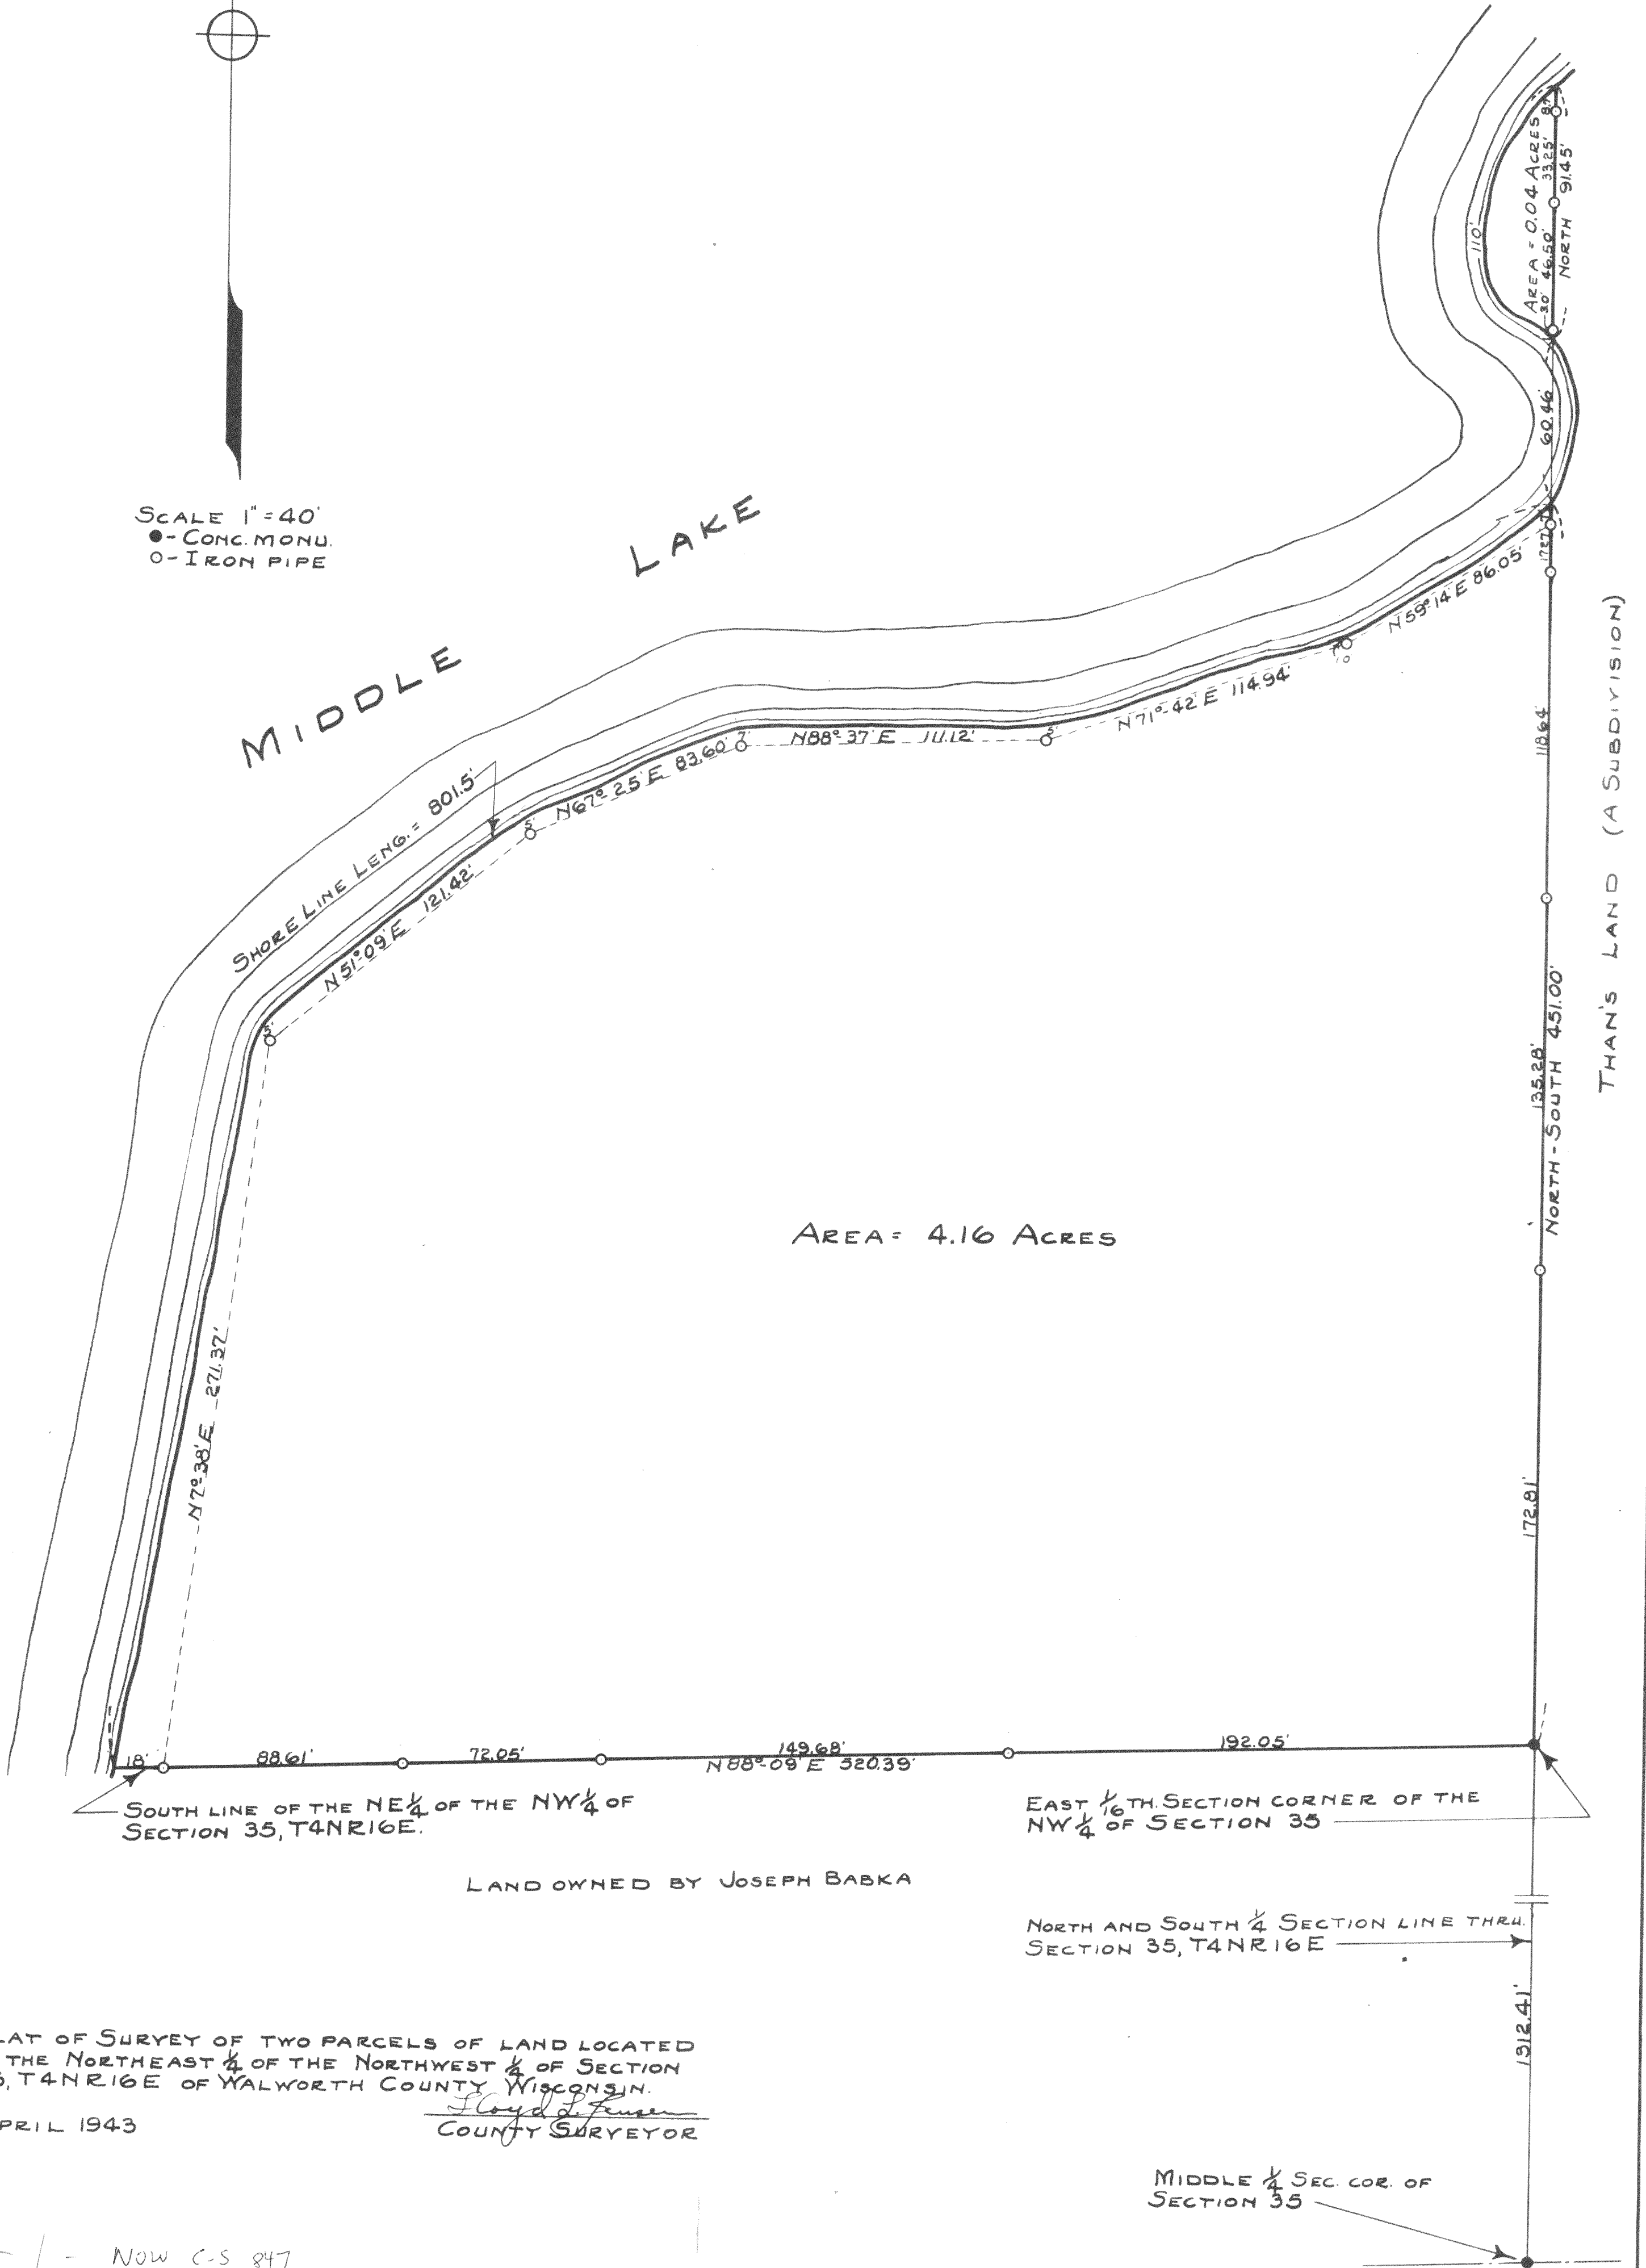

PLAT OF SURVEY OF TWO PARCELS OF LAND LOCATED
IN THE NORTHEAST 1/4 OF THE NORTHWEST 1/4 OF SECTION
35, T4NR16E OF WALWORTH COUNTY WISCONSIN.
APRIL 1943
Floyd Jensen
COUNTY SURVEYOR

LG-35-1 - NOW C-S 847