



PLAT OF SURVEY
LOTS 6 THRU 8 OF BLOCK 2 OF
COOPERS MID LAKES SUBDIVISION
LOCATED IN PART OF SECTION 35, TOWN 4 NORTH,
RANGE 16 EAST, WALWORTH COUNTY, WISCONSIN

WORK ORDERED BY -
ROBERT GRAPPLE
5691 FOREST ROAD
ELKHORN, WI 53121

FARRIS, HANSEN & ASSOCIATES, INC.
ENGINEERING - ARCHITECTURE - SURVEYING
7 RIDGWAY COURT P.O. BOX 437
ELKHORN, WISCONSIN 53121
OFFICE: (262) 723-2098 FAX: (262) 723-5886

REVISIONS

PROJECT NO.
6629
DATE:
09/07/04
SHEET NO.
1 OF 1

FOREST ROAD
30' WIDE R.O.W.

GUY WIRE
N 84°05'20" E
150.74'
(N 84°00'05" E)
(150.75')

CONCRETE
10.2'
11.2'
25.0'
21.2'
22.1'
25.7'
3.5'
20.4'

EXISTING
GARAGE

WOOD
FENCE

SEPTIC VENT

BRICK

CONCRETE
WALK

as built
ADDITION

EXISTING
RESIDENCE

21.5'

BRICK

DECK AT GRADE

LOT 6

37,320 S.F.
0.86 AC.

LOT 8

PROPOSED
ELEVATED DECK

STONE
STEPS

BRICK

LOT

WOOD
STEPS

WOOD
DECK

WOOD
STEPS

CEDAR WALK

MIDDLE
154' +/- ALONG

LAKE
THE SHORE

CEDAR WALK

153.08'

N 77°34'50" W

(28.5' +/-)
28.3' +/-

EXISTING
SHED

8.2'

8.1'

8.3'



1.6'

ASSIGNED EAST LINE OF LOT 6
S 00°00'00" W

N 00°07'22" W
204.18' (204.18')
251.4' +/-
(N 00°05'30" W)
(252.7' +/-)

LEGEND

- = FOUND IRON PIPE STAKE
● = FOUND IRON REBAR STAKE
(xxx) = RECORDED AS

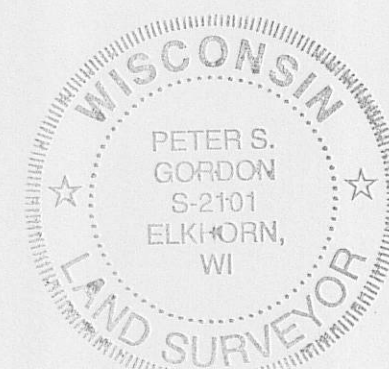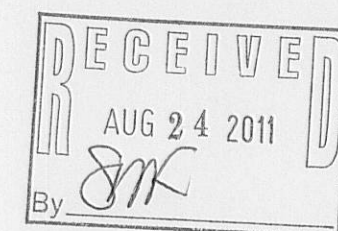

REVISED 08-12-2011
UPDATE IMPROVEMENTS &
ADD PROPOSED DECK

DATED: SEPTEMBER 7, 2004

PETER S. GORDON R.L.S. 2101

REVISED 11-07-2005
TO SHOW SIZE & LOCATION OF
PROPOSED ADDITION
REVISED 09-15-2009
TO SHOW AS BUILT ADDITION &
PROPOSED GARAGE

10 5 0 10 20 30 40 50 60 70 80 90 100
MAP SCALE IN FEET ORIGINAL 1" = 20'

HCO-8

416-2541