


Bay Drive

(66' Wide)

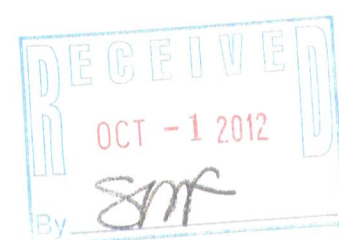

(Marsh)
Pond

Connected to Middle Lake
by channel.



Shoreline of Marsh
As shown the plat
of Bubbling Springs
Subdivision.

Lot 16
Tax Parcel
HBS 00016
0.312 Acre
13,604 Sq.Ft.

2 Story Deck

House
W5890

Garage

Garage 2.4' E. of line
Roof 1.7' E. of line

Well

Well

Roof Overhang

Garage

Garage 2.0' W. of line
Roof 1.1' W. of line

(43.51')
43.45'

Top of leaning pipe is
at corner, 2nd pipe is
straight, but is 0.31
N14°13'27"W of

Overhead Wires

Well

Well

