

Plat Of Survey

Property Address: N7420 Country Club Drive, Elkhorn, Wisconsin

Property Description: Outlot 2 in LAUDERDALE HEIGHTS, a subdivision in the Southwest 1/4 of Section 36, Town 4 North, Range 16 East, Town of Lagrange, Walworth County, Wisconsin.

April 8, 2013

Survey No. 13015



Prepared For:
Fredrick & Christy Micke

Legend

- = Found Iron Pipe
- = Set Iron Pipe
- △ = Set Mag Nail
- = Set RR Spike
- ⊙ = Well
- = Overhead Wires
- ⊕ = Power Pole




Scale: 1"=30'

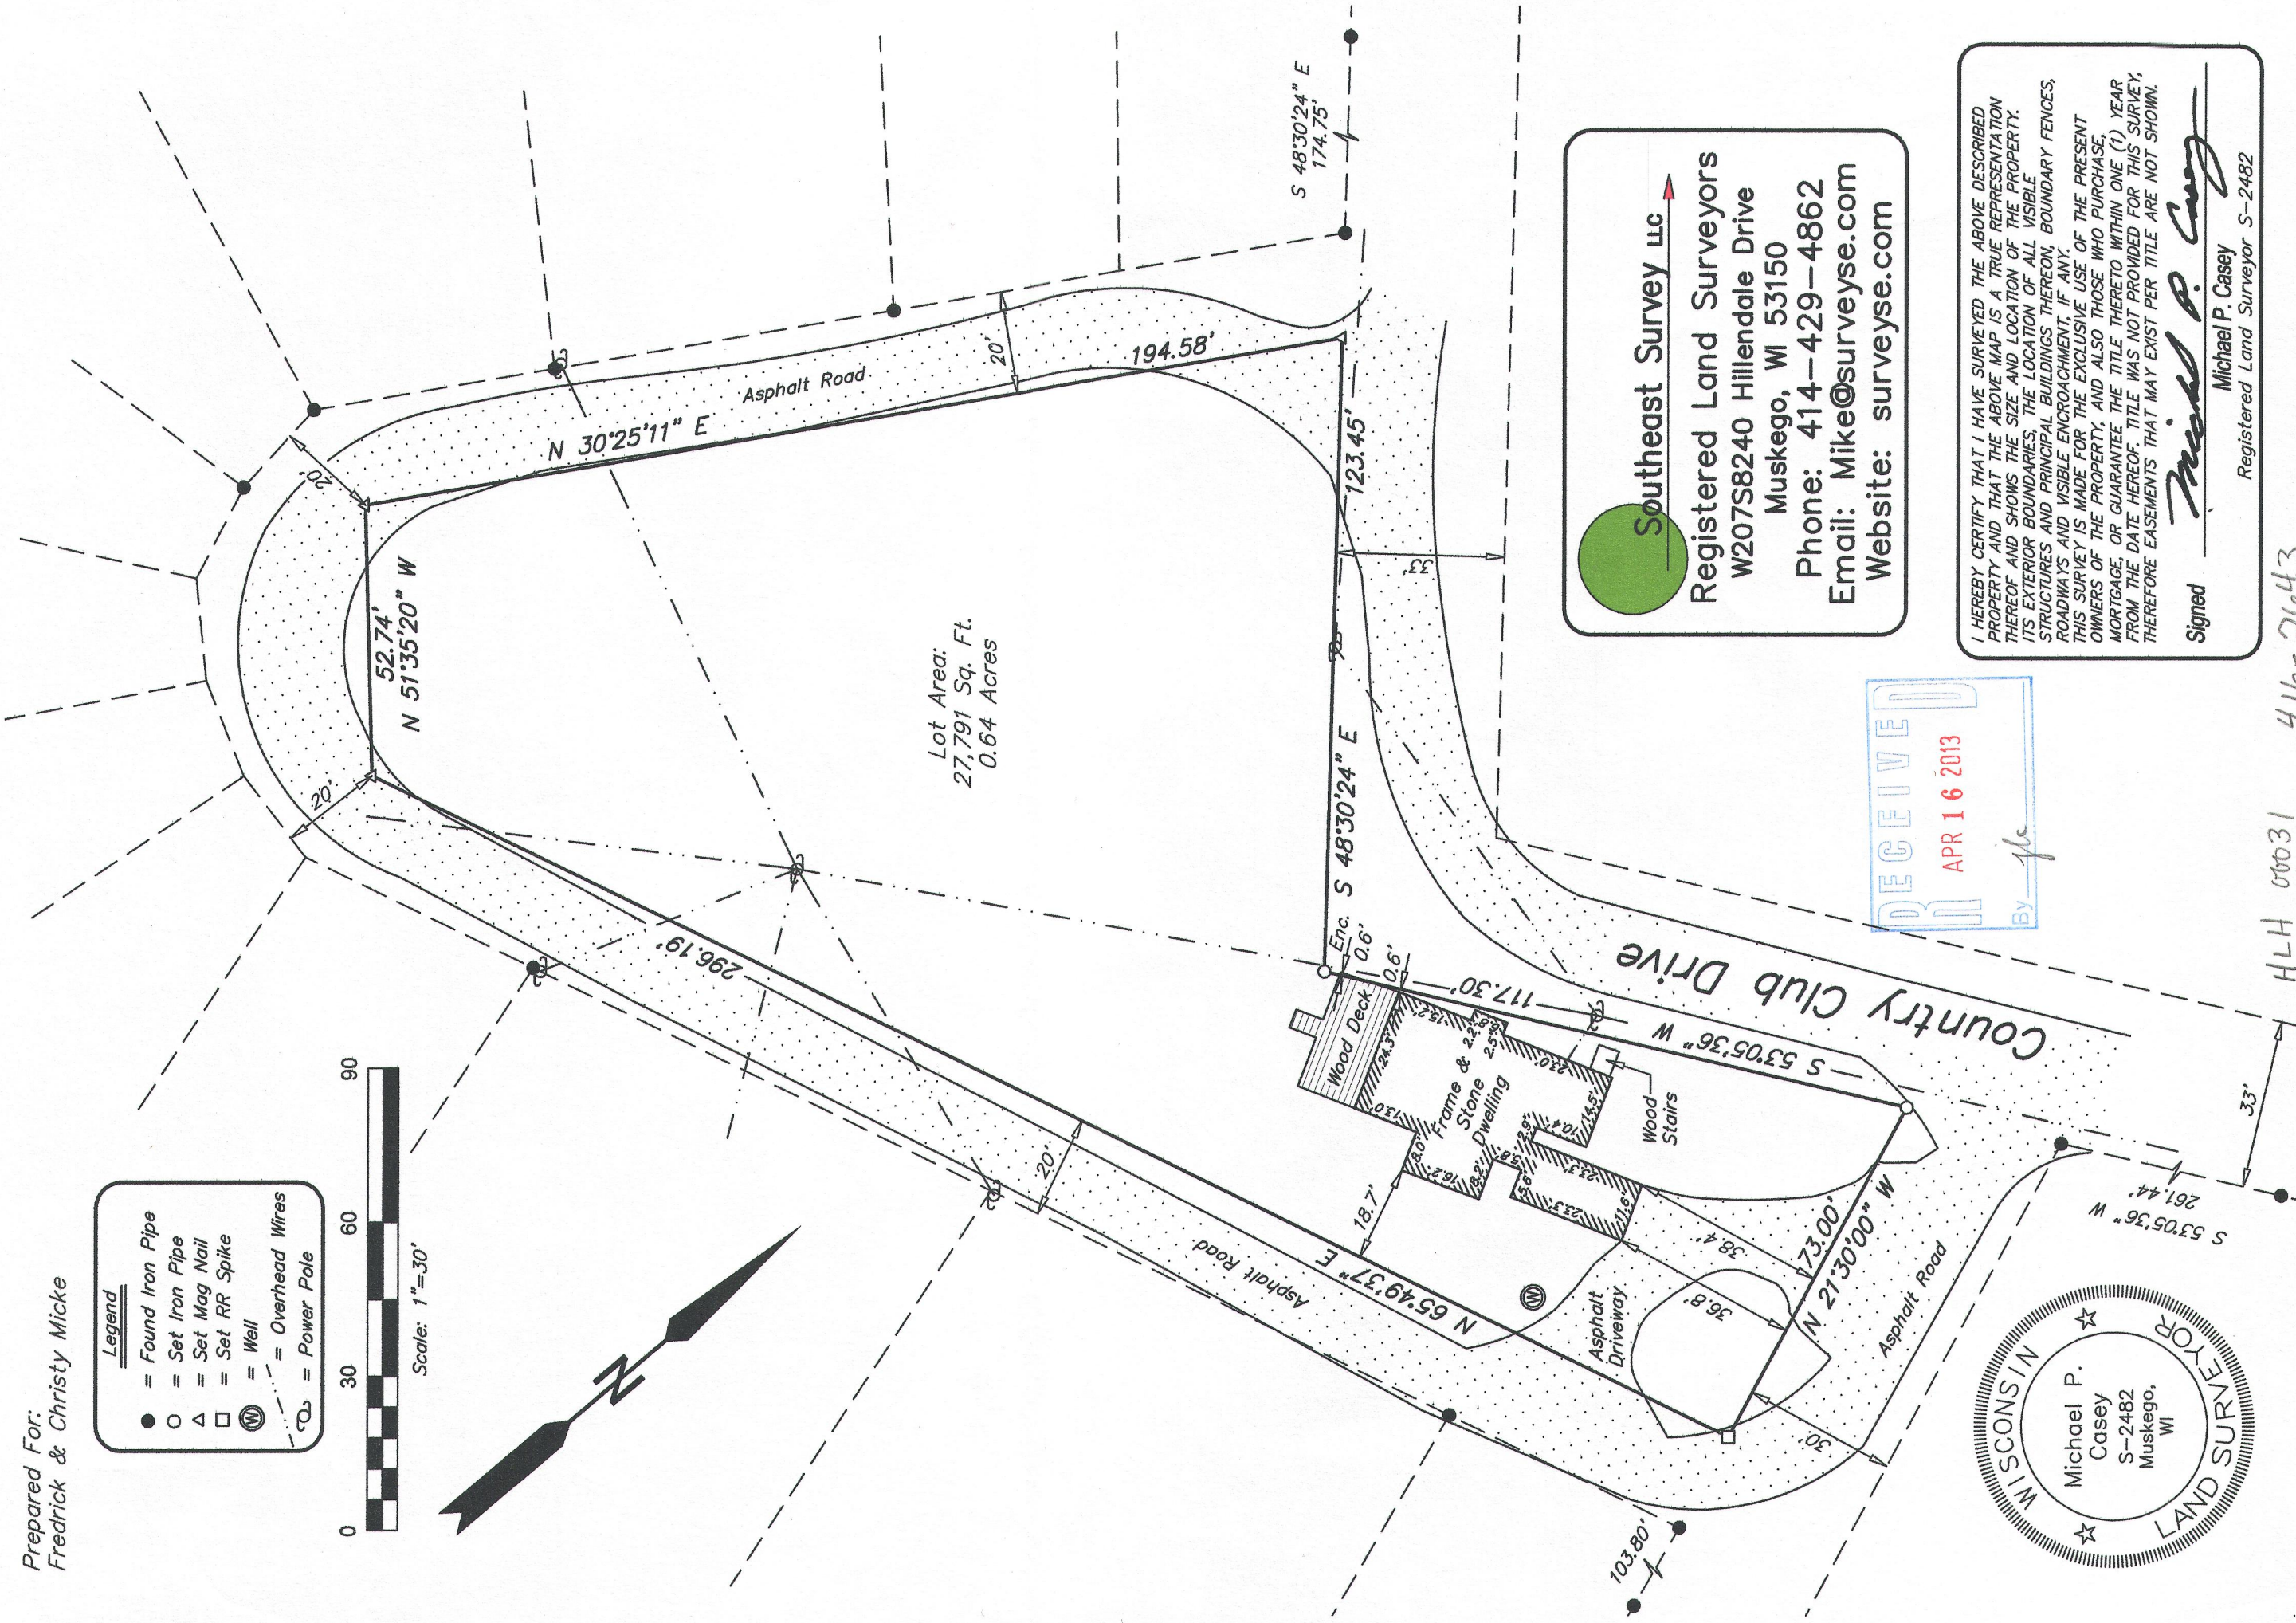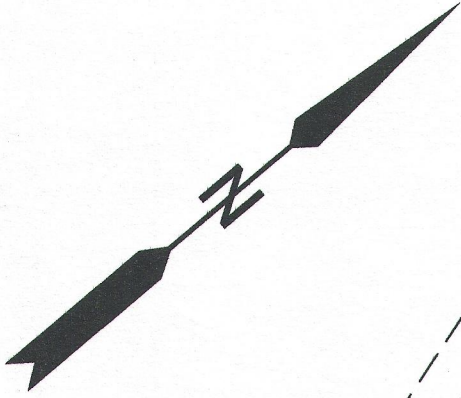

Southeast Survey LLC

Registered Land Surveyors
W207S8240 Hillendale Drive
Muskego, WI 53150
Phone: 414-429-4862
Email: Mike@surveyse.com
Website: surveyse.com

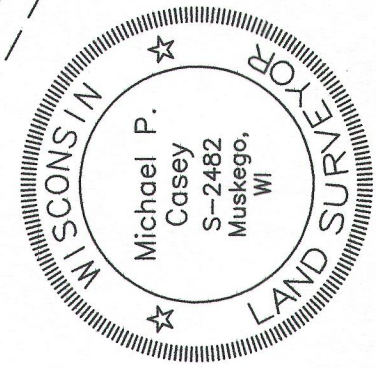

I HEREBY CERTIFY THAT I HAVE SURVEYED THE ABOVE DESCRIBED PROPERTY AND THAT THE ABOVE MAP IS A TRUE REPRESENTATION THEREOF AND SHOWS THE SIZE AND LOCATION OF THE PROPERTY, ITS EXTERIOR BOUNDARIES, THE LOCATION OF ALL VISIBLE STRUCTURES AND PRINCIPAL BUILDINGS THEREON, BOUNDARY FENCES, ROADWAYS AND VISIBLE ENCROACHMENT, IF ANY. THIS SURVEY IS MADE FOR THE EXCLUSIVE USE OF THE PRESENT OWNERS OF THE PROPERTY, AND ALSO THOSE WHO PURCHASE, MORTGAGE, OR GUARANTEE THE TITLE THERETO WITHIN ONE (1) YEAR FROM THE DATE HEREOF. TITLE WAS NOT PROVIDED FOR THIS SURVEY, THEREFORE EASEMENTS THAT MAY EXIST PER TITLE ARE NOT SHOWN.

Signed *Michael P. Casey*
Michael P. Casey
Registered Land Surveyor S-2482

416-2643

HLH 00031