


PLAT OF SURVEY

BEING ALL THAT PART OF LOTS 3 AND 4 OF CERTIFIED SURVEY MAP No. 39 RECORDED IN VOLUME 1, PAGE 39 AT THE WALWORTH COUNTY REGISTER OF DEEDS, EXCEPTING THOSE LANDS DESCRIBED IN VOLUME 81, PAGE 548.

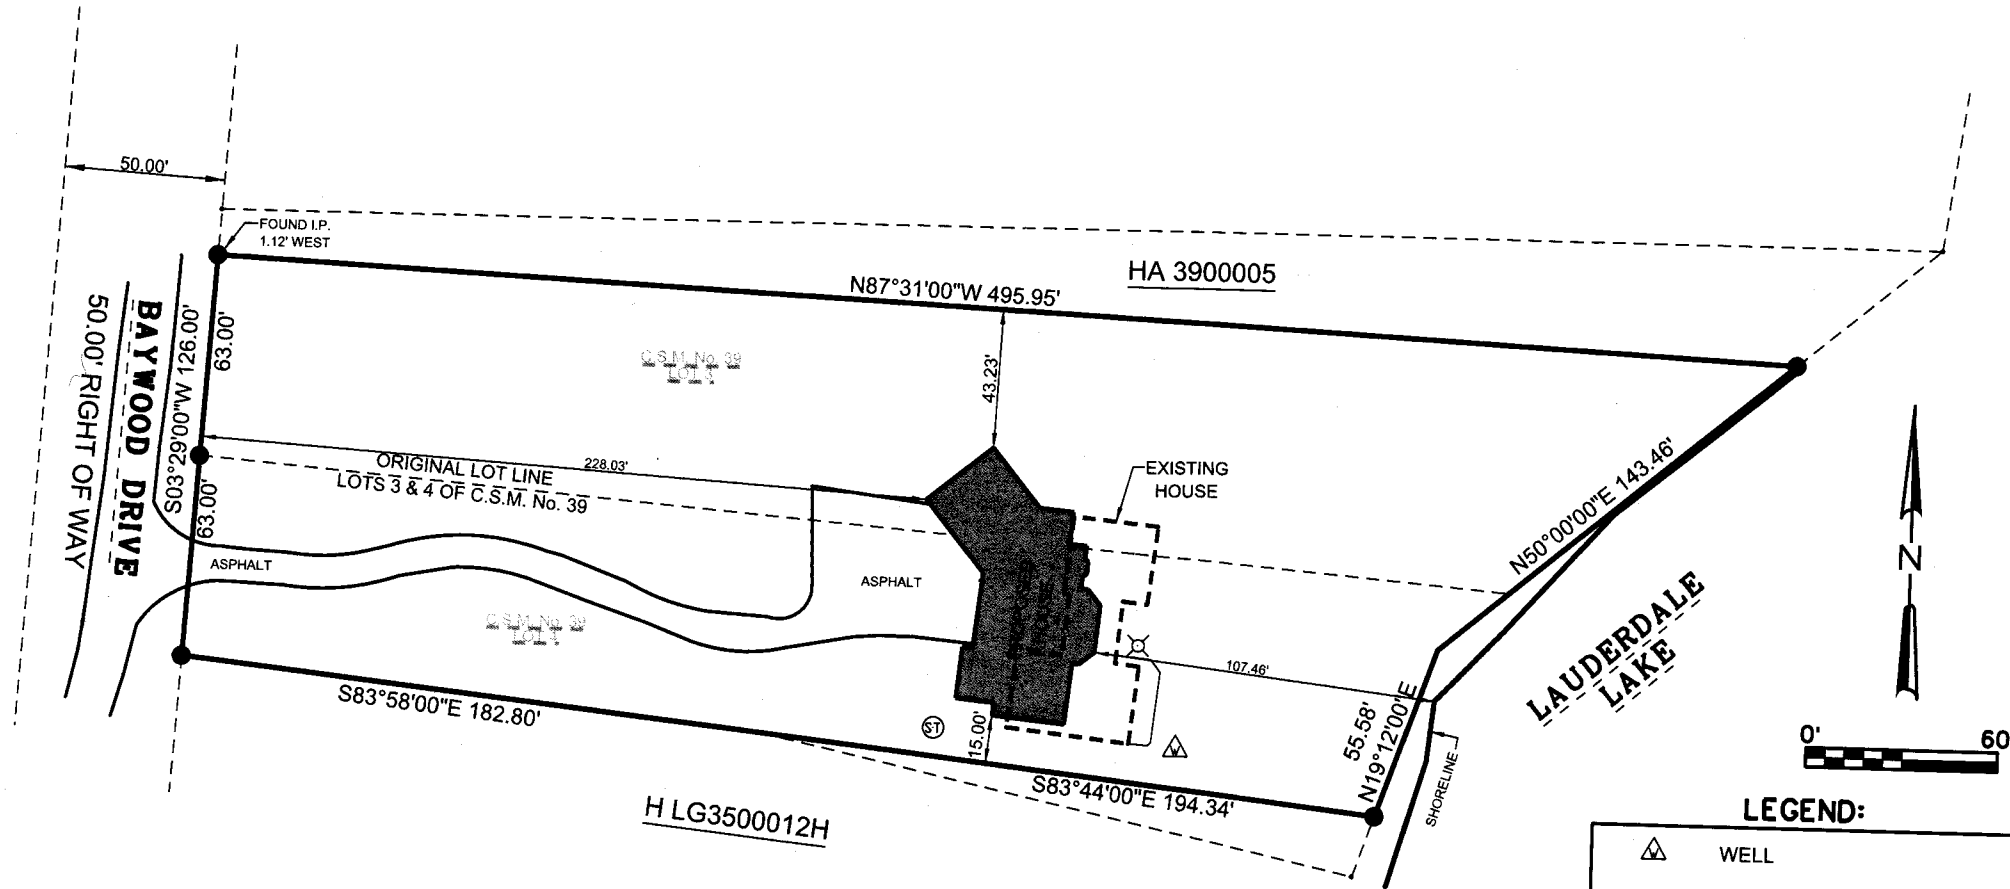

LEGEND:

- WELL
- SEPTIC TANK
- PVC PIPE
- 1" FOUND IRON PIPE, UNLESS NOTED
- 3/4" x 18" IRON PIPE SET, 1.13 lbs./L.F.

DEC 19 2013

HA 39-4


416-2684

THIS SURVEY IS MADE FOR THE USE OF THE PRESENT OWNERS OF THE PROPERTY, AND ALSO THOSE WHO PURCHASE, MORTGAGE OR GUARANTEE TITLE TO WITHIN ONE (1) YEAR FROM DATE HERETO.

I, MICHAEL A. GREESON R.L.S. #2770, HEREBY CERTIFY THAT THIS SURVEY WAS MADE IN ACCORDANCE WITH THE MINIMUM STANDARDS FOR PROPERTY SURVEYS (CHAPTER A-E 7) FOR THE STATE OF WISCONSIN AND HAS BEEN PREPARED UNDER MY DIRECTION AND CONTROL AND IS CORRECT TO THE BEST OF MY KNOWLEDGE AND BELIEF.

SURVEY DATE: 10/18/2013
SURVEY MADE FOR:
STRAIGHT ARROW BUILDERS
W5571 LOST NATION ROAD
ELKHORN, WI 53121

V2G
SURVEYING, LLC
550 BAYVIEW ROAD SUITE B
MUKWONAGO, WI 53149
(262) 662-0110

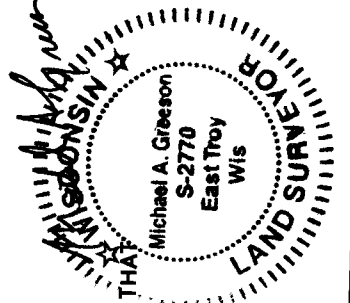

FILE NAME: \$FILES\$

PLOT DATE: 10/18/2013

V2G JOB#: 2013-017