


Sterlingworth
Bay

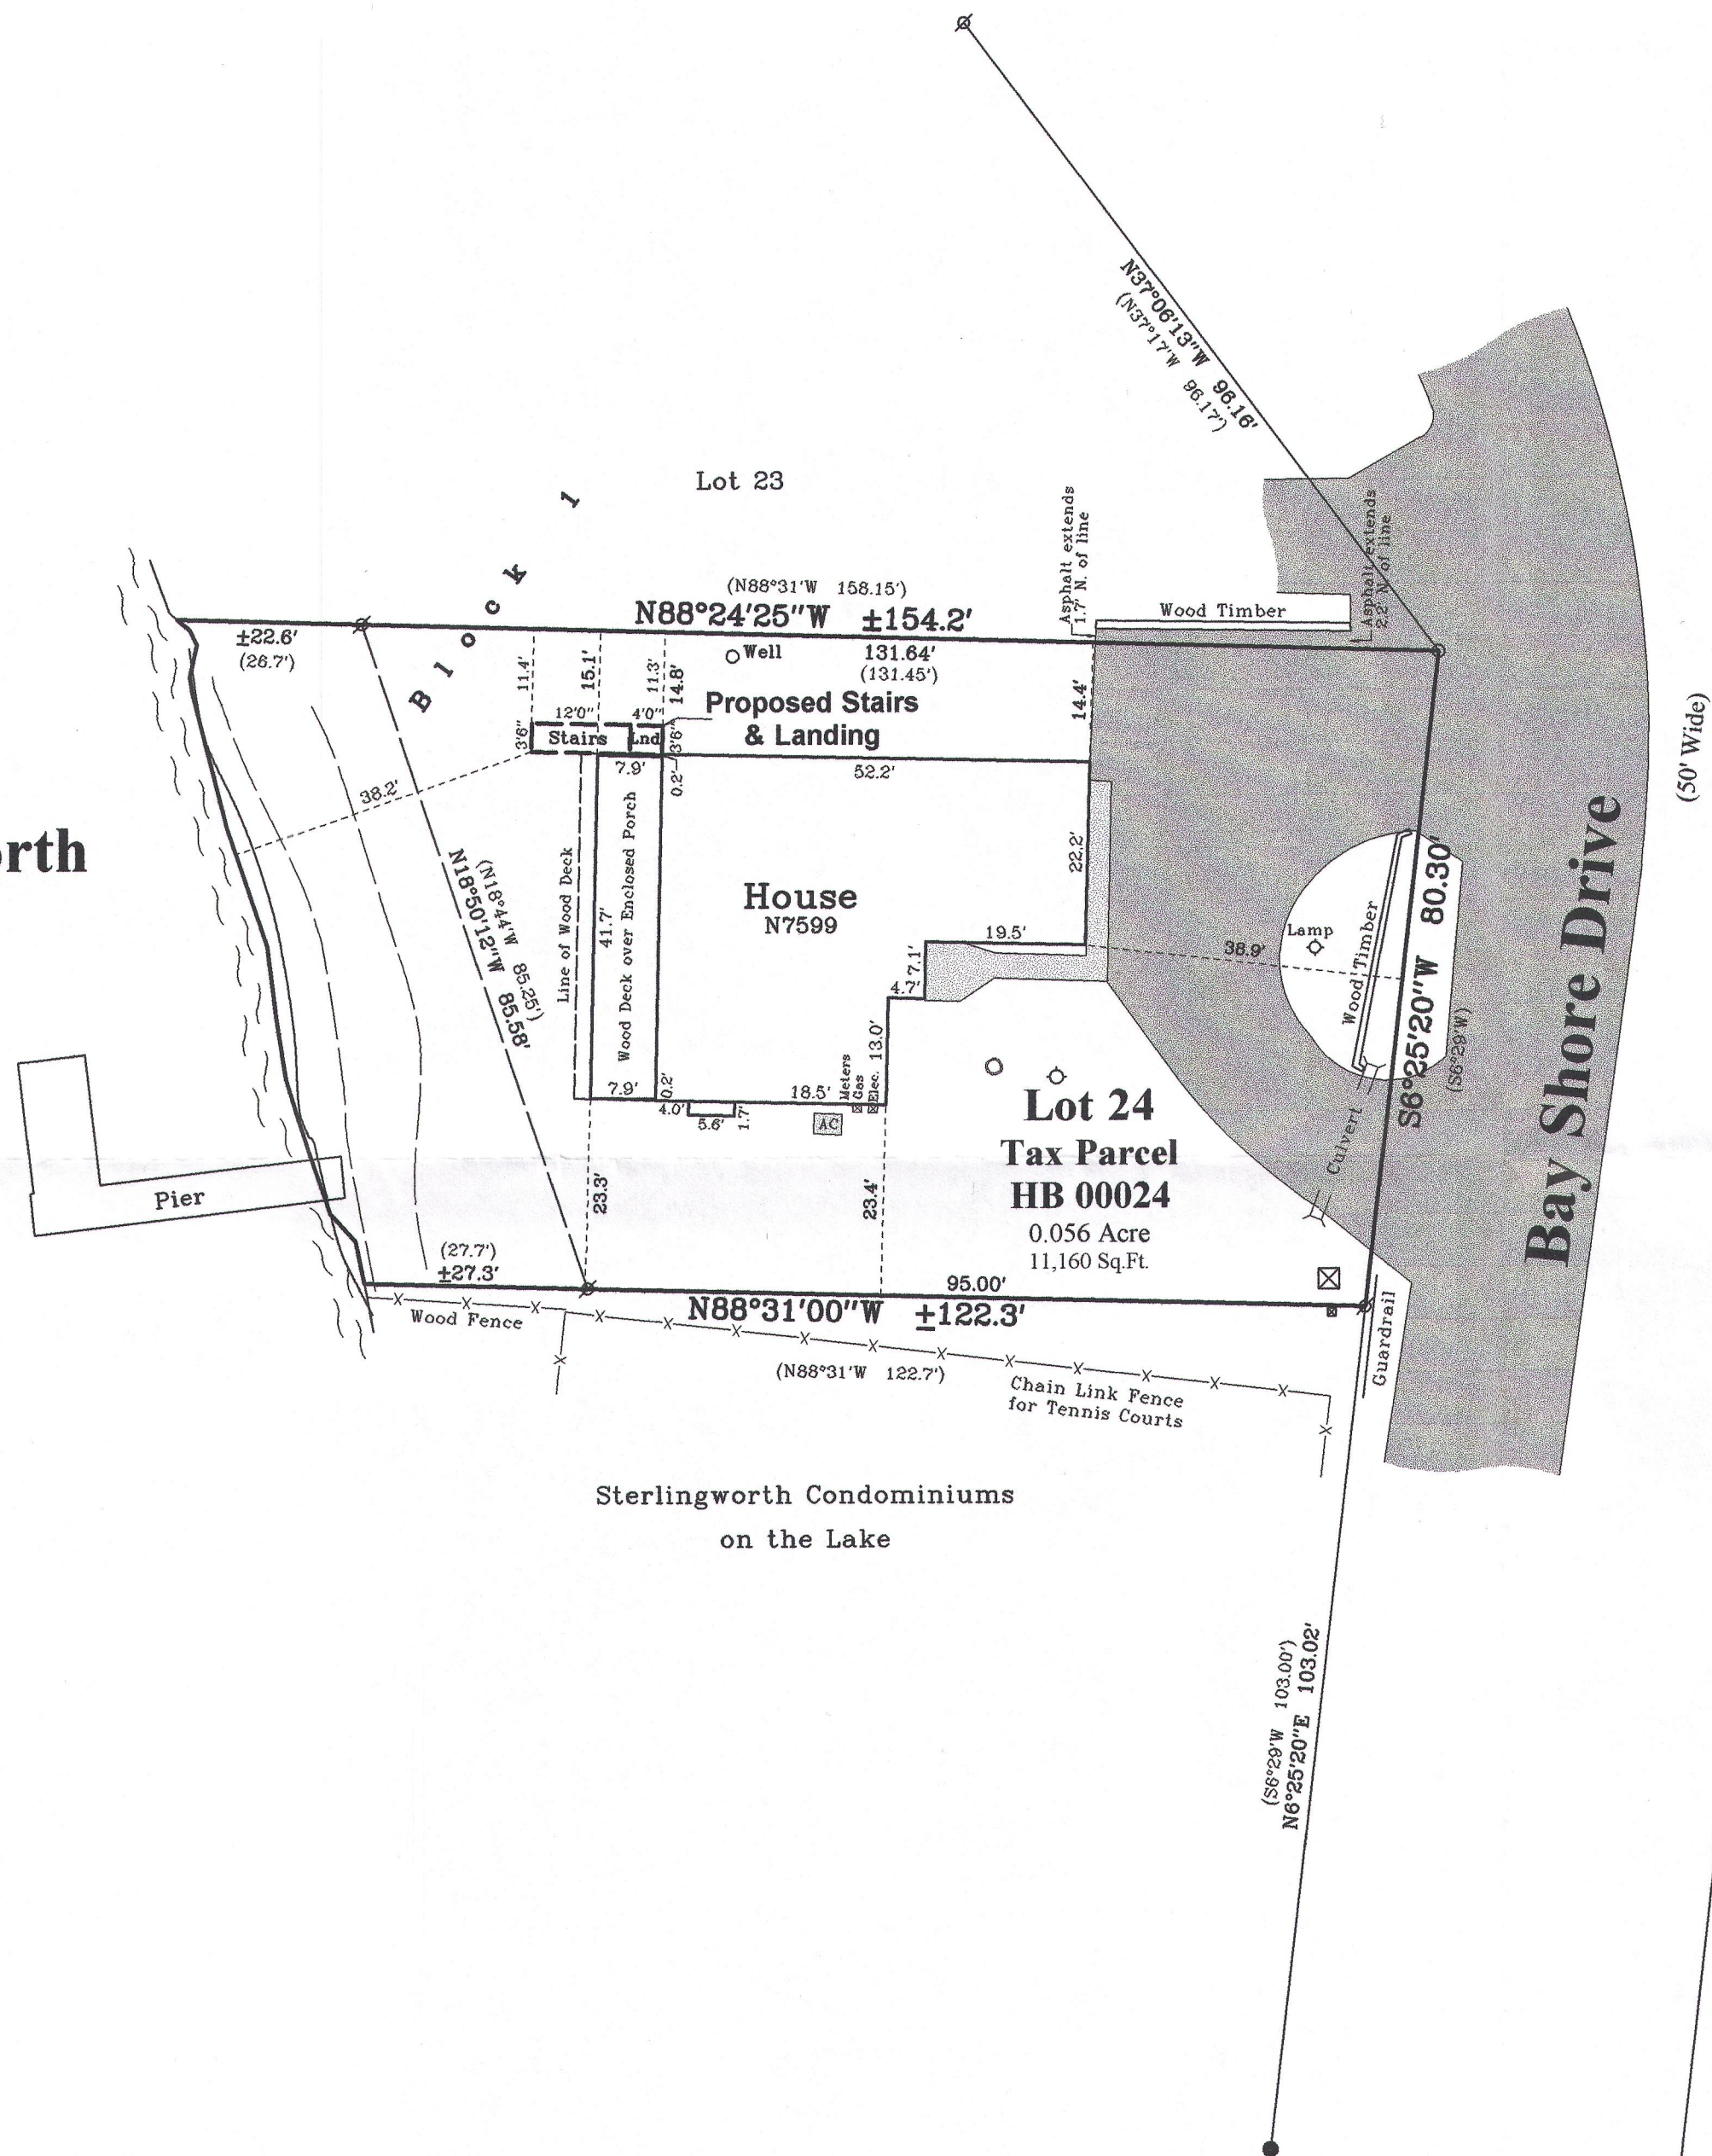


Plat of Survey

of



Lot 24 of Block 1 of Bay View Manor,

a subdivision located in the Northwest 1/4 of Section 36, Town 4 North, Range 16 East, Town of LaGrange, Walworth County, Wisconsin.

Surveyed for: **John Goetz**
1424 Saddleridge Place
Bartlett, Illinois. 60103

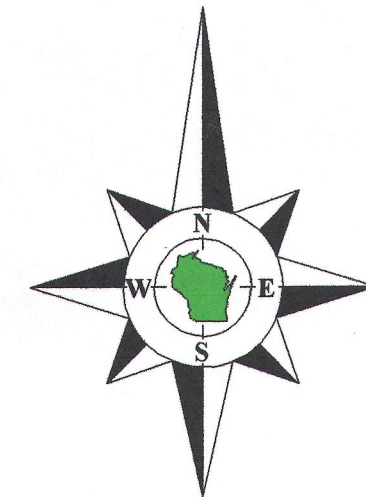

Bearings reference to the
plat of Bay View Manor.

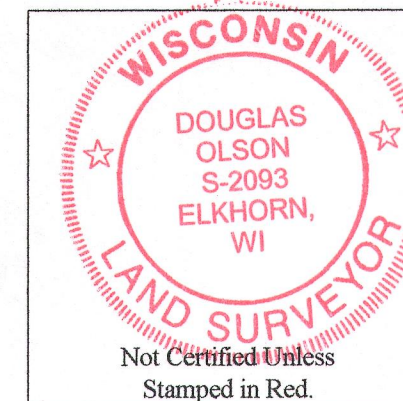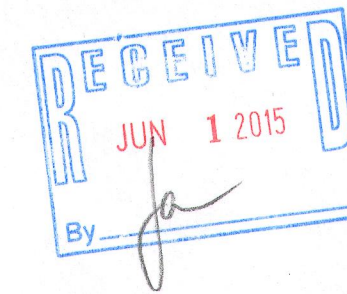

Notes:

- 1) This survey plat is not certified unless signed and sealed in red ink.
- 2) This survey is subject to Wisconsin lien laws. This Plat of Survey is the notice of intent to file lien. Lien waiver required.

Copyright 2012 by Jensen & Olson Land Surveying, LLC.


All rights reserved. No part of this survey plat may be reproduced or transmitted in any form by any means - graphic, electronic, or mechanical, including photocopying, tracing, or information storage and retrieval systems - without permission in writing from Douglas G. Olson, Jensen & Olson Land Surveying, LLC.

I hereby certify that I have surveyed the above described property and the map hereon is correct to the best of my professional knowledge and belief and shows the size and location of the property, its exterior boundaries, the location and dimensions of all visible structures thereon, boundary fences, apparent easements and roadways and visible encroachments, if any.

This survey is made for the exclusive use of the present owners of the property, and also those who purchase, mortgage or guarantee title thereto, within one year from the date hereof.

Douglas G. Olson
Wisconsin Registered Land Surveyor - 2093

Survey Date: January 4, 2013.
Revisions: No. 1 - Proposed Landing & Steps

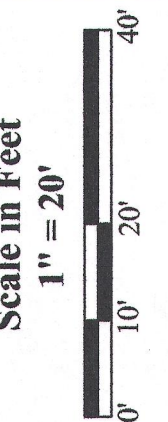

Jensen & Olson Land Surveying, LLC
45 South Wisconsin Street * P.O. Box 322 * Elkhorn, Wisconsin. 53121
Telephone: (262) 723-3434 * Facsimile: (262) 723-8044
Email: jensen.olson@elknet.net

Legend
Found Iron Pipe 1-3/16" dia.
Found Iron Rod, 1-3/16" dia.
Found P.K. Nail
Recorded Information
Utility Box or Pedestal
Concrete Cover
Asphalt Surface
Concrete

Sheet 1 of 1 Sheets
Drawing Name: hb16-2014106-2014106.plt
Job Reference Number
2014.106

2014.106

HB-24 416-2780