



PREPARED FOR
MICK BALESTRIERI
KEEFE REAL ESTATE
LAKE GENEVA WI

PLAT OF SURVEY

-OF-

PATHFINDER SURVEYING INC.
P.O BOX 322
LAKE GENEVA, WI. 53147
WWW.PATHFINDERSURVEYING.NET
262-248-8303

LOT 8 IN 3 BLOCK OF CARSWELL PARK, A SUBDIVISION LOCATED IN THE NORTHEAST 1/4 OF SECTION 35 AND THE NORTHWEST 1/4 OF SECTION 36, TOWN 4 NORTH, RANGE 16 EAST, TOWN OF LaGRANGE, COUNTY OF WALWORTH, STATE OF WISCONSIN.
TOGETHER WITH A PARCEL OF LAND LOCATED IN BLOCK 3 OF SAID CARSWELL PARK, AND BEING DESCRIBED AS: COMMENCING AT THE NORTHWEST CORNER OF THE ABOVE DESCRIBED LOT 8; THENCE NORTHERLY 21 FEET TO AN IRON STAKE; THENCE EASTERLY 50 FEET TO AN IRON STAKE; THENCE SOUTHERLY 21 FEET TO THE NORTHEAST CORNER OF THE ABOVE DESCRIBED LOT 8; THENCE WESTERLY ALONG THE NORTH LINE OF ABOVE LOT 8 TO THE PLACE OF BEGINNING. IT IS FURTHER AGREED THAT THE ABOVE DESCRIBED PARCEL OF LAND EXTENDS BACK TO THE 20 FOOT ROAD WAY, ALL BEING A PORTION OF SECTION 35, TOWN 4 NORTH, RANGE 16 EAST, TOWN OF LaGRANGE, WALWORTH COUNTY, WISCONSIN.

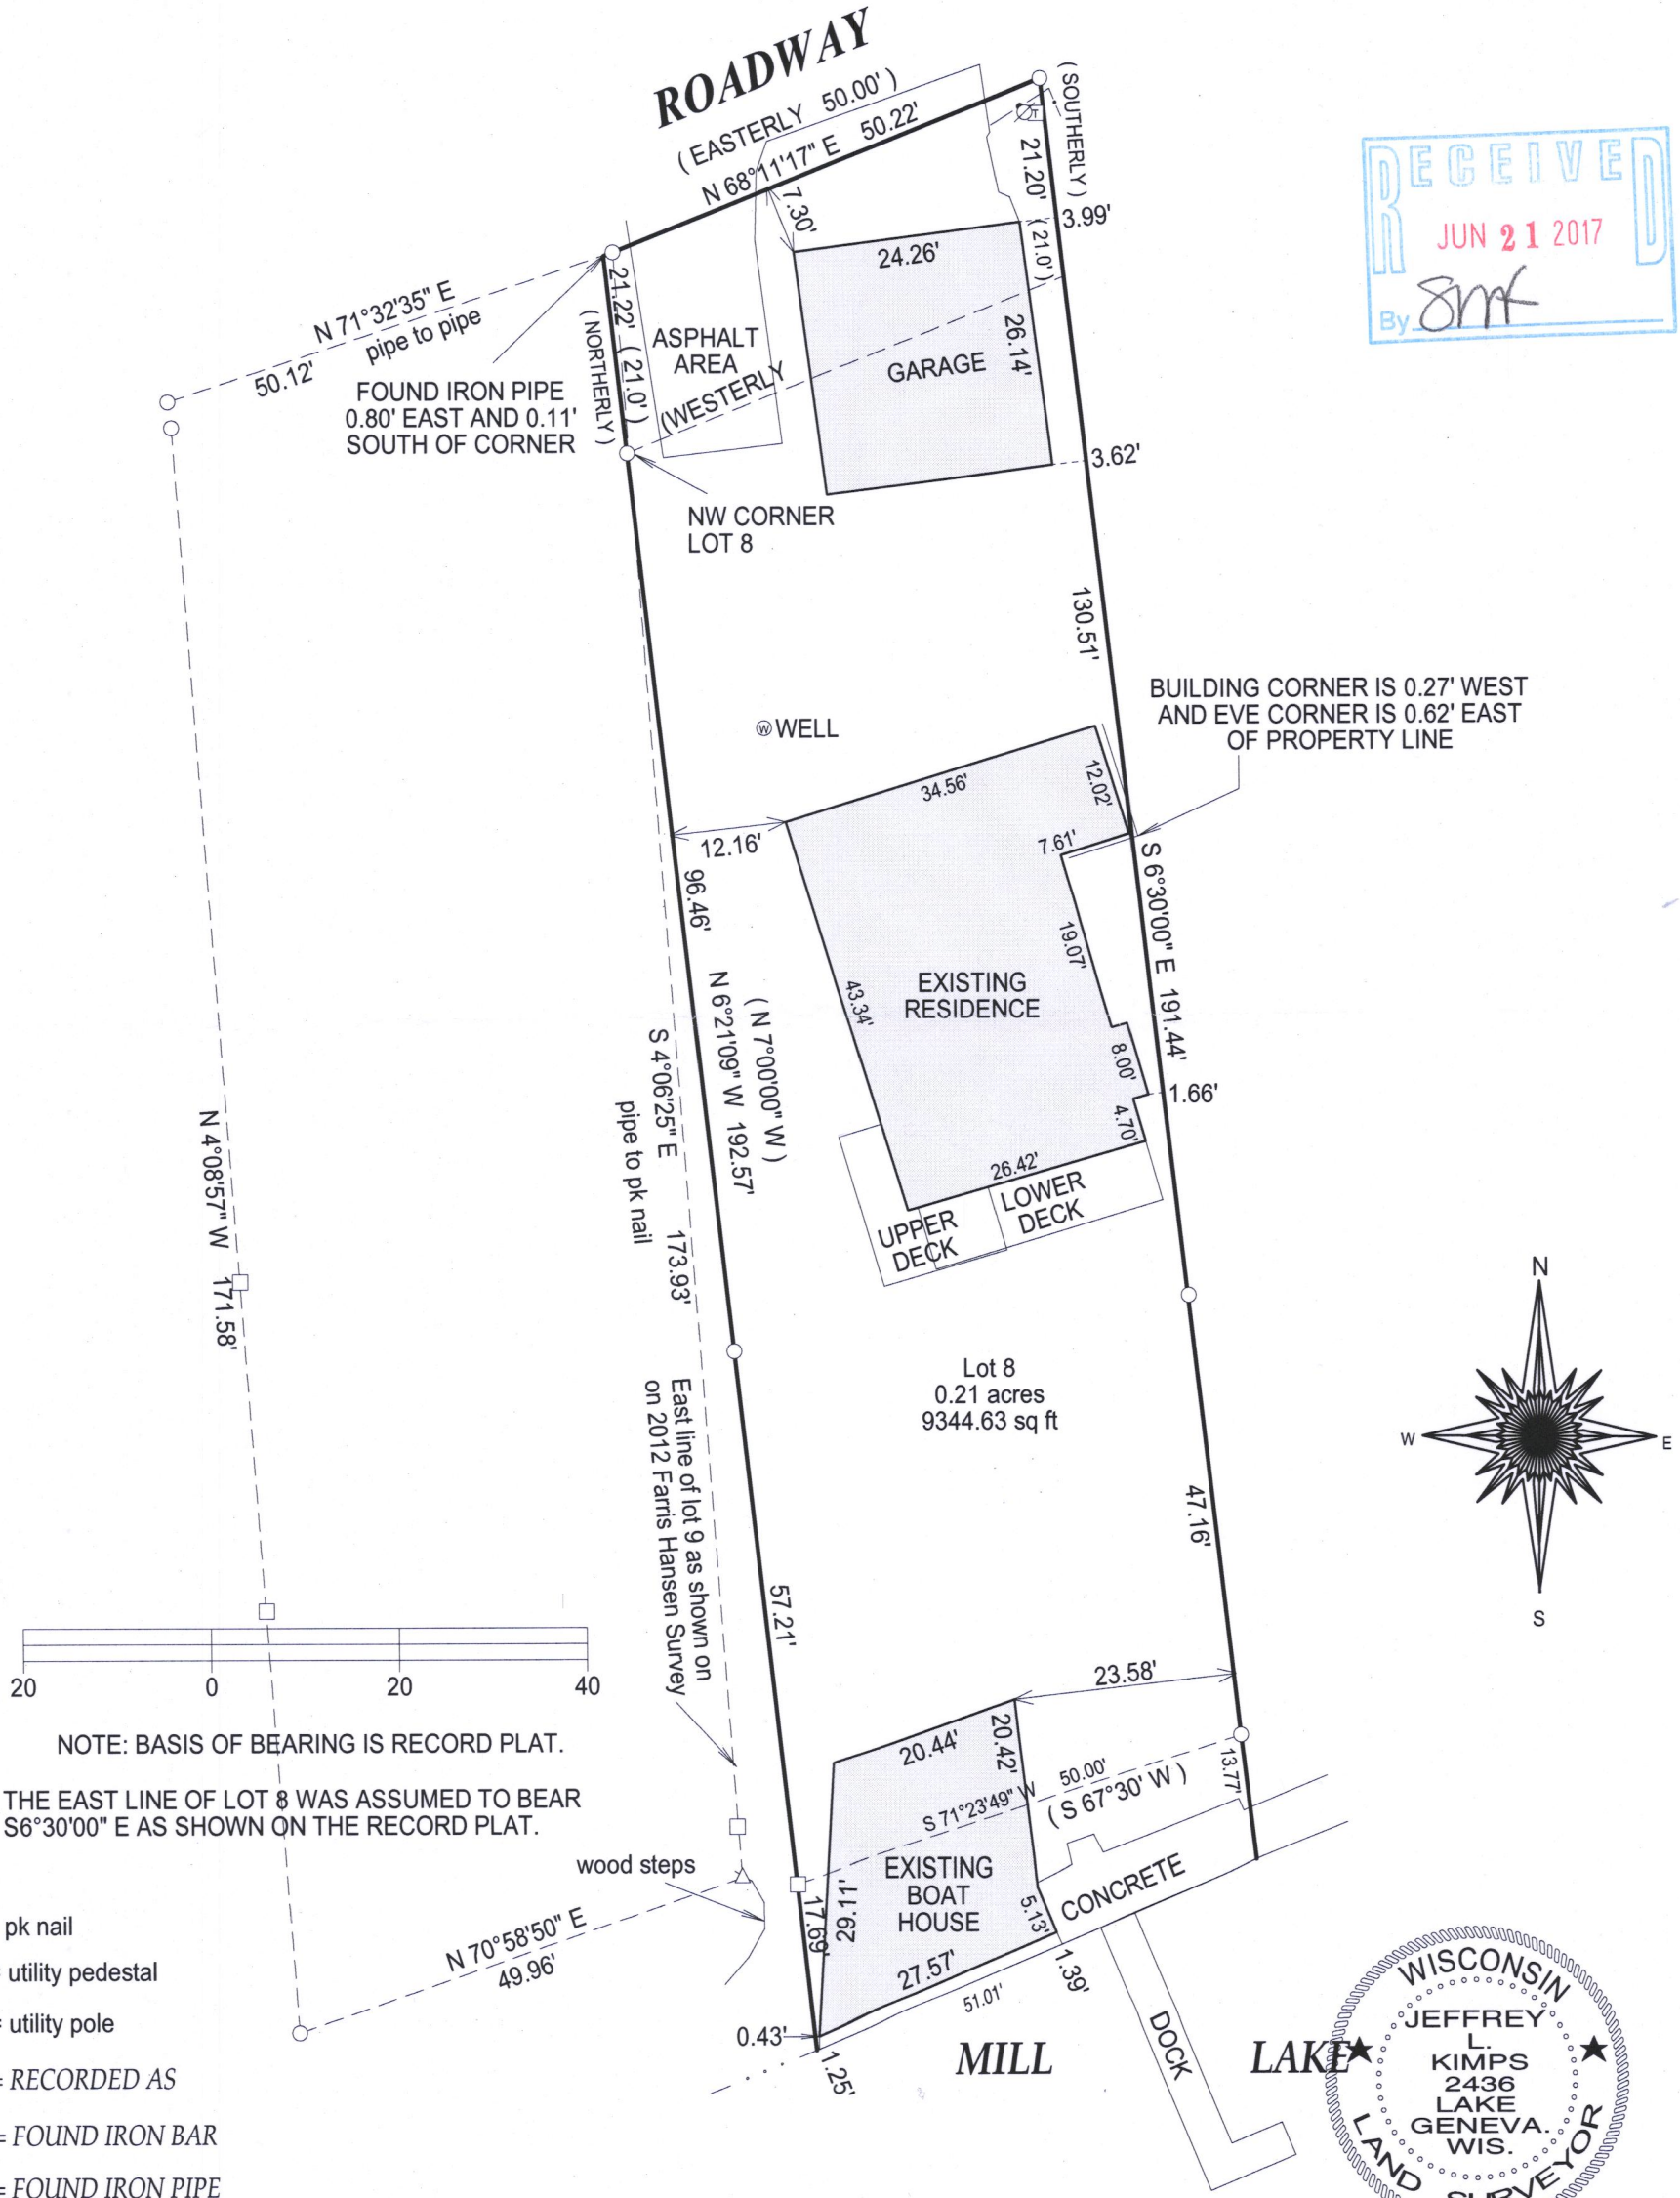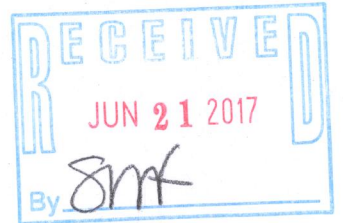

"I hereby certify that the above described property was surveyed under my supervision and that the above map, to the best of my knowledge and belief, is a true representation thereof and shows the size and location of all visible structures, apparent easements and encroachments if any."
This survey is made for the present owners of the property, and those who purchase, mortgage, or guarantee the title thereto, within one year from the date hereof.

ORIGINAL FIELD WORK THIS 24th DAY OF AUGUST, 2006.

WISCONSIN
JEFFREY L. KIMPS
2436
LAKE GENEVA, WIS.
LAND SURVEYOR

JEFFREY L. KIMPS S-2436
Wisconsin Professional Land Surveyor
(original if signed in red)

DATED THIS 22ND DAY OF MARCH, 2017

416-2927