


PLAT OF SURVEY

LOT 97 OF THE 2ND ADDITION TO BUBBLING SPRINGS SUBDIVISION,
LOCATED IN THE SOUTHEAST 1/4 OF SECTION 34, TOWN 4 NORTH,
RANGE 16 EAST, LAGRANGE TOWNSHIP, WALWORTH COUNTY,
WISCONSIN.

OUTLOT "B"

1ST ADDITION TO BUBBLING SPRINGS

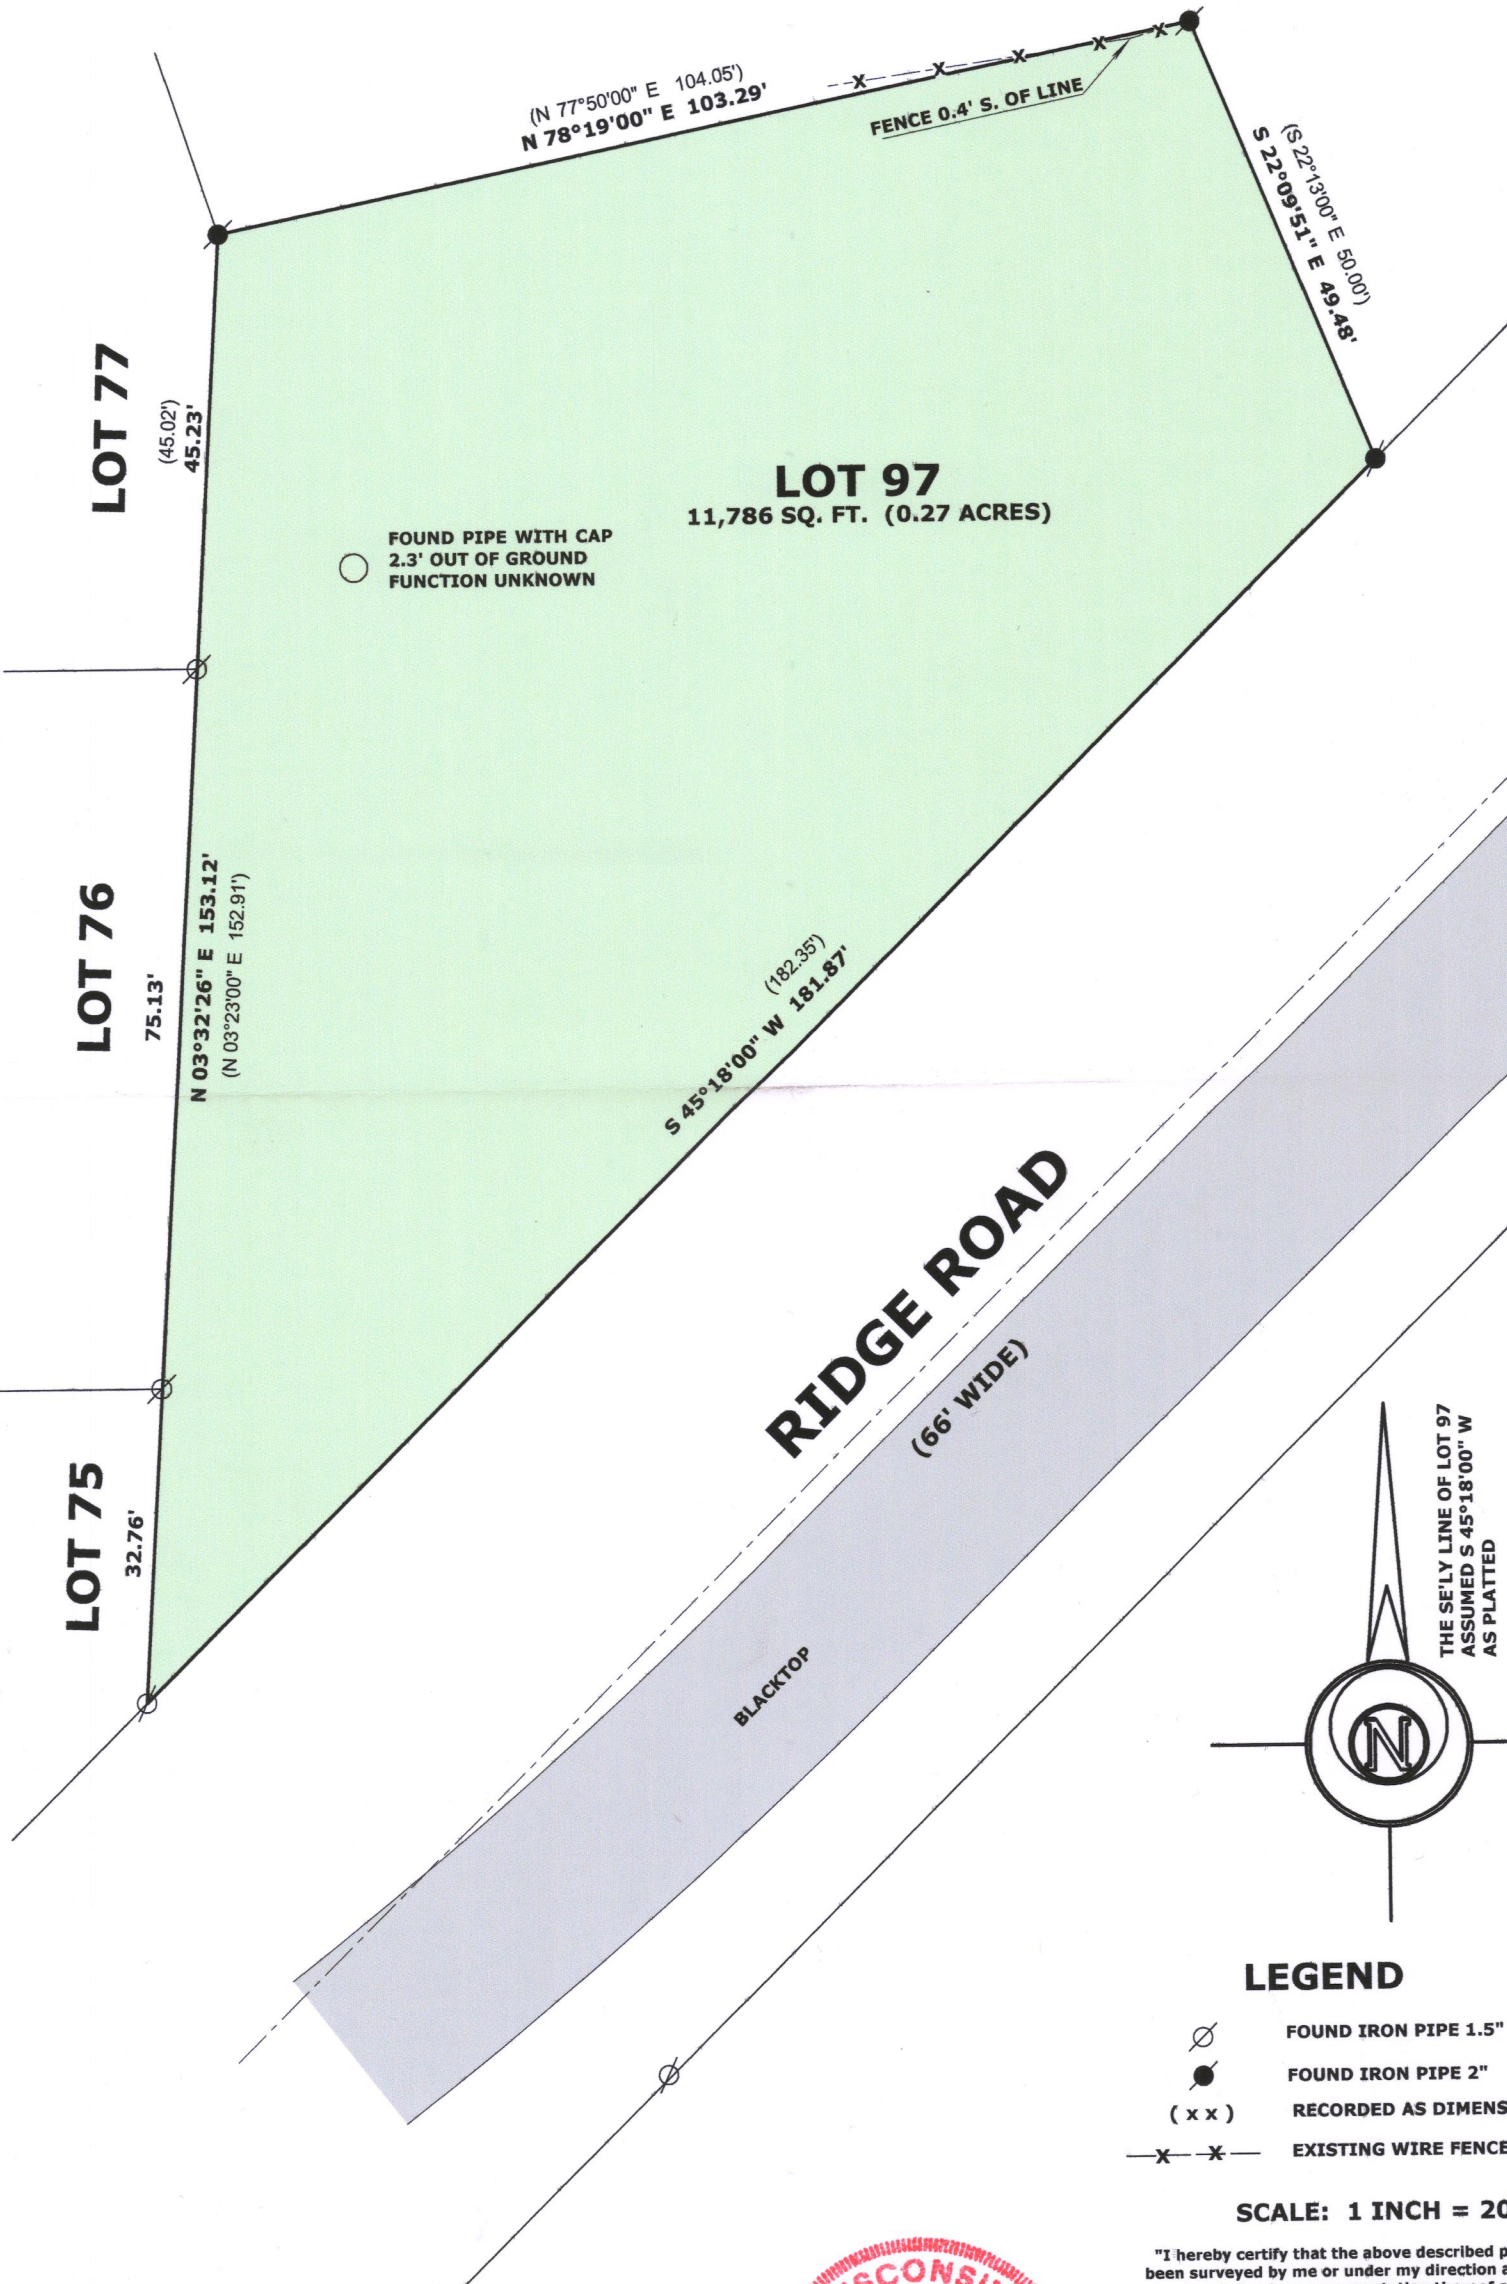

LEGEND

- ⊙ FOUND IRON PIPE 1.5"
- FOUND IRON PIPE 2"
- (x x) RECORDED AS DIMENSION
- x-x- EXISTING WIRE FENCE

SCALE: 1 INCH = 20 FEET

"I hereby certify that the above described property has been surveyed by me or under my direction and that the above map is a true representation thereof and shows the size and location of the property, its exterior boundaries, the location of all visible structures and dimensions of all principal buildings thereon, boundary fences, apparent easements, roadways and visible encroachments, if any."
"This survey is made for the use of the present owners of the property, and also those who purchase, mortgage, or guarantee the title thereto within one year from date hereof."

Mark L. Miritz
MARK L. MIRITZ
WISCONSIN PROFESSIONAL
LAND SURVEYOR S-2582

DATE: APRIL 22, 2017 JOB NO. 17.408



H882-18

416-2931