


recorded in Vol. 31 of Certified Survey Maps of Walworth County on Page 29  
and located in Government Lot 8 in the Northeast 1/4 of Section 26, Town  
4 North, Range 16 East, Town of LaGrange, Walworth County, Wisconsin.

Surveyed for: **Edmund & Suzette Sorenson**  
N8011 Surfwood Drive  
Elkhorn, Wisconsin. 53121

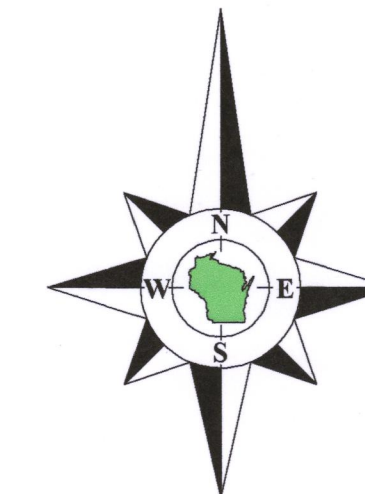

Bearings referenced to the South line of Lots 23 & 24 of Pebble Beach, recorded as S89°37'35"E, which produces a bearing of N0°11'16"E on the line from the northeast corner of Section 26-16 to the McMeider Corner on the East line of Section 26-16. A rotation of -0°31'39" from the Wisconsin State Plane Coordinate System, South Zone, (NAD-27).

Coordinates are referenced to the Wisconsin State Plane Coordinate System, South Zone, (NAD-27).

Lot 9

Lot 8

Lot 7

**Surfwood Drive**  
Doc. No. 261447.

Copyright ©2017 by Olson Land Surveying, LLC.

All rights reserved. No part of this survey plat may be reproduced or transmitted in any form by any means - graphic, electronic, or mechanical, including photocopying, tracing, or information storage and retrieval systems - without permission in writing from Douglas G. Olson, Olson Land Surveying, LLC.

I hereby certify that I have surveyed the above described property in compliance with Chapter A-E 7 of the Wisconsin Administrative Code and that the map hereon is correct to the best of my professional knowledge and belief and shows the size and location of the property, its exterior boundaries, the location and dimensions of all visible structures thereon, boundary fences, apparent easements and roadways and visible encroachments, if any.

This survey is made for the exclusive use of the present owners of the property, and also those who purchase, mortgage or guarantee title thereto, within one year from the date hereof.

Douglas G. Olson  
Wisconsin Professional Land Surveyor - 2093

445 South Wisconsin Street | P.O. Box 322  
Elkhorn, Wisconsin. 53121  
Telephone: (262) 723-3434  
Facsimile: (262) 723-8044  
Email: [doug@olsonsurveying.com](mailto:doug@olsonsurveying.com)  
Website: [www.olsonsurveying.com](http://www.olsonsurveying.com)

**OLSON**  
LAND SURVEYING, LLC  
Rural | Residential | Commercial

**Legend** of Symbols & Abbreviations

4 County Section Corner  
Iron Pipe  
Iron Rod  
on Pipe, 1" dia.  
dedicated information  
y Pole  
y Box or Pedestal  
ete Cover  
Vent  
it Surface  
ete Surface  
l Surface  
Pavers  
Stone Surface

Sheet 1 of 1 Sheets  
 Name:  
 Job Reference Number  
 2014.112

2014.112

**Survey date:** December 23, 2017.

**Survey date:** December 23, 2017.  
**Revisions:** No. 1 – Doc. No. 261447  
 No. 2 – Recoded GSM

**Scale in Feet**  
1" = 30'

445 South Wisconsin Street | P.O. Box 53121  
Elkhorn, Wisconsin. 53121  
Telephone: (762) 723-3434

# OLSON

**Table 1**  
**Table of Symbols & Abbreviations**

Sheet 1 of 1 Sheets  
 Name:  
 Job Reference Number  
 2014.112

2014.112