


SURVEY WITH HOUSE LOCATION OF LOT 14 OF ARROWHEAD PARK ADDITION NUMBER 1

LOCATED IN SECTION 35, T4N, R16E, WALWORTH COUNTY, WISCONSIN

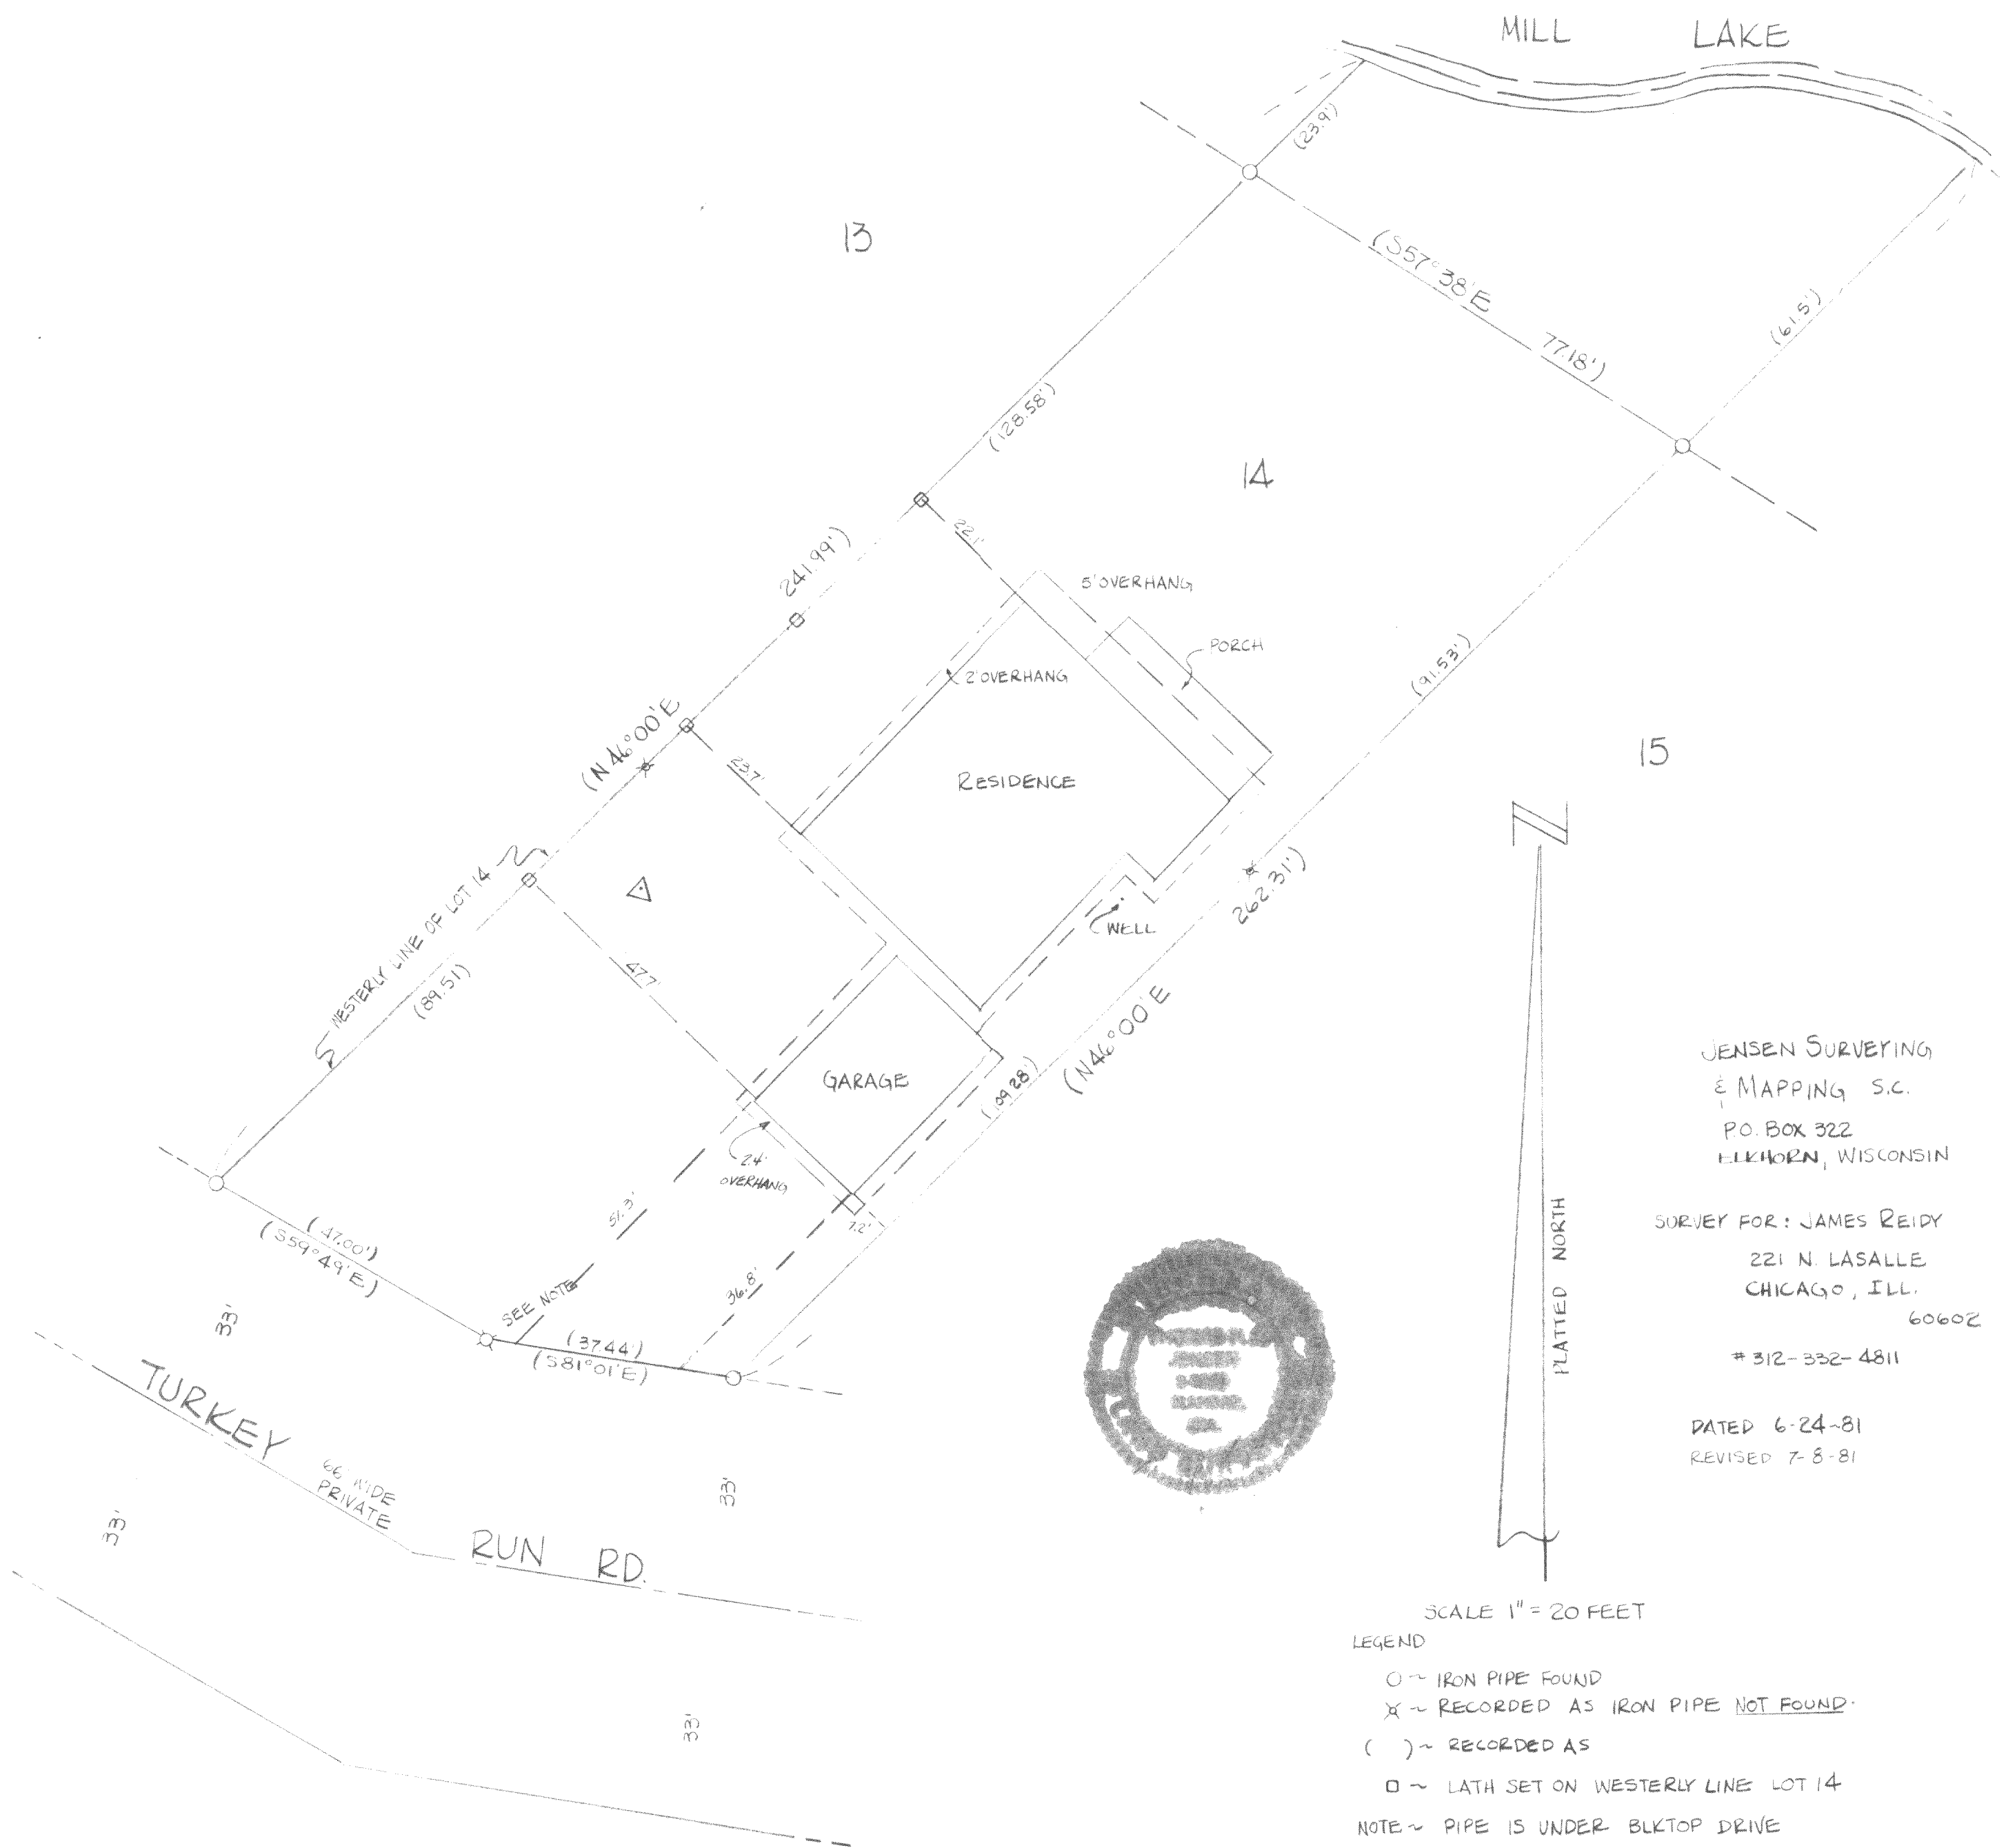

JENSEN SURVEYING
& MAPPING S.C.
P.O. BOX 322
ELKHORN, WISCONSIN

SURVEY FOR: JAMES REIDY
221 N. LASALLE
CHICAGO, ILL.
60602

312-332-4811

DATED 6-24-81
REVISED 7-8-81

SCALE 1" = 20 FEET
LEGEND
O ~ IRON PIPE FOUND
X ~ RECORDED AS IRON PIPE NOT FOUND
() ~ RECORDED AS
□ ~ LATH SET ON WESTERLY LINE LOT 14
NOTE ~ PIPE IS UNDER BLKTOP DRIVE
△ ~ SEPTIC VENT STACK