

# PLAT OF SURVEY

## LOTS 26, 27 AND PART OF LOT 28 OF BLOCK 1 OF THANSLAND, A SUBDIVISION

LOCATED IN PART OF THE SW 1/4 OF THE NE 1/4  
OF SECTION 35, TOWN 4 NORTH, RANGE 16 EAST,  
TOWN OF LAGRANGE, WALWORTH COUNTY, WISCONSIN

RECEIVED  
JUN 28 2018  
By *DMC*


BEARING BASIS S. LINE LANDS SURVEYED  
N 88°52'53" E

**PLAT OF SURVEY**  
W5473 ROCKY ROAD  
ELKHORN, WI 53121

WORK ORDERED BY -  
MIKE CORNELL  
1148 ILLINOIS ROAD  
WILMETTE, IL 60091

**FARRIS, HANSEN & ASSOCIATES, INC.**  
ENGINEERING - ARCHITECTURE - SURVEYING  
7 RIDGWAY COURT P.O. BOX 437  
ELKHORN, WISCONSIN 53121  
OFFICE: (262) 723-2088 FAX: (262) 723-5886

REVISIONS	
PROJECT NO.	9969
DATE:	06/05/2018
SHEET NO.	1 OF 1

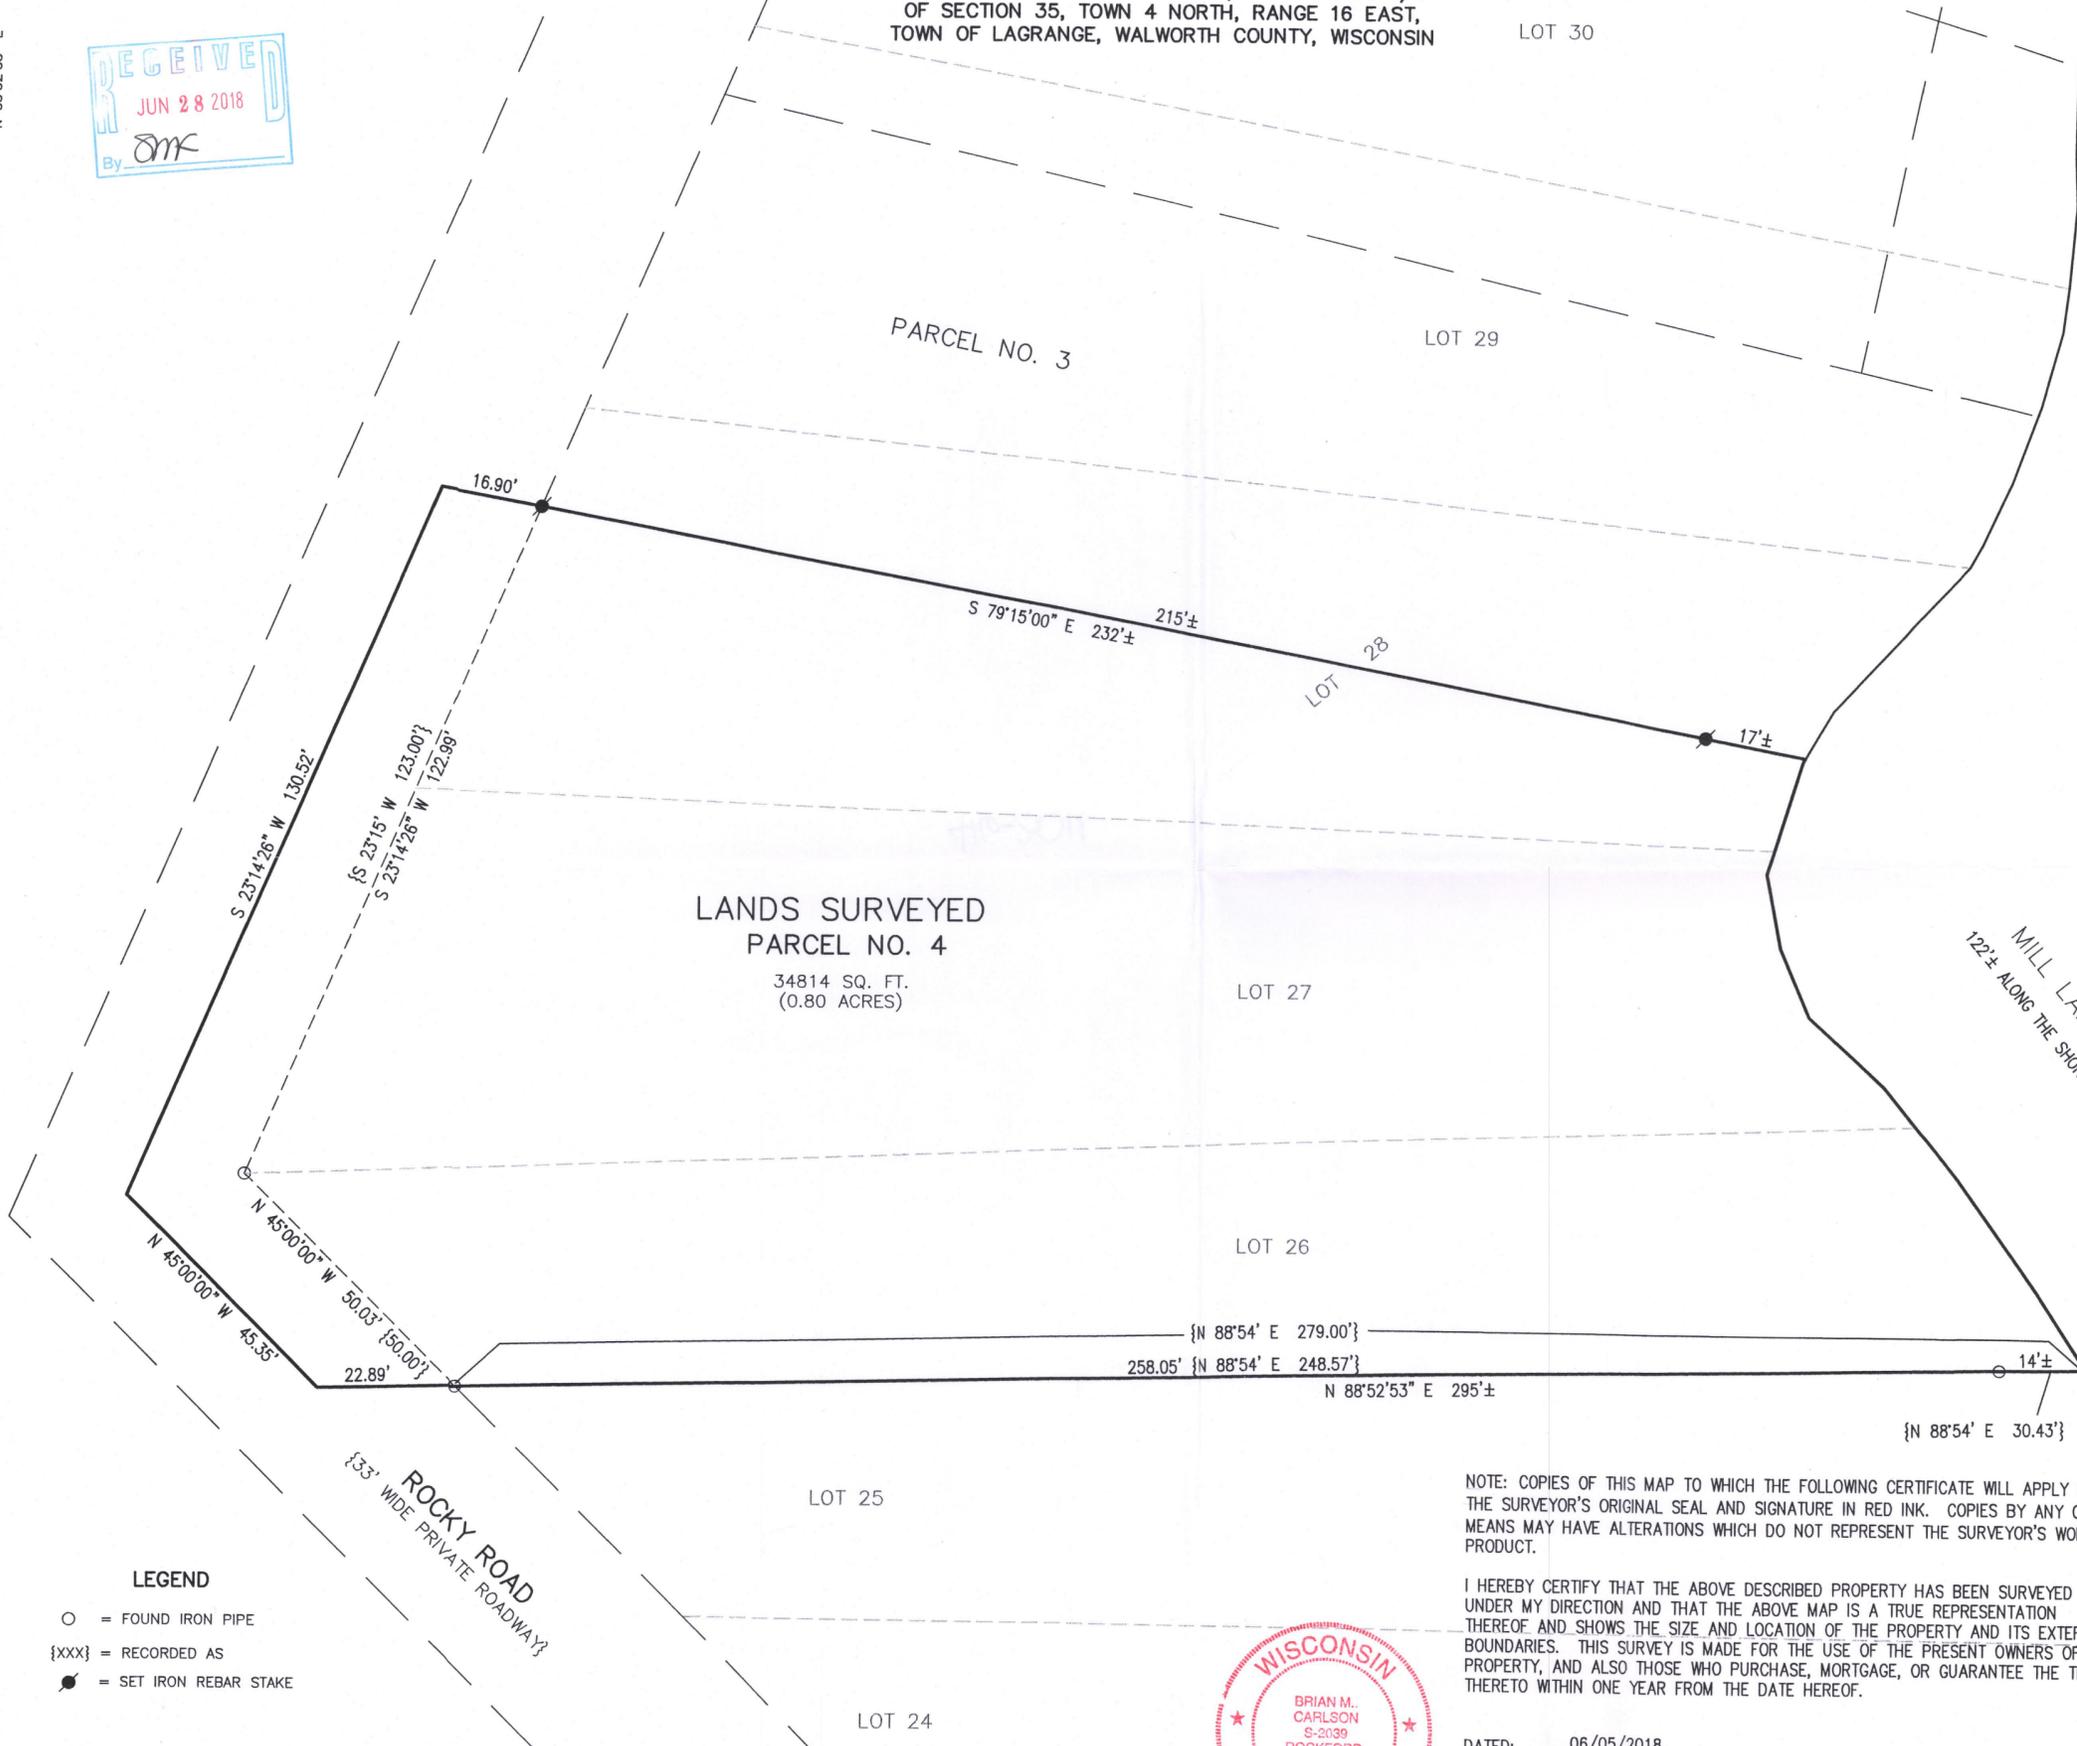

JUN 19 2018

X:\PROJECTS\9969\ACAD\9969.DWG

HTL-11B

416-3011