


THE SOUTH LINE OF LOT 21
WAS ASSUMED TO BEAR S85°04'E
AS ORIGINALLY RECORDED


FARRIS, HANSEN & COOPER, INC.

ENGINEERING, SURVEYING AND LAND PLANNING
715 W. WALWORTH ST. - P.O. BOX 487 - ELKHORN, WI 53121
OFFICE: 414/723-2028

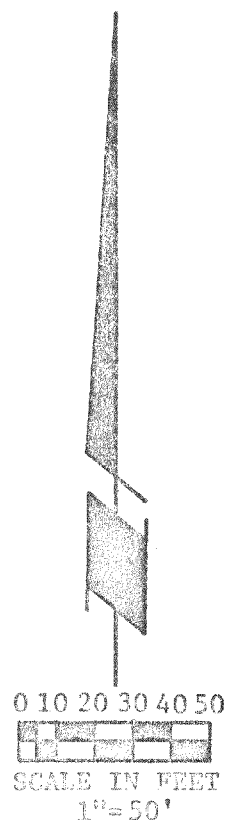

LEGEND


- Iron Pipe
Found 1 1/4" O.D.±
- Iron Conc. Re-Bar Found
1 1/2" Dia.±
- Record Dimension
- 352—Measured Dimension

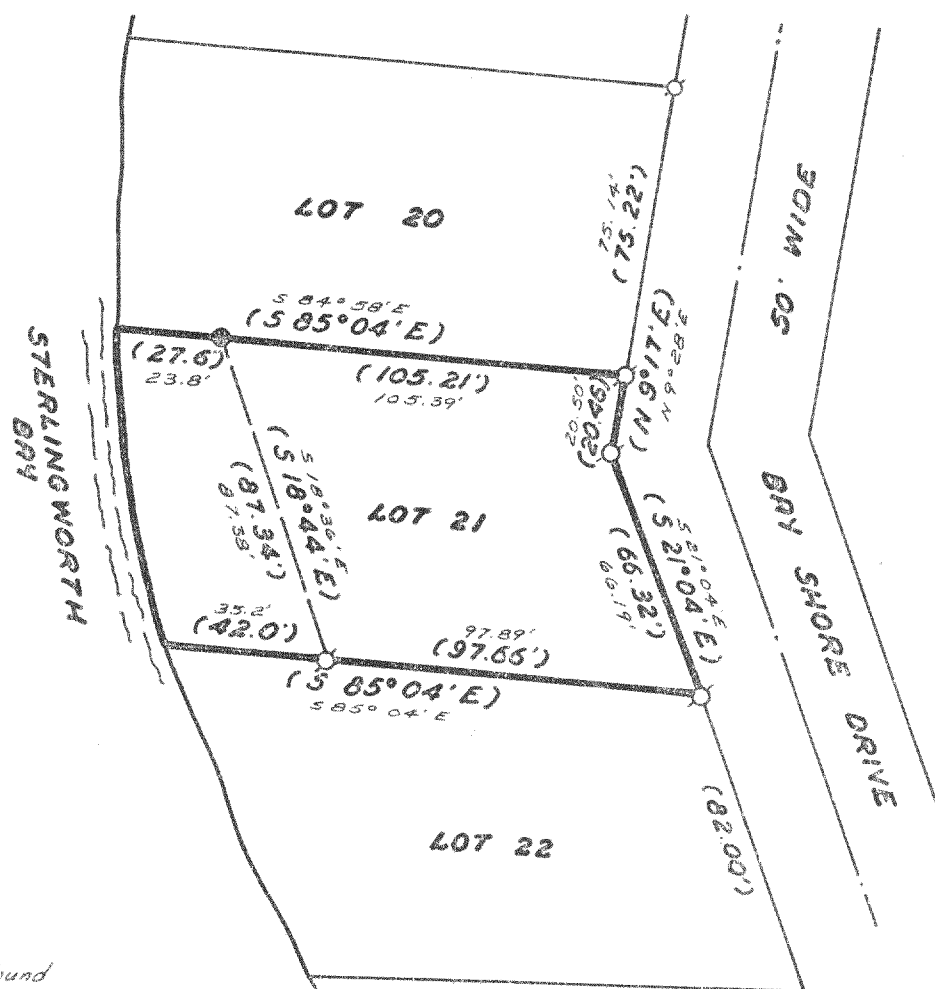

PLAT OF SURVEY OF

Lot 21, Block 1, Bay View Manor, a subdivision located in the Northwest 1/4
of Section 36, Town 4 North, Range 16 East, Town of La Grange, Walworth County,
Wisconsin.

ORDERED BY: Angie Stenstrom--Colony Realty

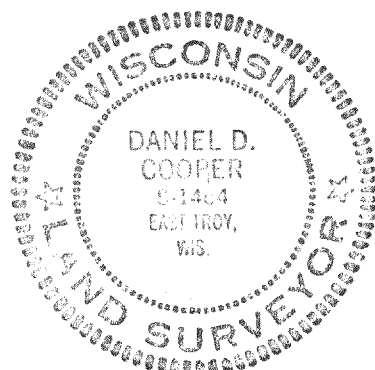

I HEREBY CERTIFY that I have surveyed the lands
described hereon and that this Plat of Survey is a
true and accurate representation of the lot lines
to the best of my professional knowledge and belief.

Daniel D. Cooper
Daniel D. Cooper, Reg. Land Surveyor, S-1464

5 TH May 1979
Date

PROJECT NO. 1511

48-21

416-302 F