



PLAT OF SURVEY OF

LOTS 13 AND 14 OF SOUTHMOOR SUBDIVISION, LOCATED IN
THE SE 1/4 OF THE SW 1/4 AND THE SW 1/4 OF THE SW 1/4 OF
SECTION 25, T4N, R16E, WALWORTH COUNTY, WIS.

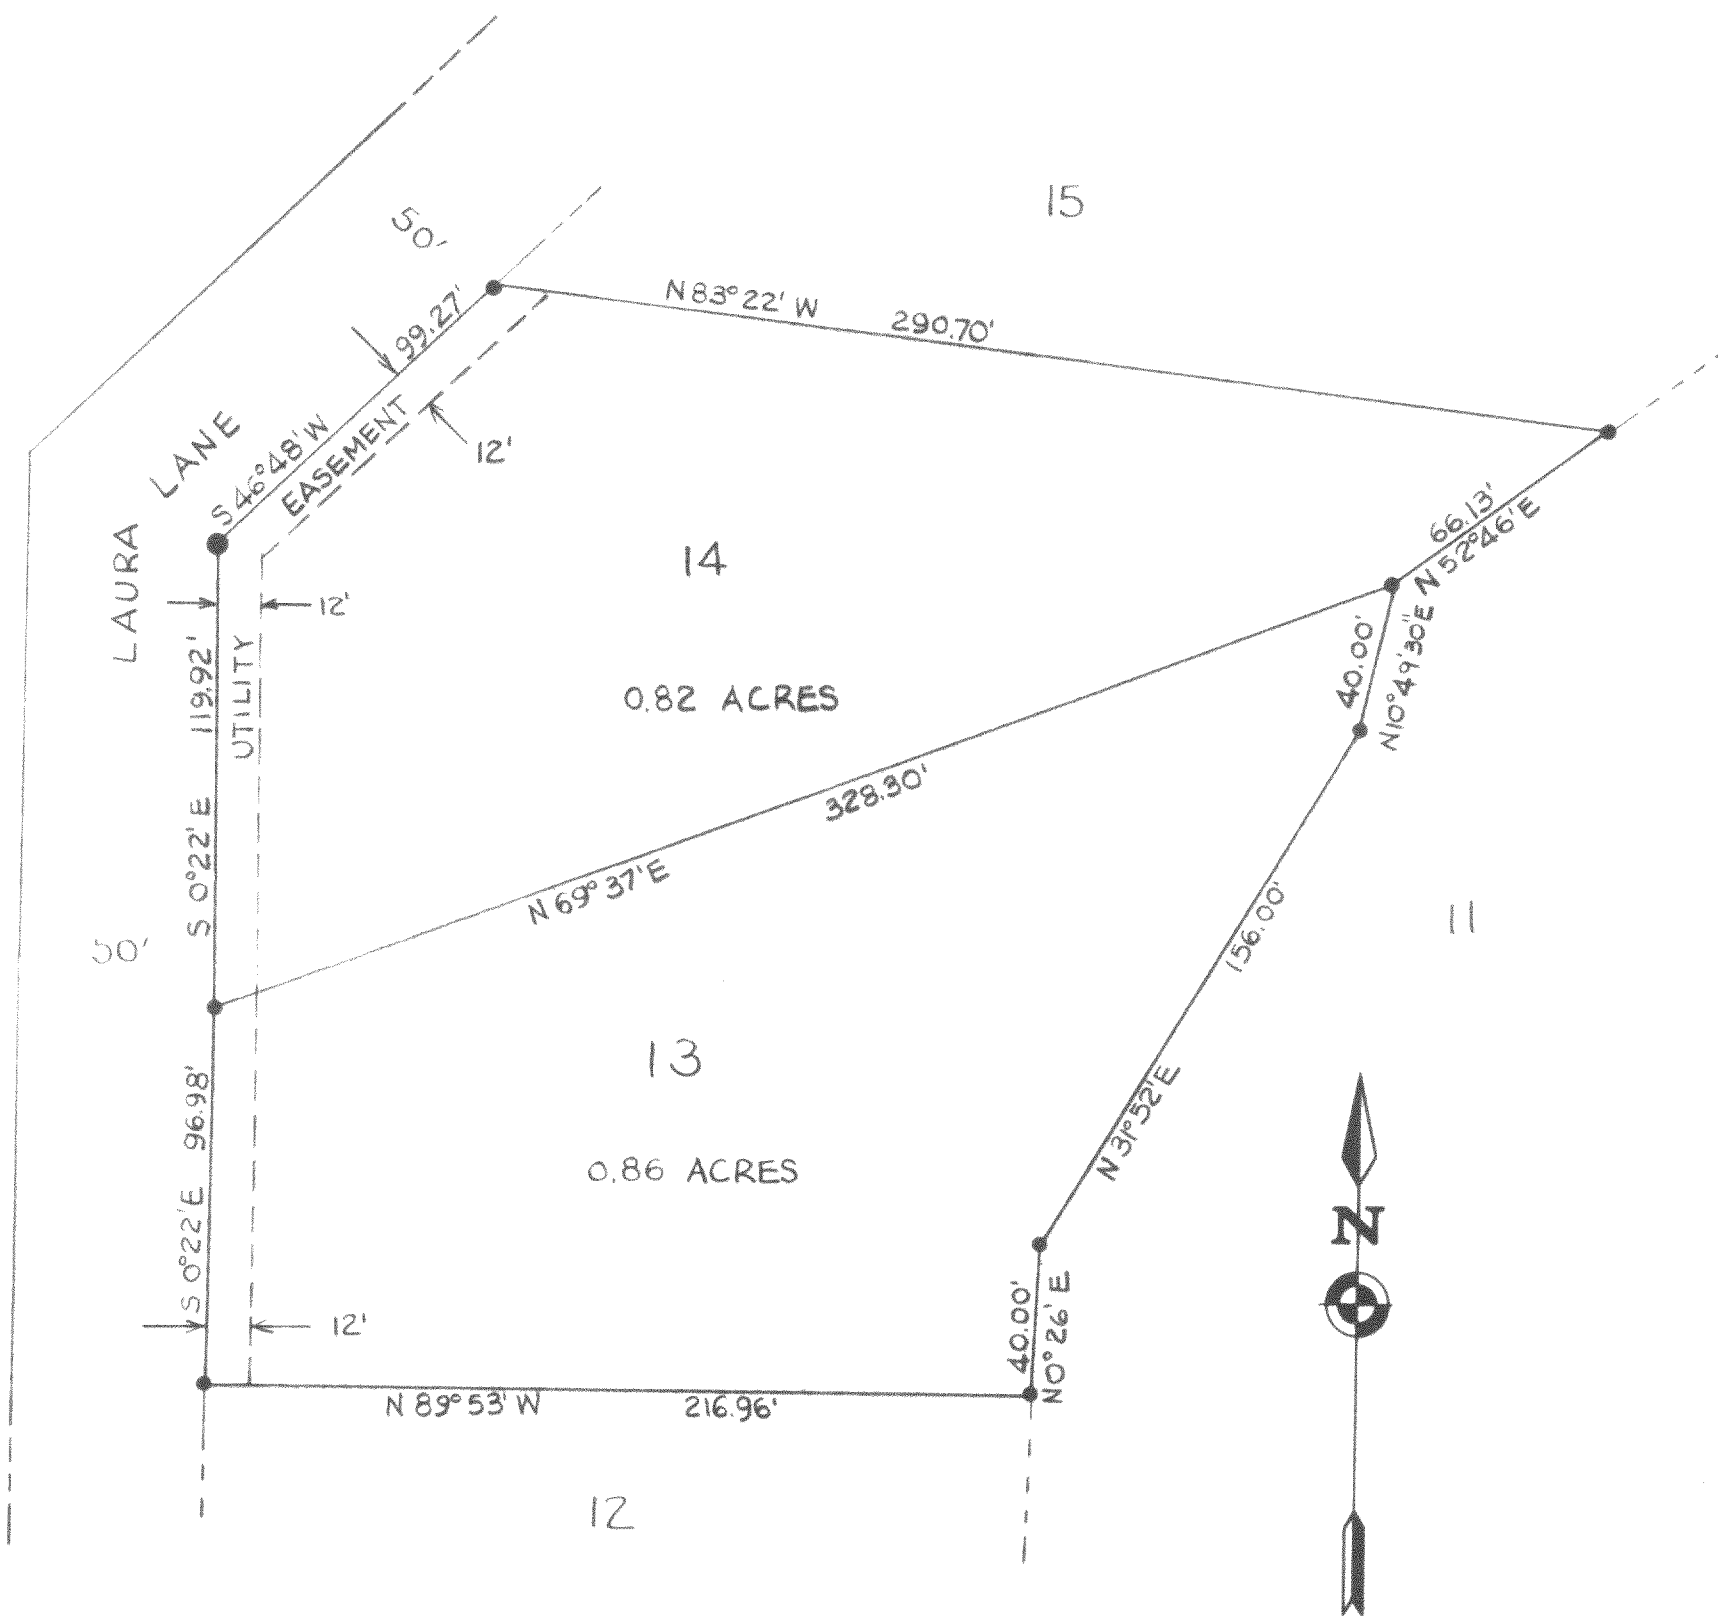

SURVEYED FOR
GOOFREY CO.
1200 W. SUNSET DR.
WAUKESHA, WIS. 53186
ATTN: MR JACK VOIGT

I HEREBY CERTIFY THAT I HAVE SURVEYED THE ABOVE DESCRIBED PROPERTY
ACCORDING TO THE RECORDED SUBDIVISION PLAT
OCTOBER 8, 1982

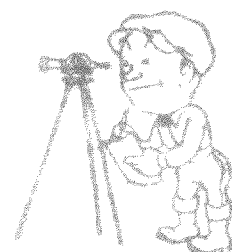


Thomas P. A. Jensen
THOMAS P. A. JENSEN S-1084

JENSEN SURVEYING AND MAPPING, S.C.

P.O. BOX 322
ELKHORN, WIS. 53121
414-723-3434

SCALE 1"=50'
LEGEND

- ~ 3/4" DIA. IRON ROD FOUND
- ~ 1 3/16" DIA. IRON ROD FOUND

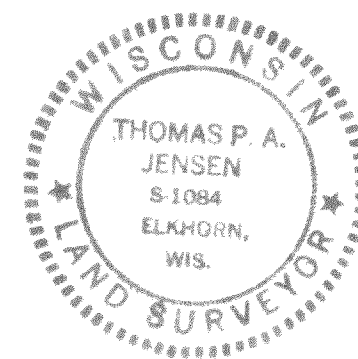

1982.036

ASM-13.14

416-304-J