


PLAT OF SURVEY

That part of Lot 5 of Lauderdale Park Subdivision, Town of LaGrange, Walworth County, Wisconsin, located North of the Road as shown on Plat of Survey on file at the Office of the Walworth County Surveyor as survey number 4463.

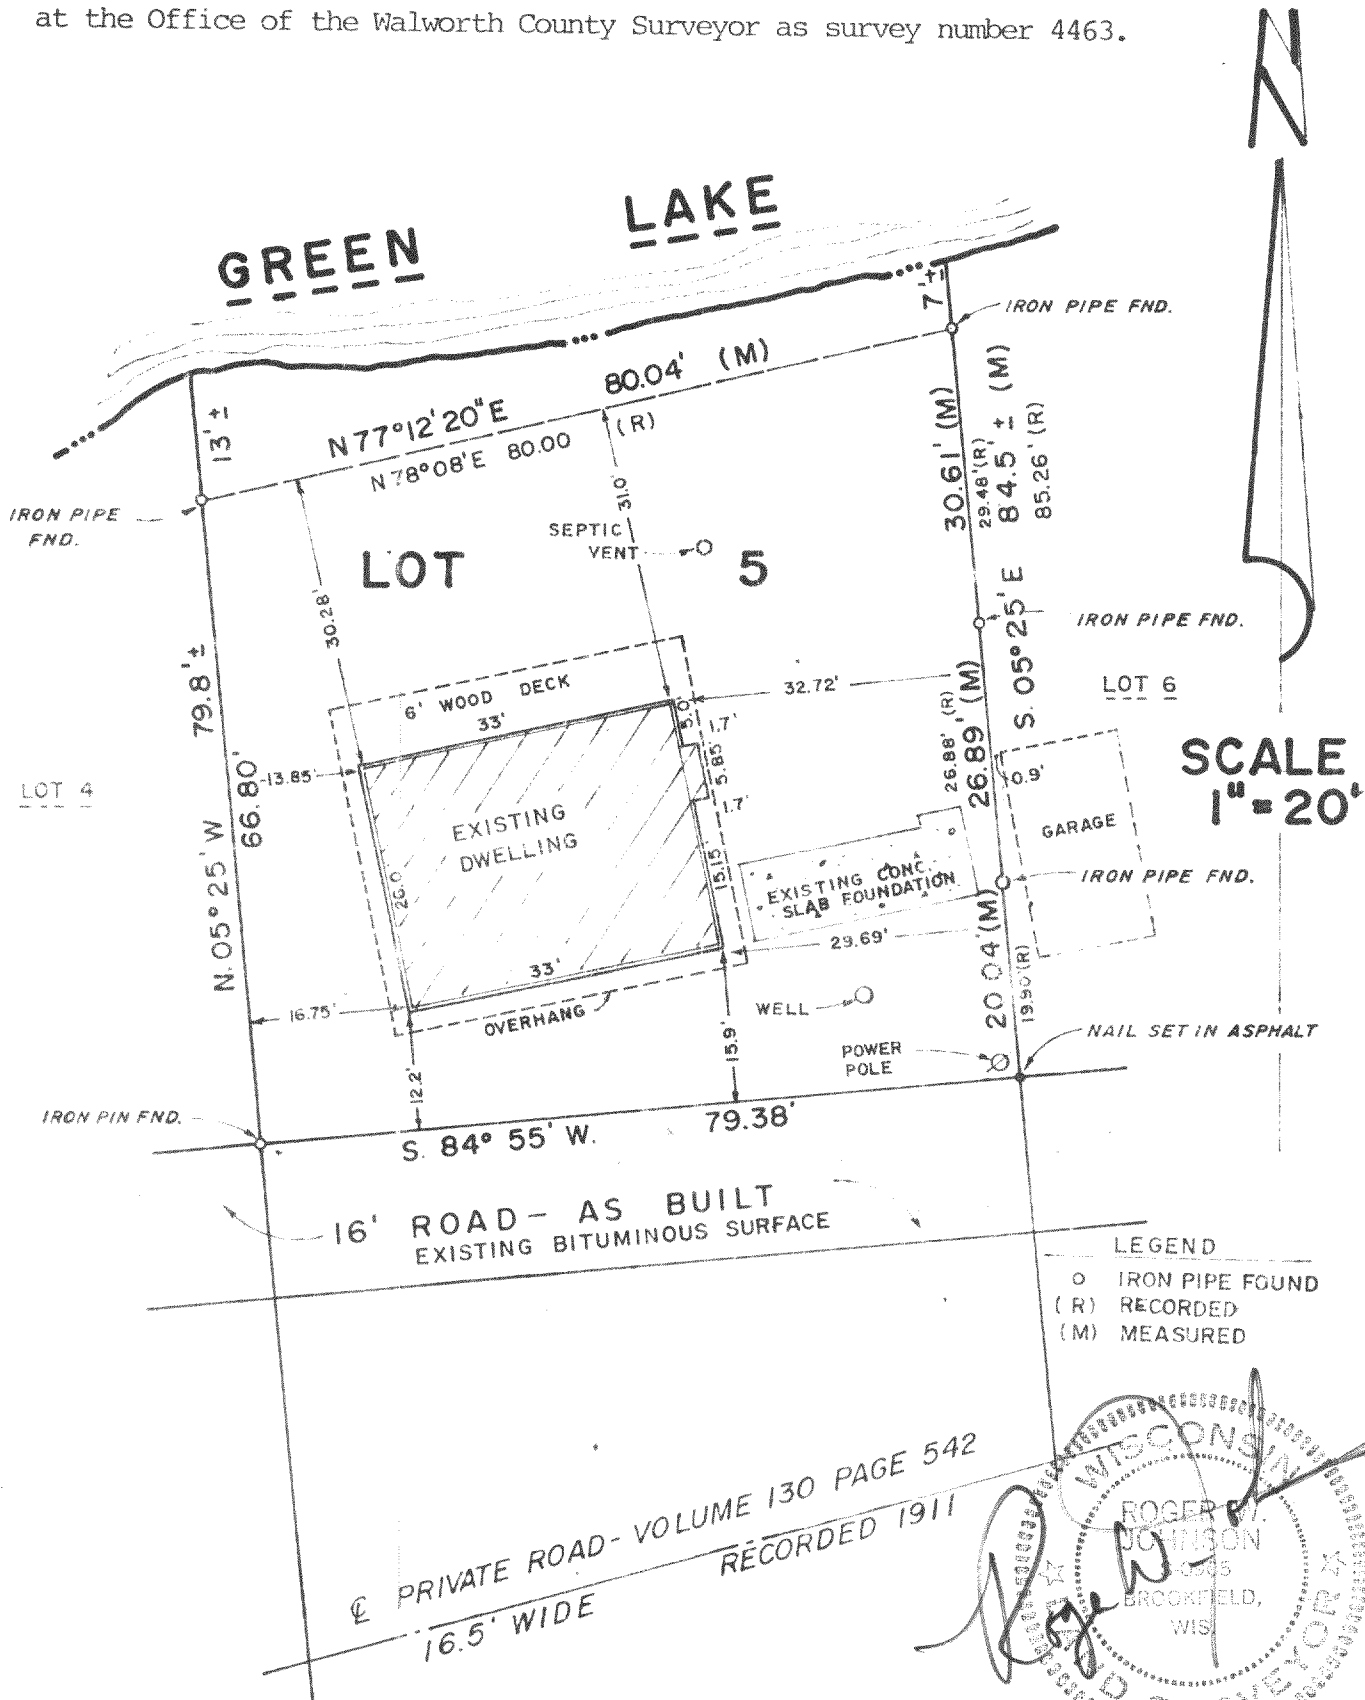

"I have surveyed the above described property, and the above map is a true representation thereof and shows the size and location of the property, its exterior boundaries, the location and dimensions of all structures thereon, fences, apparent easements, roadways and visible encroachments.

This survey is made for the exclusive use of the present owners of property; also those who purchase, mortgage, or guarantee the title thereto, within one year from date hereof, and as to them I warrant the accuracy of said survey and map."

Dated this 14th day of August, 1980.

Roger W. Johnson, 2120 W. Clybourn St., Milwaukee, WI 53233 Telephone: 933-9220

416-308