


I CERTIFY THAT I HAVE SURVEYED THE ABOVE DESCRIBED PROPERTY ACCORDING TO THE OFFICIAL RECORDS & THE HEREON MAP IS A CORRECT REPRESENTATION THEREOF.

OWNER: Ken Roben
209 Kathleen Dr.
ELGIN, ILL.
60120

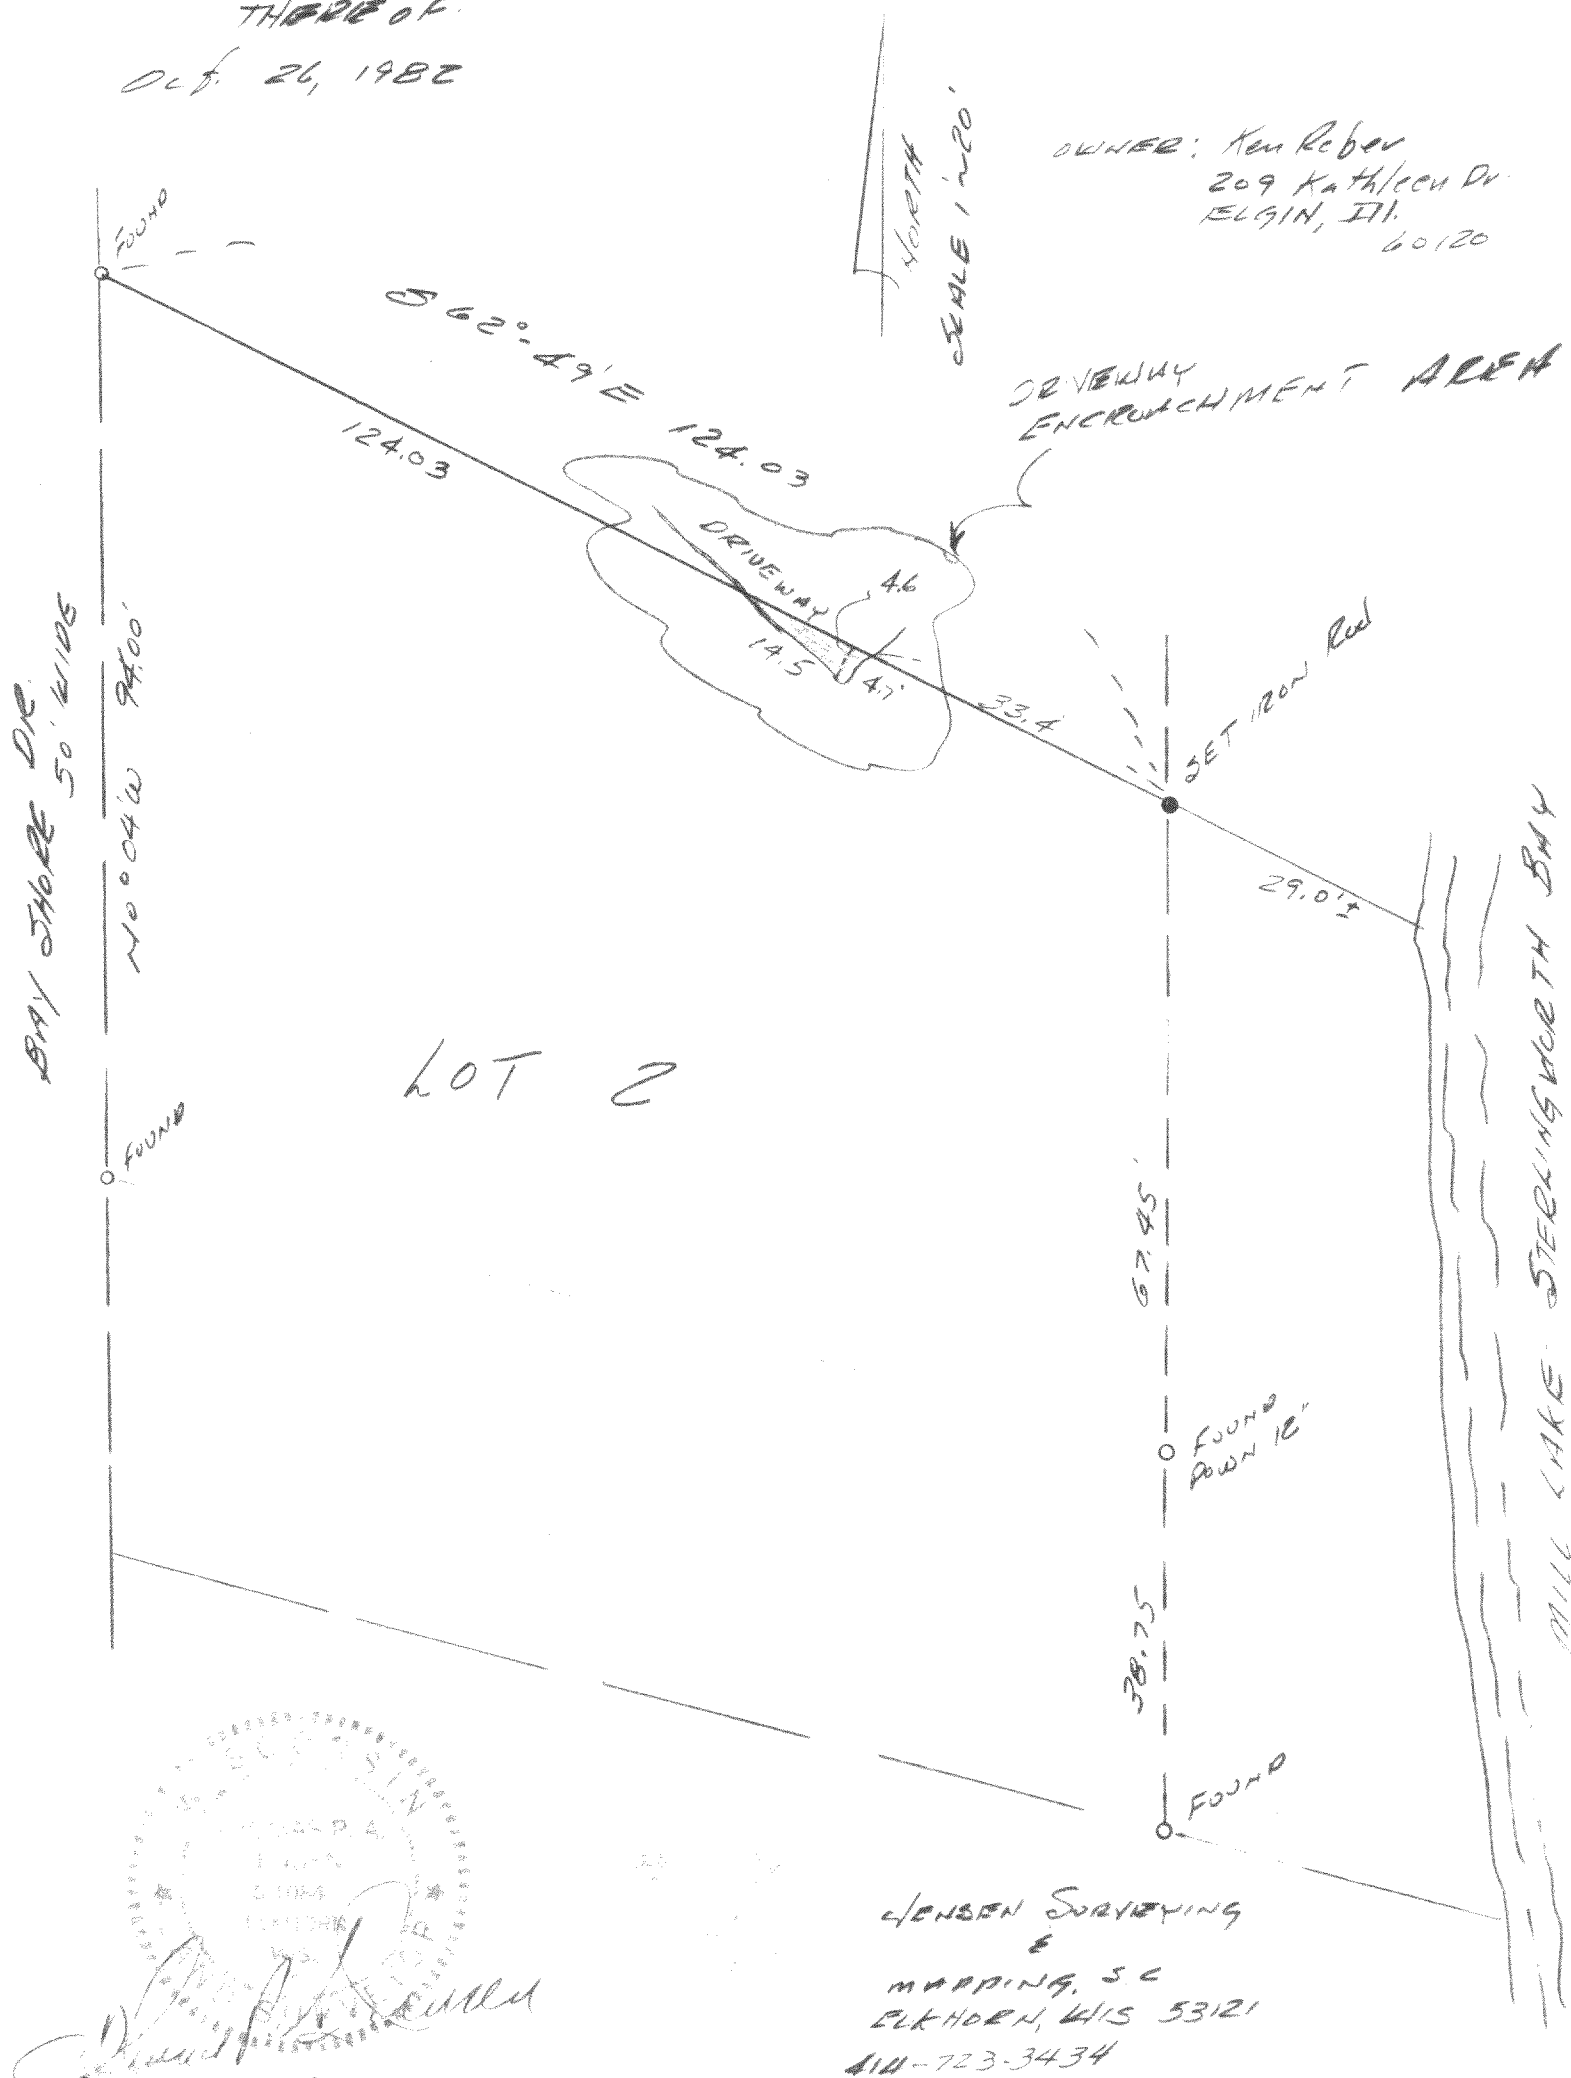

CLENSEN SURVEYING
E
MAPPING, SC
ELKHORN, WIS 53121
414-723-3434

Q. 2.575 - Kline
also
Put on Lot 10, Blk 1 Bay View Manor

416-309-J