


PLAT OF SURVEY

OF LOT 18, MARINER HILLS SUBDIVISION, LOCATED IN PART OF
THE SE 1/4 OF THE SW 1/4 OF SECTION 34, T. 4 N., R. 16 E. OF THE 4TH
P.M., TOWN OF LAGRANGE, WALWORTH COUNTY, WISCONSIN.

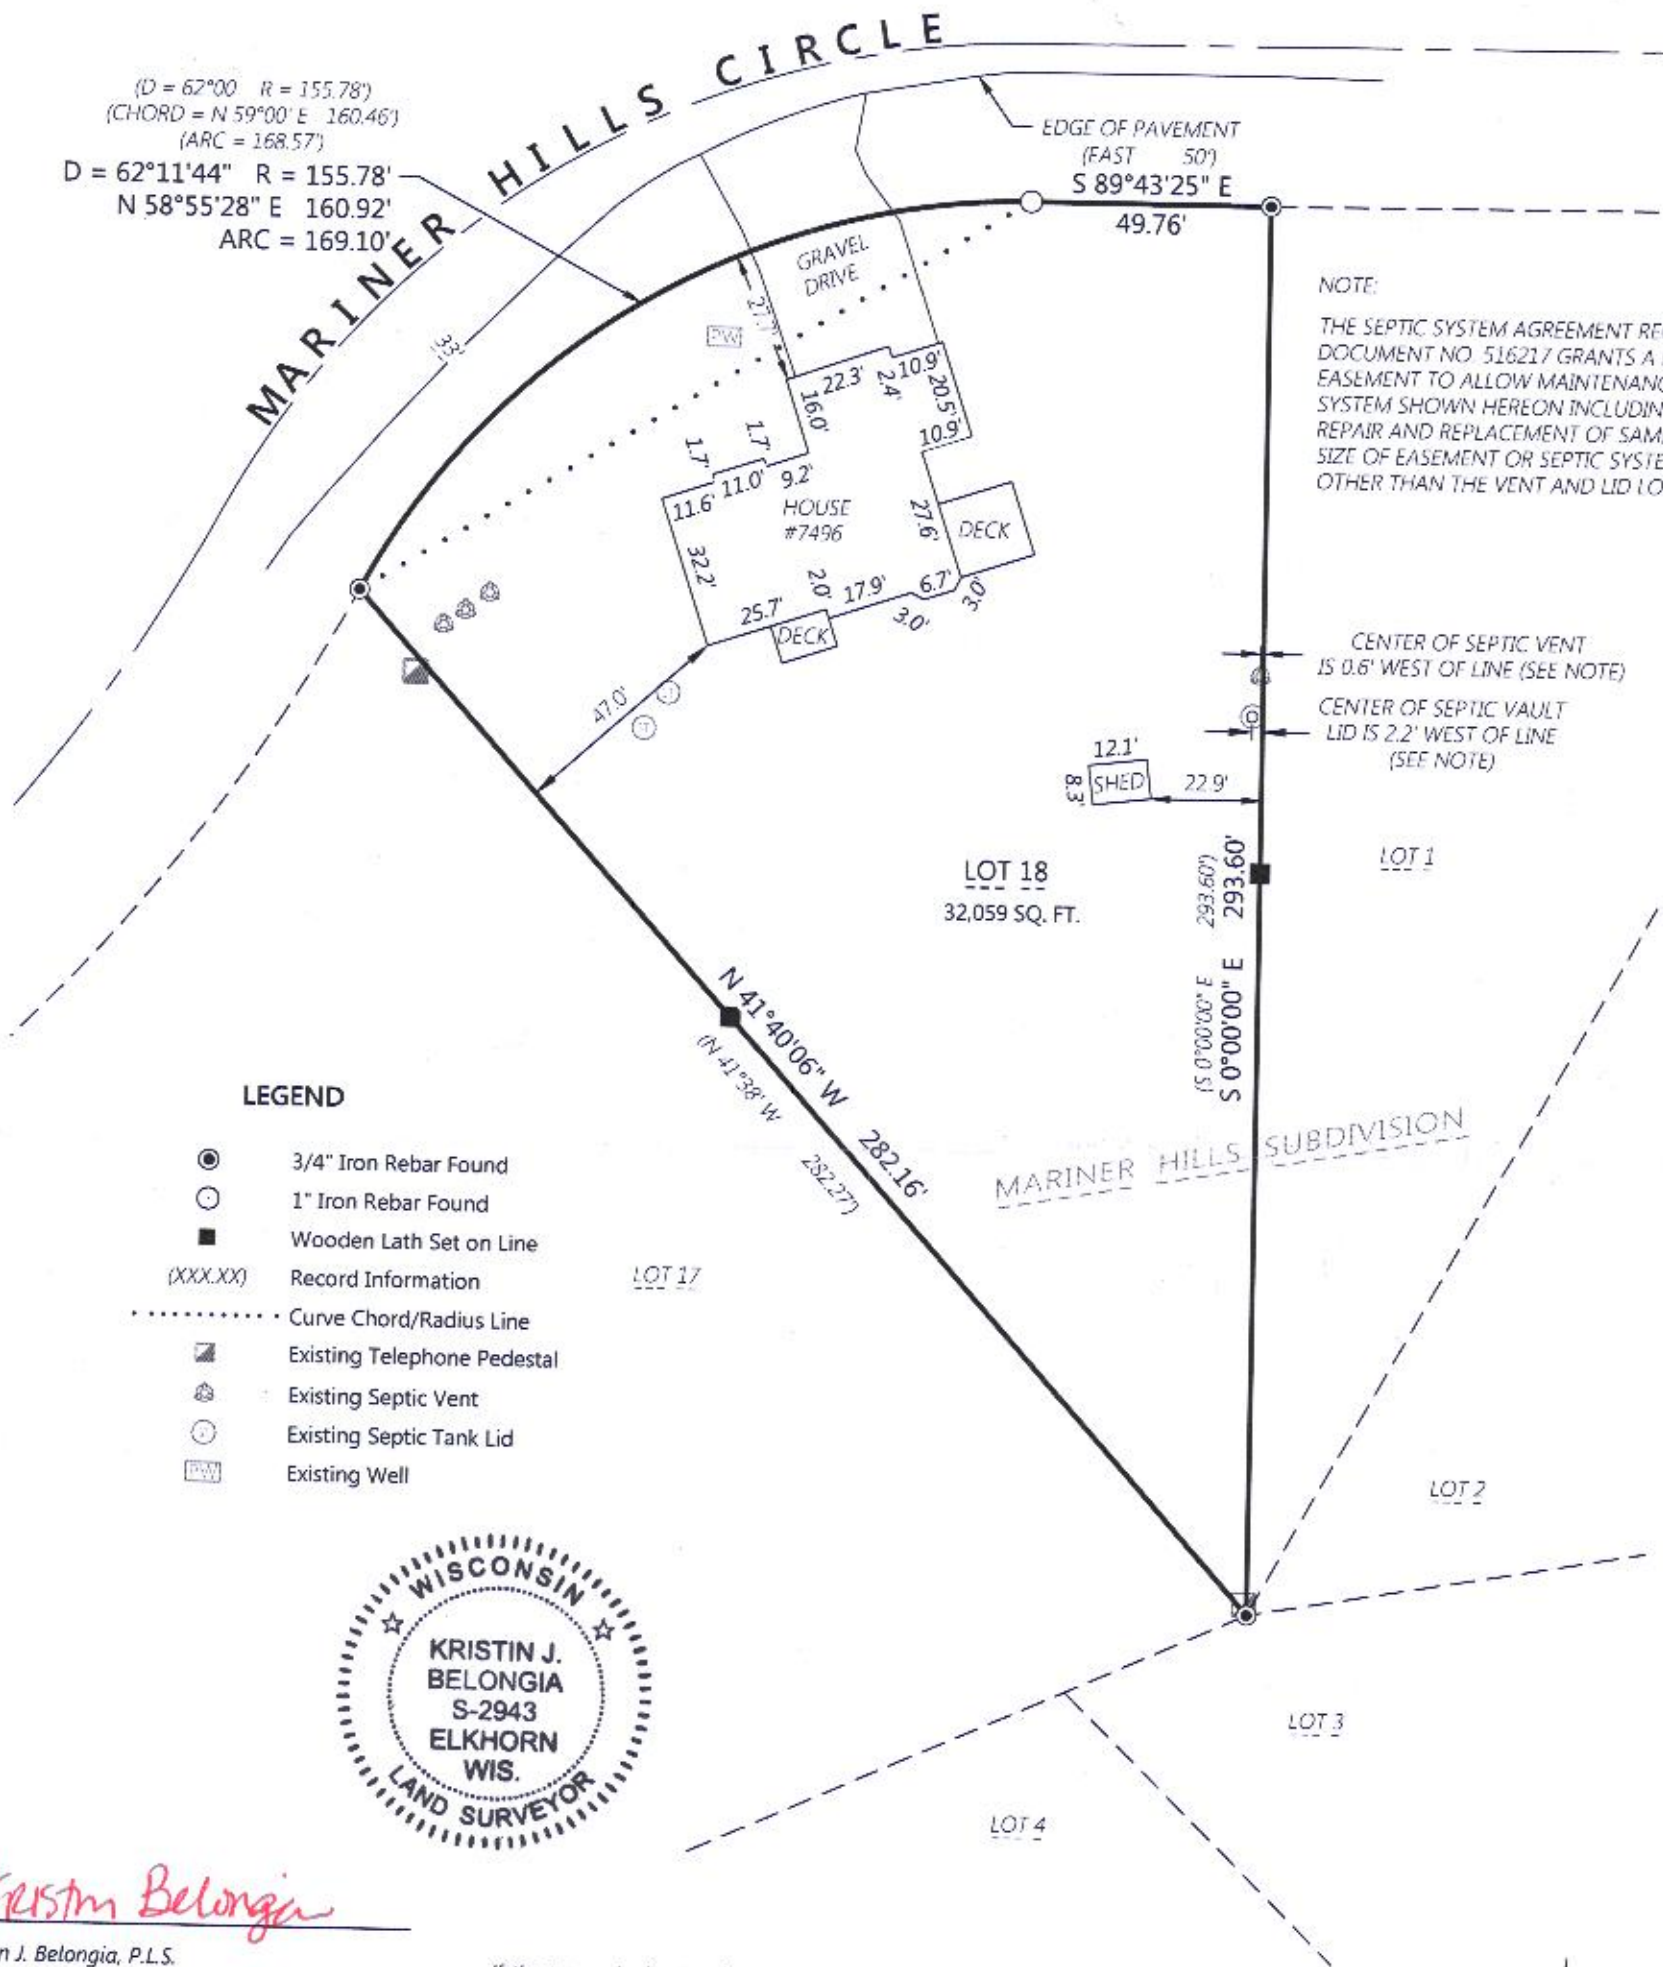

Kristin Belongia

Kristin J. Belongia, P.L.S.
Wisconsin Professional Land Surveyor S-2943

State of Wisconsin } ss
County of Rock

If the surveyor's signature is not red in color,
the plan is a copy that should be assumed to
contain unauthorized alterations.
The certification contained on this document
shall not apply to any copies.

I hereby certify that I have supervised the survey of the property described above and to the best of my knowledge and belief, the plat drawn hereon complies with Chapter A-E 7 of the State of Wisconsin Administrative Code, Minimum Standards for Property Surveys and correctly represents the size and location of the property, exterior boundaries, the location of all visible structures, and dimensions of all principle buildings thereon, fences, easements of record, and roadways, if any. This survey is made for the use of the present owners of the property, and also those who purchase, mortgage, or guarantee the title thereto within one year from the date hereof.

Given under my hand and seal this 9th day of May, 2019 at Beloit, Wisconsin
Last day of field work May 1st, 2019



ORDER NO: 33294

BOOK: SEE FILE
FIELD CREW: DGM
DRAWN BY: DGM
DATE: May 9, 2019

FOR THE EXCLUSIVE USE OF:
Andrew & Carol Dienerberger
N 7496 Mariner Hills Circle
Elkhorn, WI 53121

PLAT OF SURVEY

Batterman
engineers surveyors planners
2857 Bartells Drive Beloit, Wisconsin 53511
608.355.4464 www.rhbatterman.com



HMH-18 416-3104