


PLAT OF SURVEY OF LOT 14, BLOCK 13, COOL HILL PARK ADDITION NO. 2


LOCATED IN THE SE 1/4 OF THE SE 1/4 OF SECTION 34 T4N
R16E TOWN OF LA GRANGE AND IN THE NE 1/4 OF THE NE 1/4
OF SECTION 3, T3N R16E, TOWN OF SUGAR CREEK,
WALWORTH COUNTY WISCONSIN

I CERTIFY THAT I HAVE SURVEYED THE DESCRIBED PROPERTY AND THAT
THE PLAT SHOWN HEREIN IS AN ACCURATE SURVEY AND A TRUE
REPRESENTATION THERE OF & CORRECTLY SHOWS THE BOUNDARY LINES
OF SAID PROPERTY & ALL BUILDINGS THEREON.

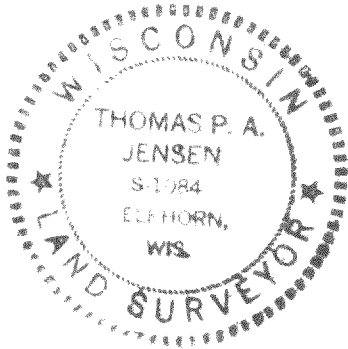

Thomas P. A. Jensen
THOMAS P. A. JENSEN S-1084
JENSEN SURVEYING & MAPPING
P.O. BOX 322
ELKHORN WISCONSIN

MAY 10, 1980

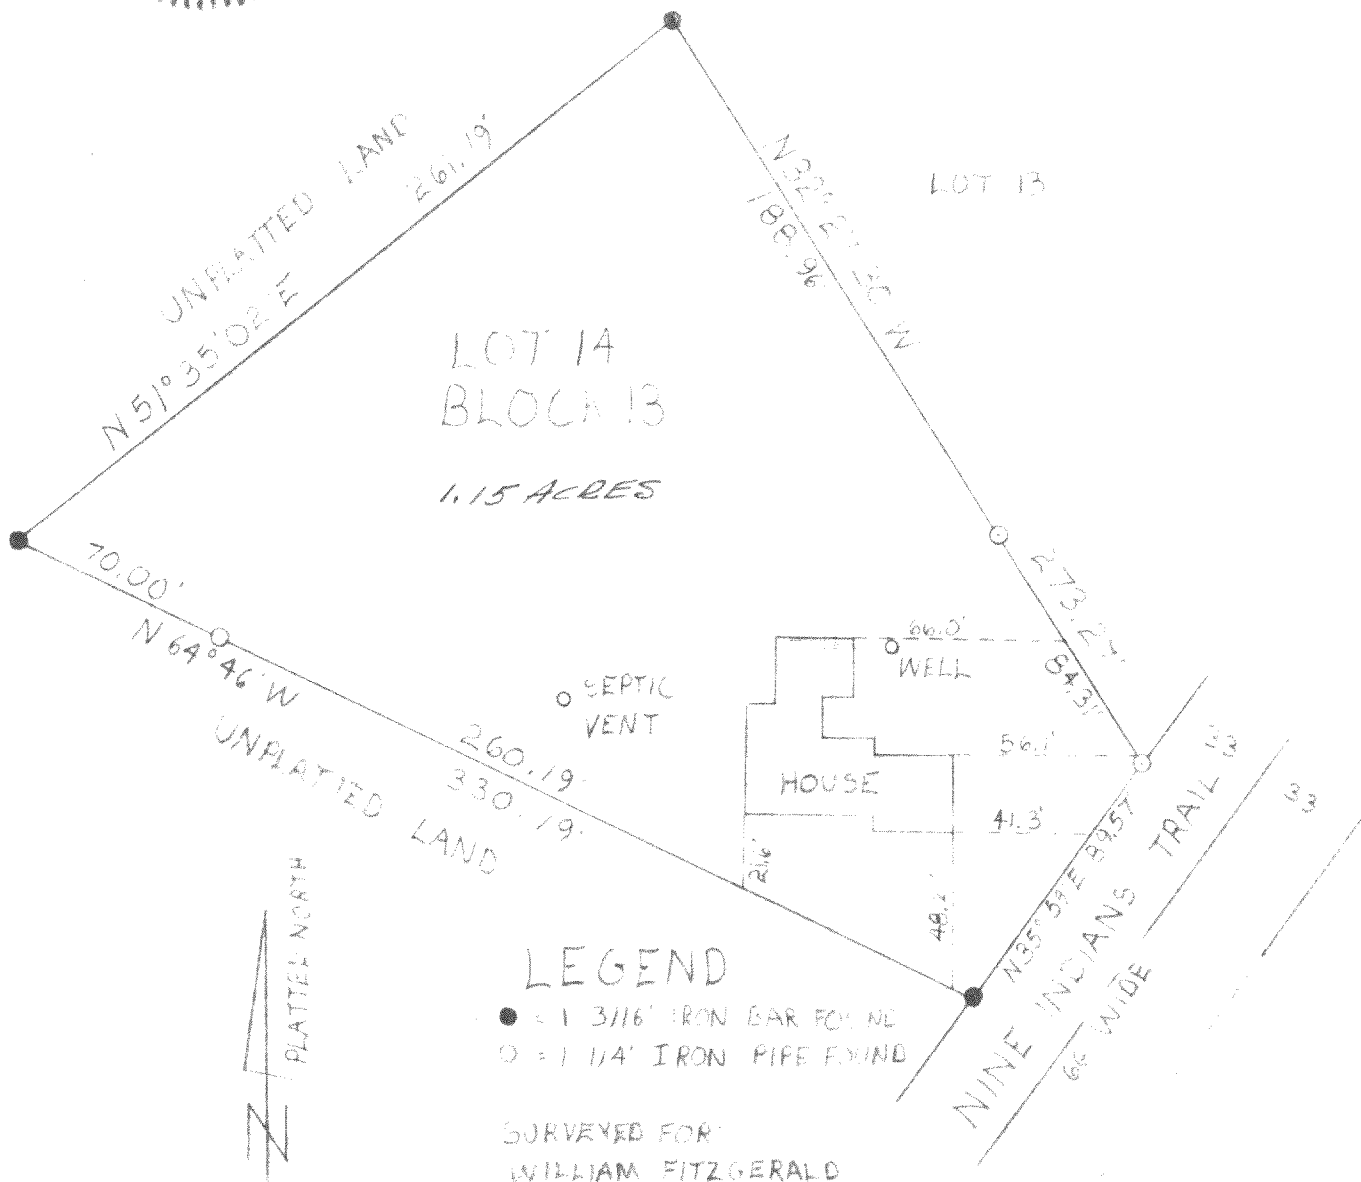

SCALE 1" = 60'

SURVEY ORDERED BY:
D.C. STEPHANI
678 MAIN ST
GLEN ELEM, ILL. 60137