



FARRIS, HANSEN & ASSOC
715 W. WALWORTH ST., BX. 487
ELKHORN, WI. 53121 723-2098

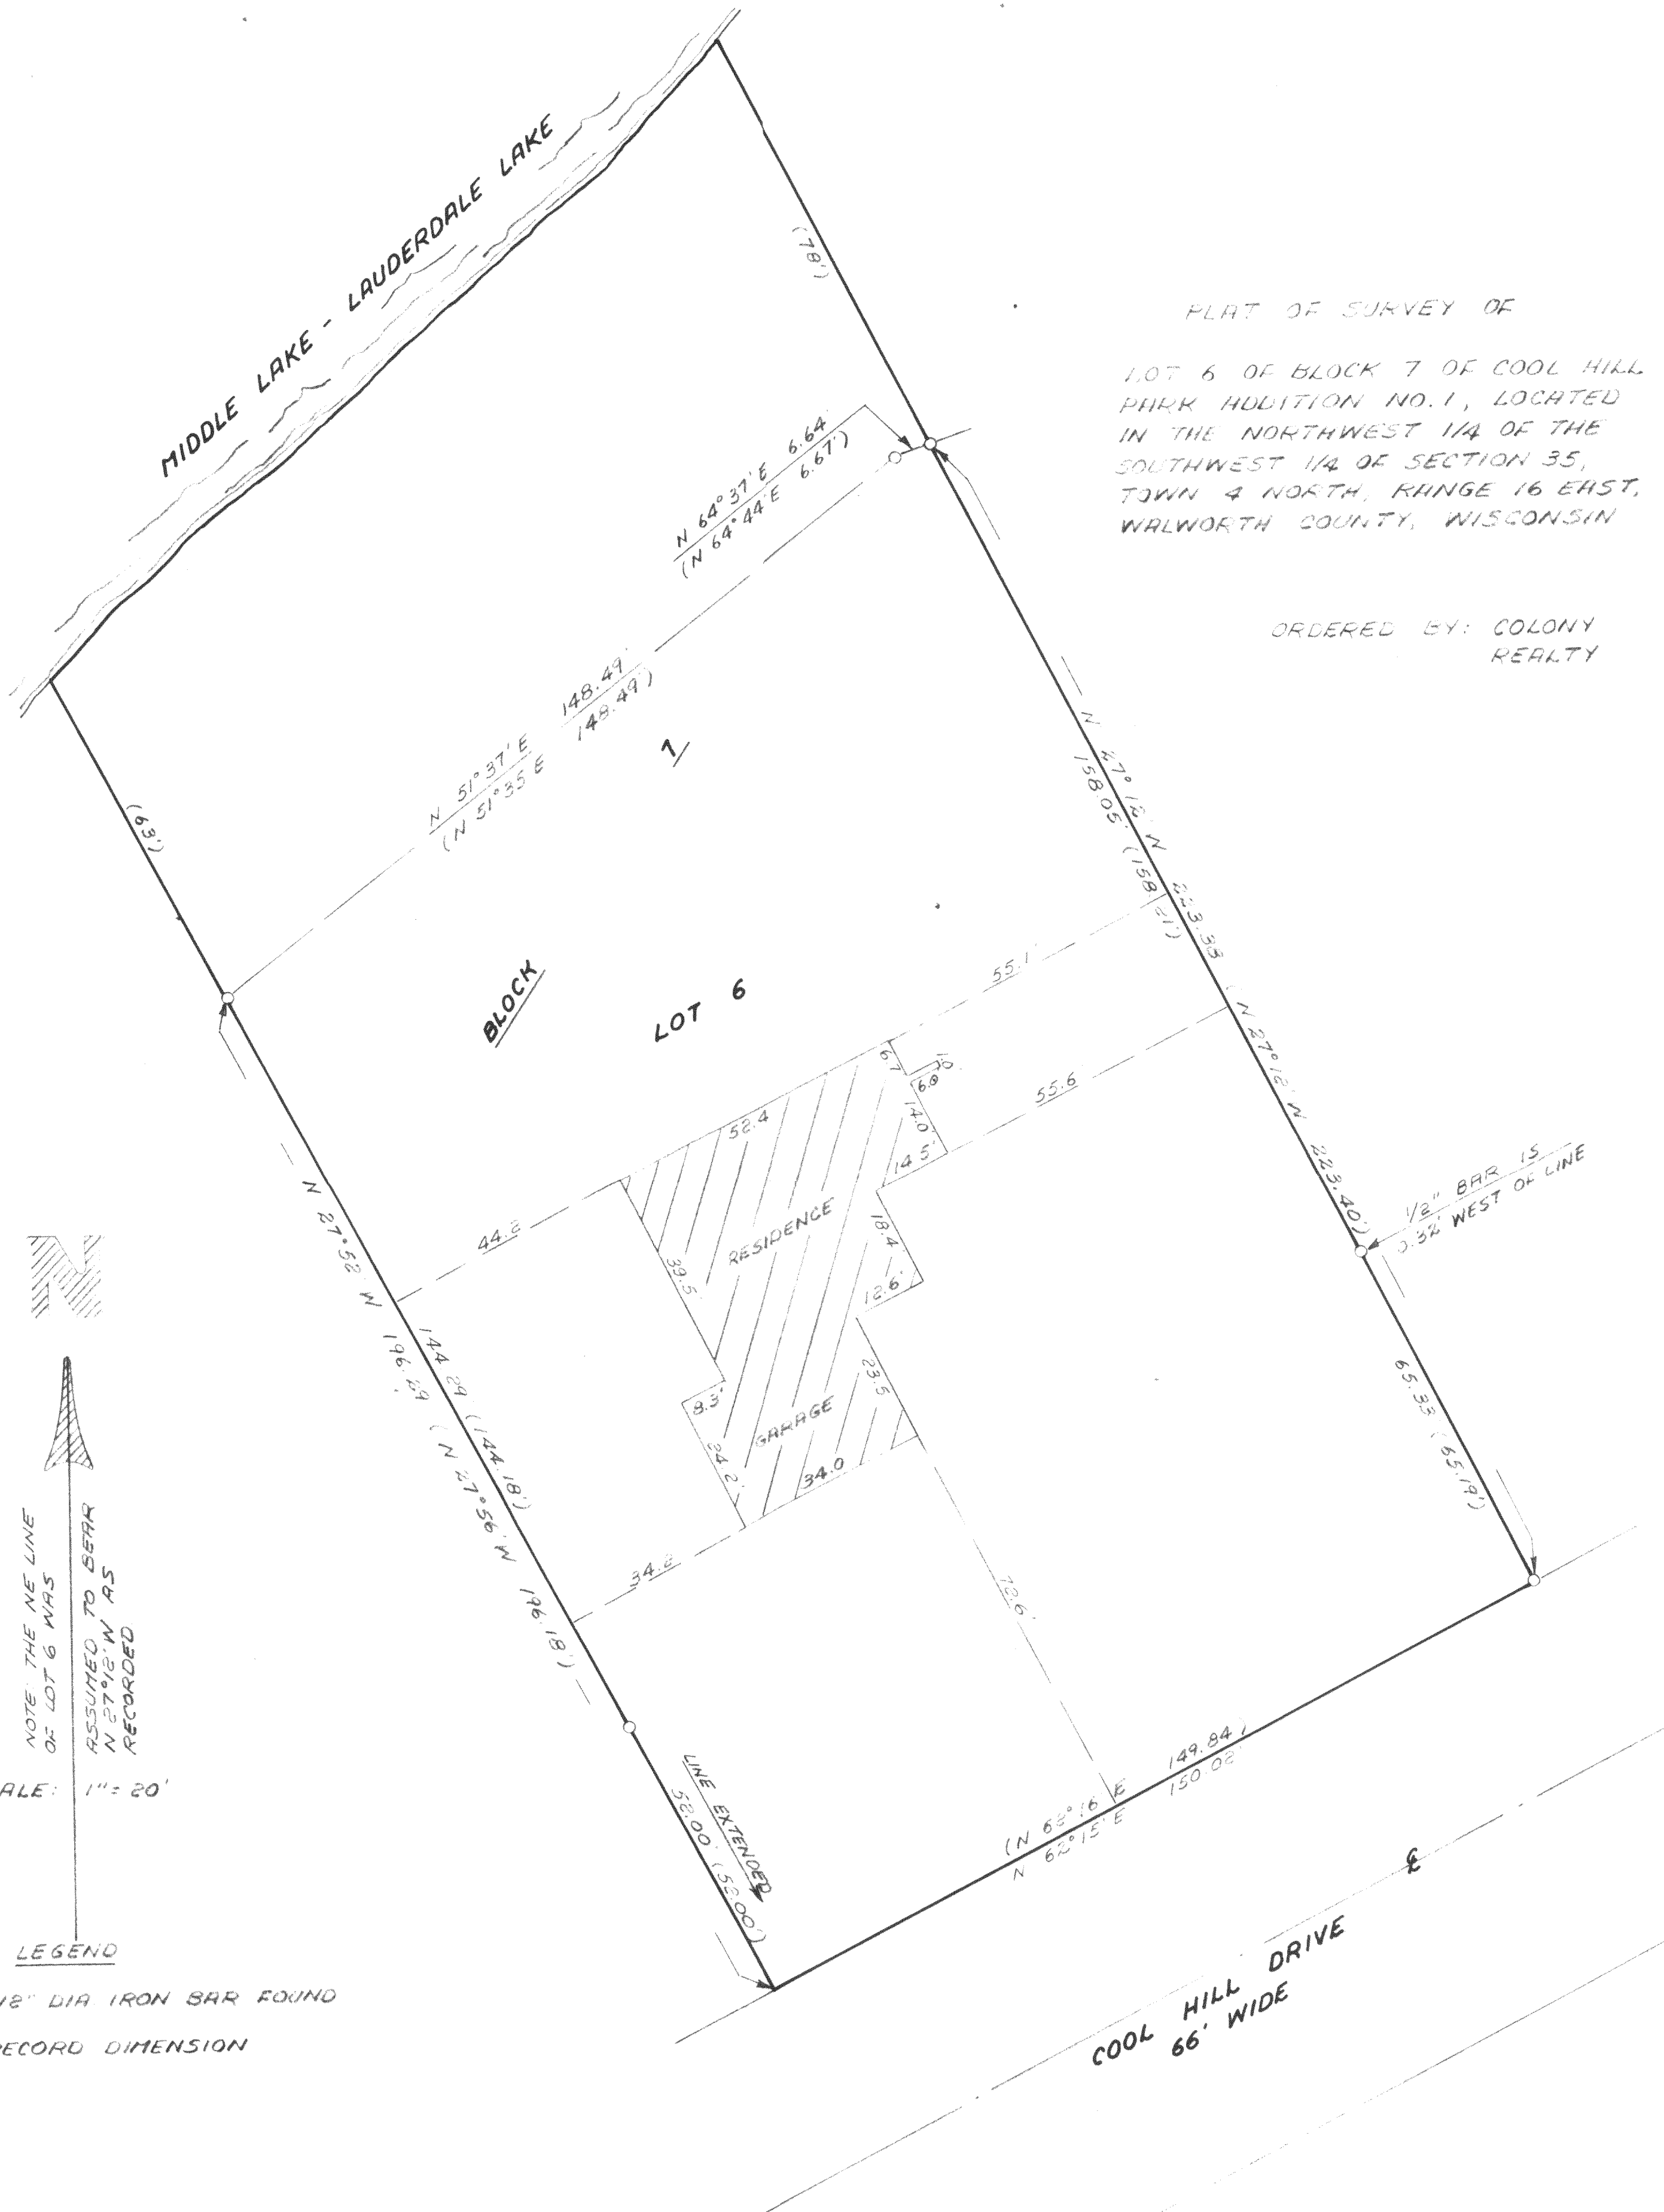

I HEREBY CERTIFY THAT THIS PLAT
OF SURVEY IS A TRUE AND ACCURATE
REPRESENTATION OF THE LOT LINES,
AND THE BUILDING LOCATED THEREON,
TO THE BEST OF MY PROFESSIONAL
KNOWLEDGE AND BELIEF

ROBERT A. FARRIS, RLS NO. 1293
DATED THIS 11th DAY OF July, 1983.

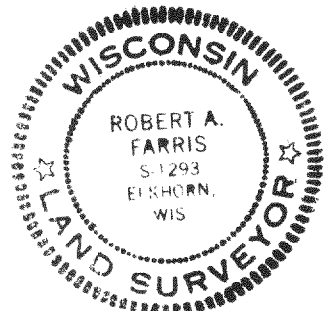

PROJECT NO. 2129

416-314-F