


DUNHAM SURVEYING, S.C.
SURVEYING & SUBDIVIDING
DELAVER, WISCONSIN 53115

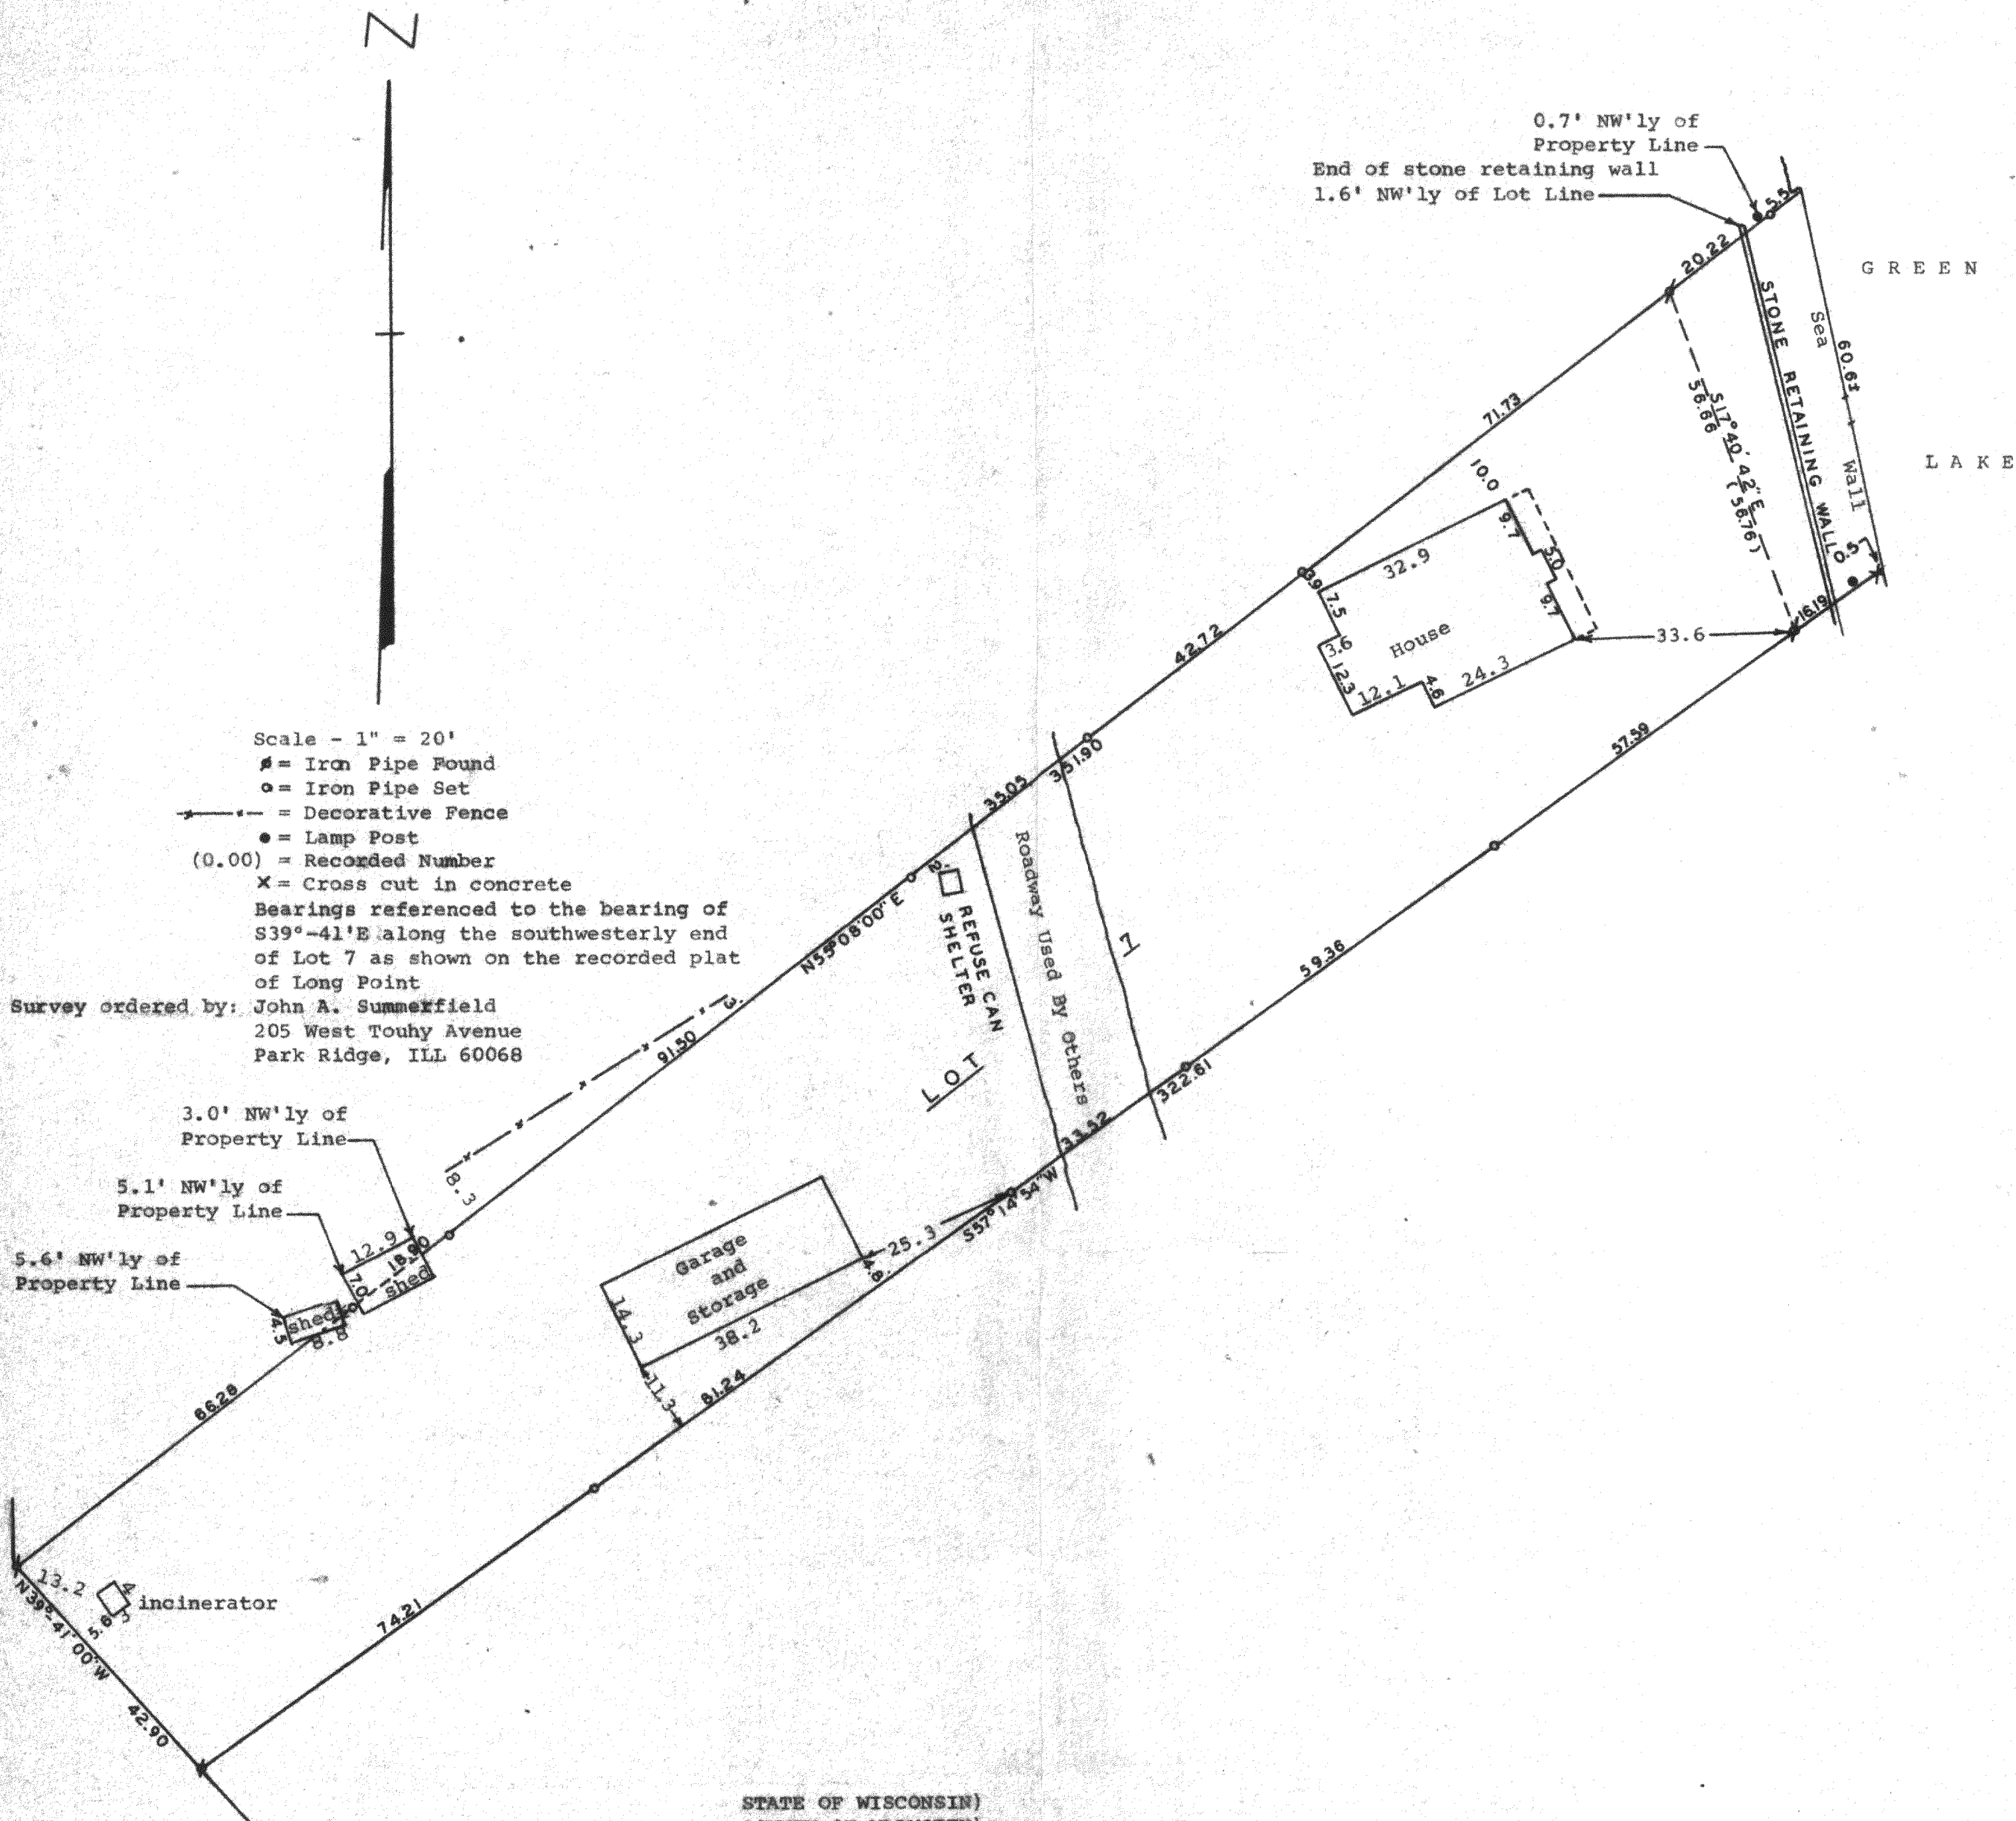


STATE OF WISCONSIN)
COUNTY OF WALWORTH)

I, George T. Dunham, Surveyor, certify that I have surveyed the property described as follows:

Lot 7 in what is known as Long Point situated on Lot 7 or the East ½ of the Southeast Fractional ¼ of Section 26, T 4 N, R 16 E, according to a plat of said Long Point on record in the office of the Register of Deeds in and for Walworth County, Wisconsin in Volume 5 of Plats Page 66. Right of way and easement in common with others, as evidenced in Volume 68 of Mortgages at page 567, Walworth County Records, and that the above map is a true representation thereof and shows the size and location of the property, its boundaries, the location of all visible structures and dimensions of all principal buildings thereon, boundary fences, apparent easements, roadways and visible encroachments, if any.

This survey is made for the use of the present owners of the property, and also those who purchase, mortgage, or guarantee the title thereto within one (1) year from date hereof.
October 22, 1981

George T. Dunham
George T. Dunham, Surveyor

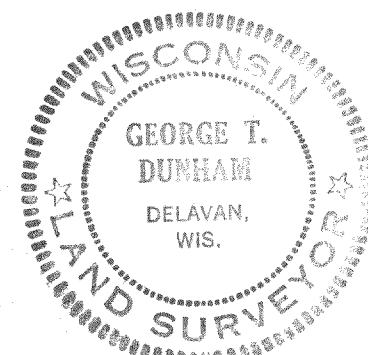

HLPN-3

416-315 D