

PLAT OF SURVEY  
OF

division"

EXISTING PUBLIC ROAD KNOWN  
LOST NATION DRIVE

N 70° 32' E

ASSUMED  
88.04 (88.22)

SW COR. LOT 16,  
BLOCK 2, CARSWELLE -  
PARK SUB.

NUMEROUS IRON  
PIPES SET ALONG  
THESE TWO LINES

PARCEL # 2

$N 58^{\circ} 44' E$   
 $(N 58^{\circ} 24' E$

### LEGEND

Q - IRON OBJECT UNDER PVT.

0 IRON PIPE FOUND

### 1. RECORD DIMENSION

WORK ORDERED BY:

OWNER VIRGINIA THOMAS


NORTH  
SCALE: 1" = 30'

FOUND PIPE GUARDED  
BY PAINTED STEEL  
FENCE POST ASSUMED  
TO BE MARKING  
LINE BET. LOT 34  
& LOT 35 OF BK 1  
OF THASLAND

DESCRIPTION:

Commencing at the SW corner of Lot 16, Block 2, Carswells Park, Walworth County, Wisconsin, thence N 18° 00' W, 54.15 feet, to the south line of Lost Nation Drive, thence S 70°32' W, along said south line of said Lost Nation Drive, 128.22 feet to the place of beginning, thence continue S 70°32' W, along said south line of said Lost Nation Drive, 88.22 feet, thence S 09°24' E, 146.00 feet to a point, thence continue S 09°24' E, 19 feet more or less to the shore of Mill Lake, thence NE 1/4 along said shore 89 feet more or less, thence N 07°39' W, 13 feet more or less to a point, said point being N 58°34' E, 89.46 feet from the aforementioned point, thence continue N 07°39' W, 127.92 feet to the place of beginning. \_\_\_\_\_

I hereby certify I have surveyed the above described parcel and that this plat is a true representation thereof.

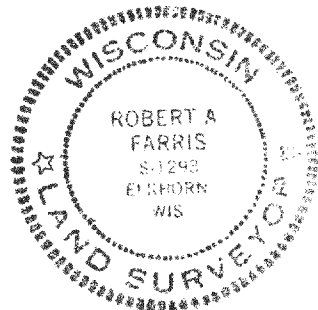

Robert A. Farris, R.L.S.

Proj # 2151  
29 NOV. 1983