

Plat of Survey



of

Lots 119 & 120 of the 2nd Addition
to Bubbling Springs Subdivision,


located in the Southeast 1/4 of the Northeast 1/4 of Section 34, Town 4
North, Range 16 East, Town of LaGrange, Walworth County, Wisconsin.

Surveyed for: **Laura Stroika c/o**
Thelen Total Construction, Inc.
P.O. Box 17
Elkhorn, Wisconsin. 53121

Bearings referenced to the South line of North Drive, recorded
as N84°20'E on the plat the 2nd Addition to Bubbling Springs
Subdivision, a rotation of 0°39'36" from the Wisconsin State
Plane Coordinate System, South Zone, (NAD-27).
Coordinates are referenced to the Wisconsin State
Plane Coordinate System, South Zone, (NAD-27).

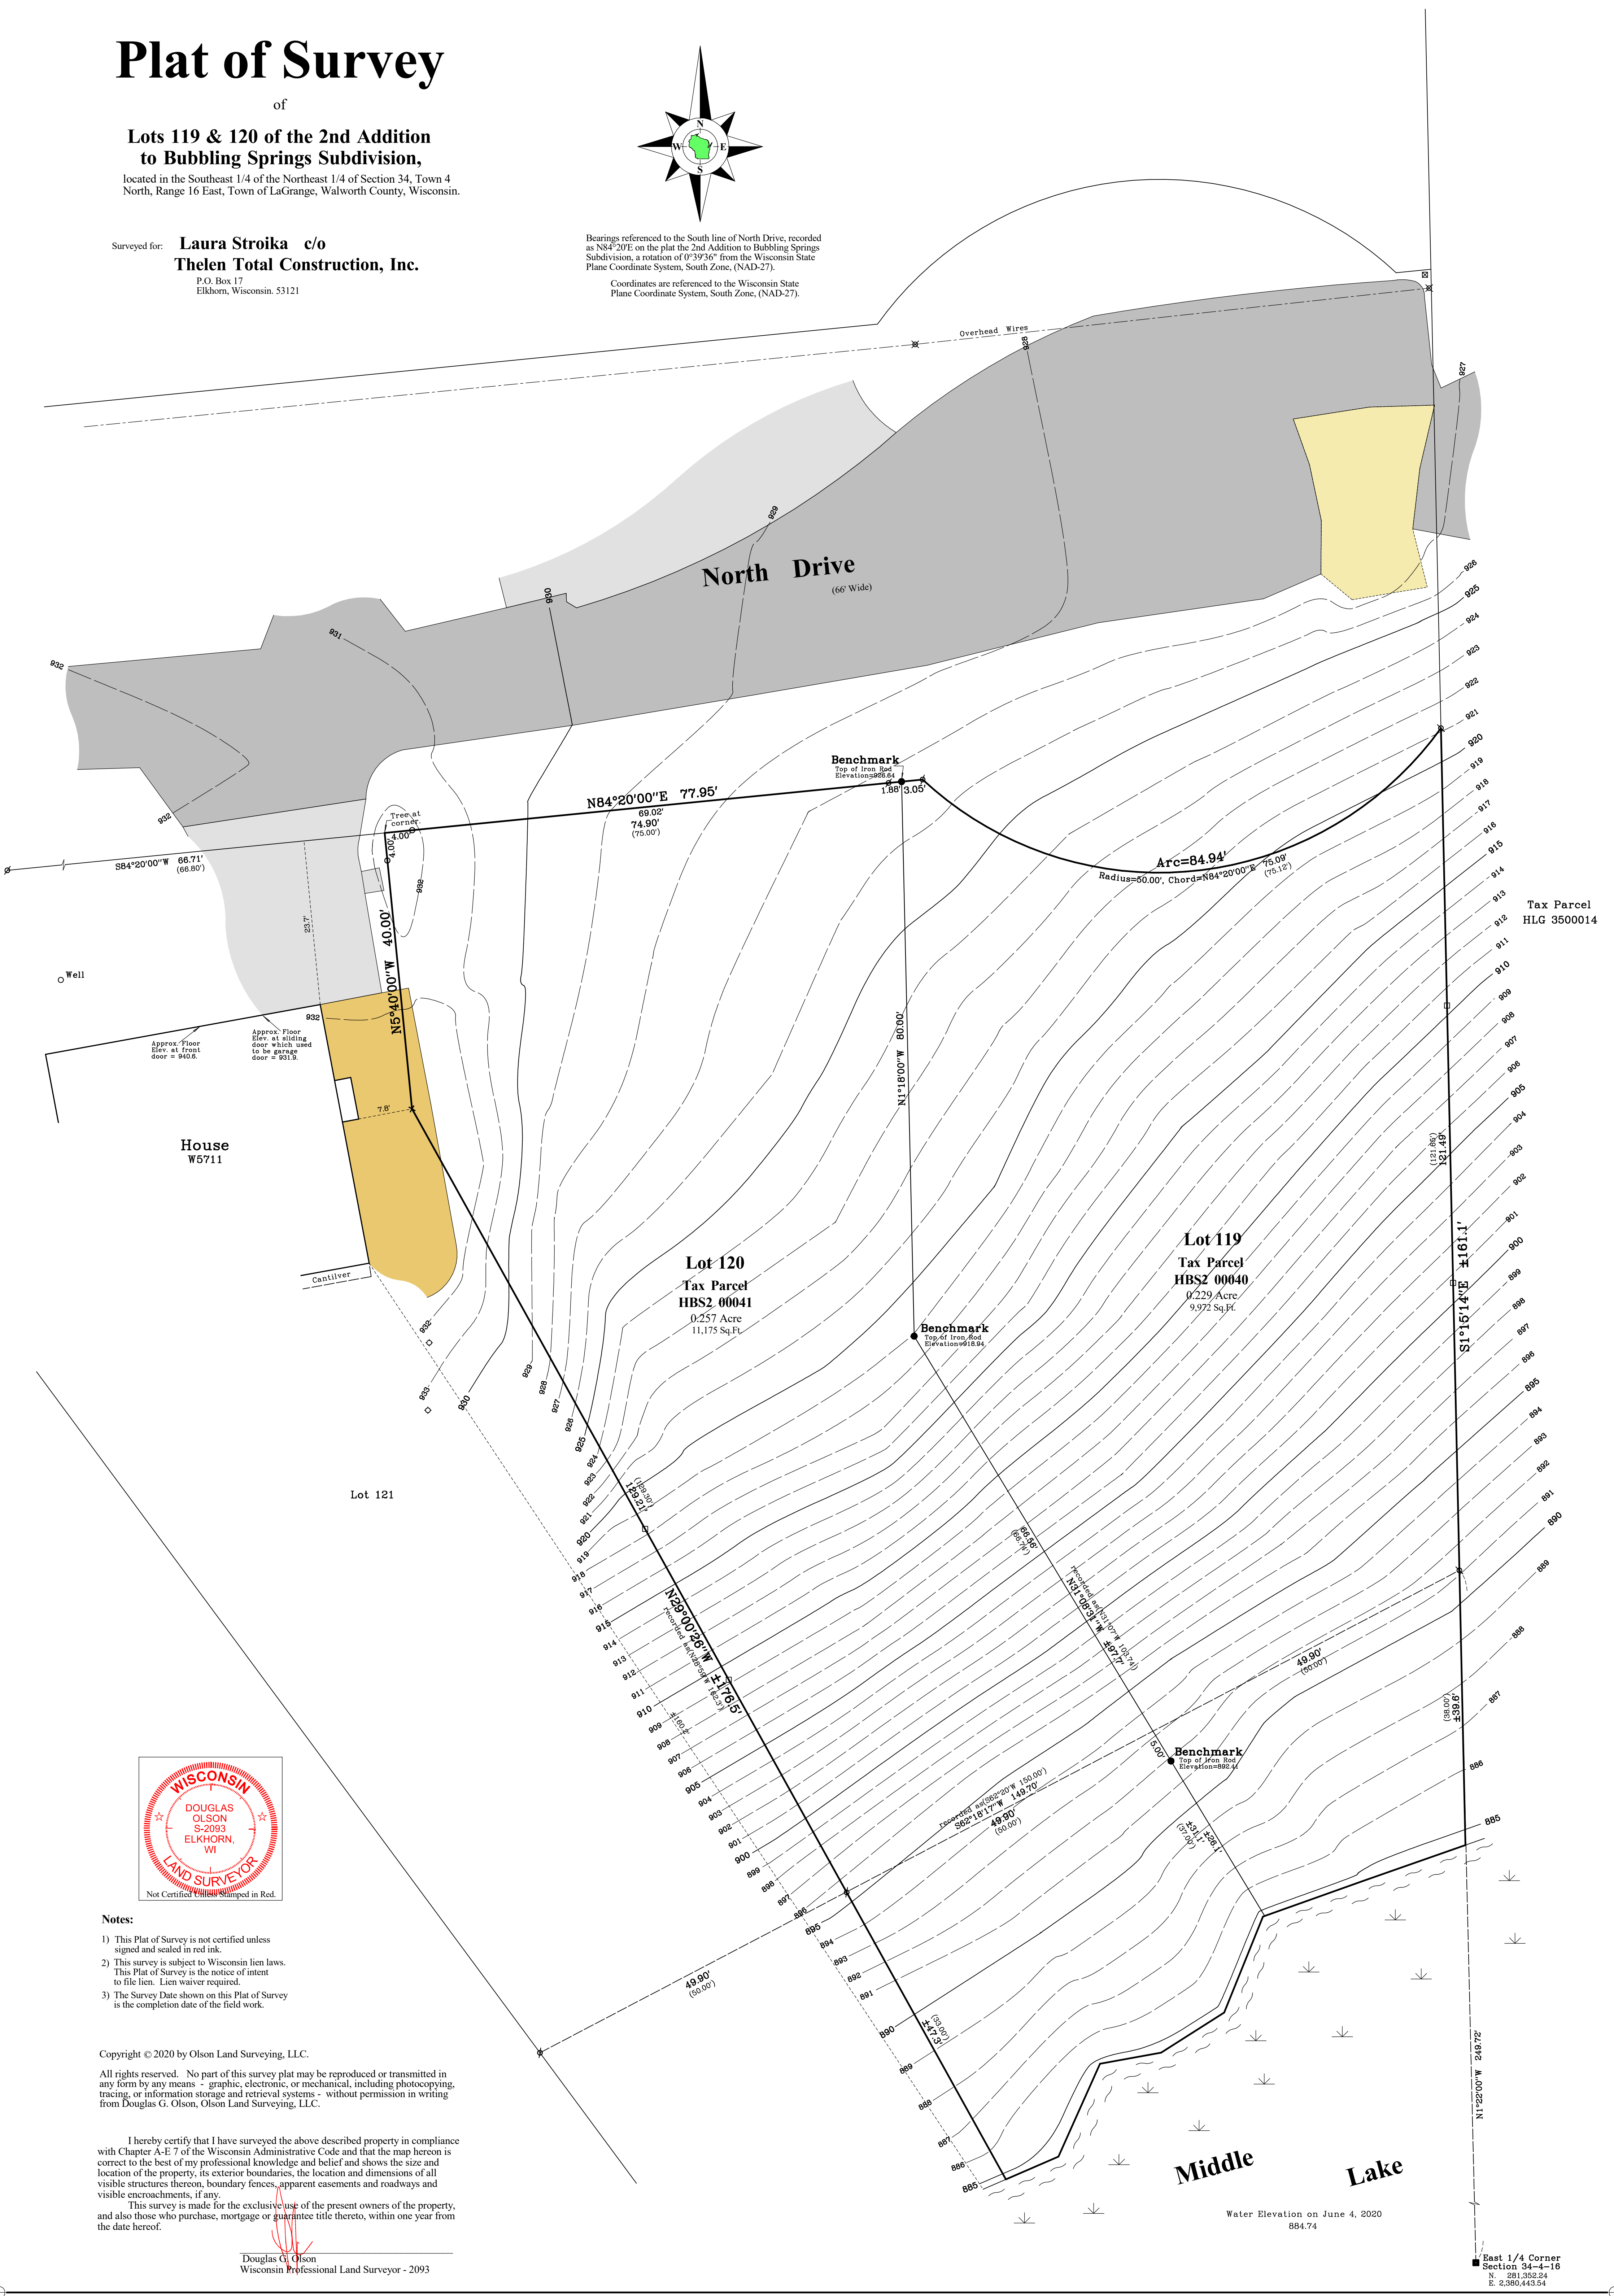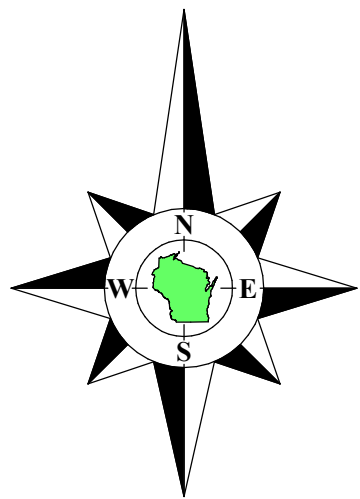

Tax Parcel
HLG 3500014

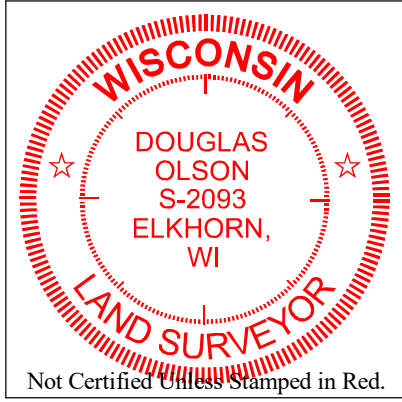

Notes:

- 1) This Plat of Survey is not certified unless signed and sealed in red ink.
- 2) This survey is subject to Wisconsin lien laws. This Plat of Survey is the notice of intent to file lien. Lien waiver required.
- 3) The Survey Date shown on this Plat of Survey is the completion date of the field work.

Copyright © 2020 by Olson Land Surveying, LLC.

All rights reserved. No part of this survey plat may be reproduced or transmitted in any form by any means - graphic, electronic, or mechanical, including photocopying, tracing, or information storage and retrieval systems - without permission in writing from Douglas G. Olson, Olson Land Surveying, LLC.

I hereby certify that I have surveyed the above described property in compliance with Chapter A-E 7 of the Wisconsin Administrative Code and that the map hereon is correct to the best of my professional knowledge and belief and shows the size and location of the property, its exterior boundaries, the location and dimensions of all visible structures thereon, boundary fences, apparent easements and roadways and visible encroachments, if any.

This survey is made for the exclusive use of the present owners of the property, and also those who purchase, mortgage or guarantee title thereto, within one year from the date hereof.

Douglas G. Olson
Wisconsin Professional Land Surveyor - 2093

Sheet 1 of 1 Sheets

Drawing Name:

Job Reference Number

2020.061

Legend of Symbols & Abbreviations


- Found County Section Corner
- Found Iron Pipe
- Set Iron Pipe, 1" dia.
- Recorded Information
- Utility Pole
- Concrete Cover
- Septic Vent
- Asphalt Surface
- Concrete Surface
- Gravel Surface
- Brick Pavers
- Set Wood Lath
- Set Cut Cross

N North
S South
E East
W West
In Bearings
Degrees
Minutes
Seconds
In Distances
Feet
Inches
No Number
NW Northwest
NE Northeast
Dia. Diameter



45 South Wisconsin Street | P.O. Box 322
Elkhorn, Wisconsin. 53121
Telephone: (262) 723-3434
Facsimile: (262) 723-8044
Email: doug@olsonsurveying.com
Website: www.olsonsurveying.com

Scale in Feet
1" = 10'

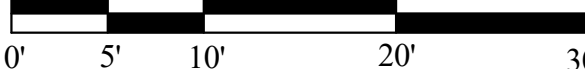

Survey date: June 4, 2020.

Revisions:

East 1/4 Corner
Section 34-4-16
N. 281.35224
E. 2,380.44354

2020.061