


FARRIS, HANSEN & ASSOCIATES, INC.
7 RIDGEWAY COURT, ELKHORN, WIS.
414-723-2098

UNPLATTED LANDS

ENCROACHMENT
VISIBLE DRAIN TILE OUTLET
SAID TO BELONG TO
OWNER NORTH OF LOT 1

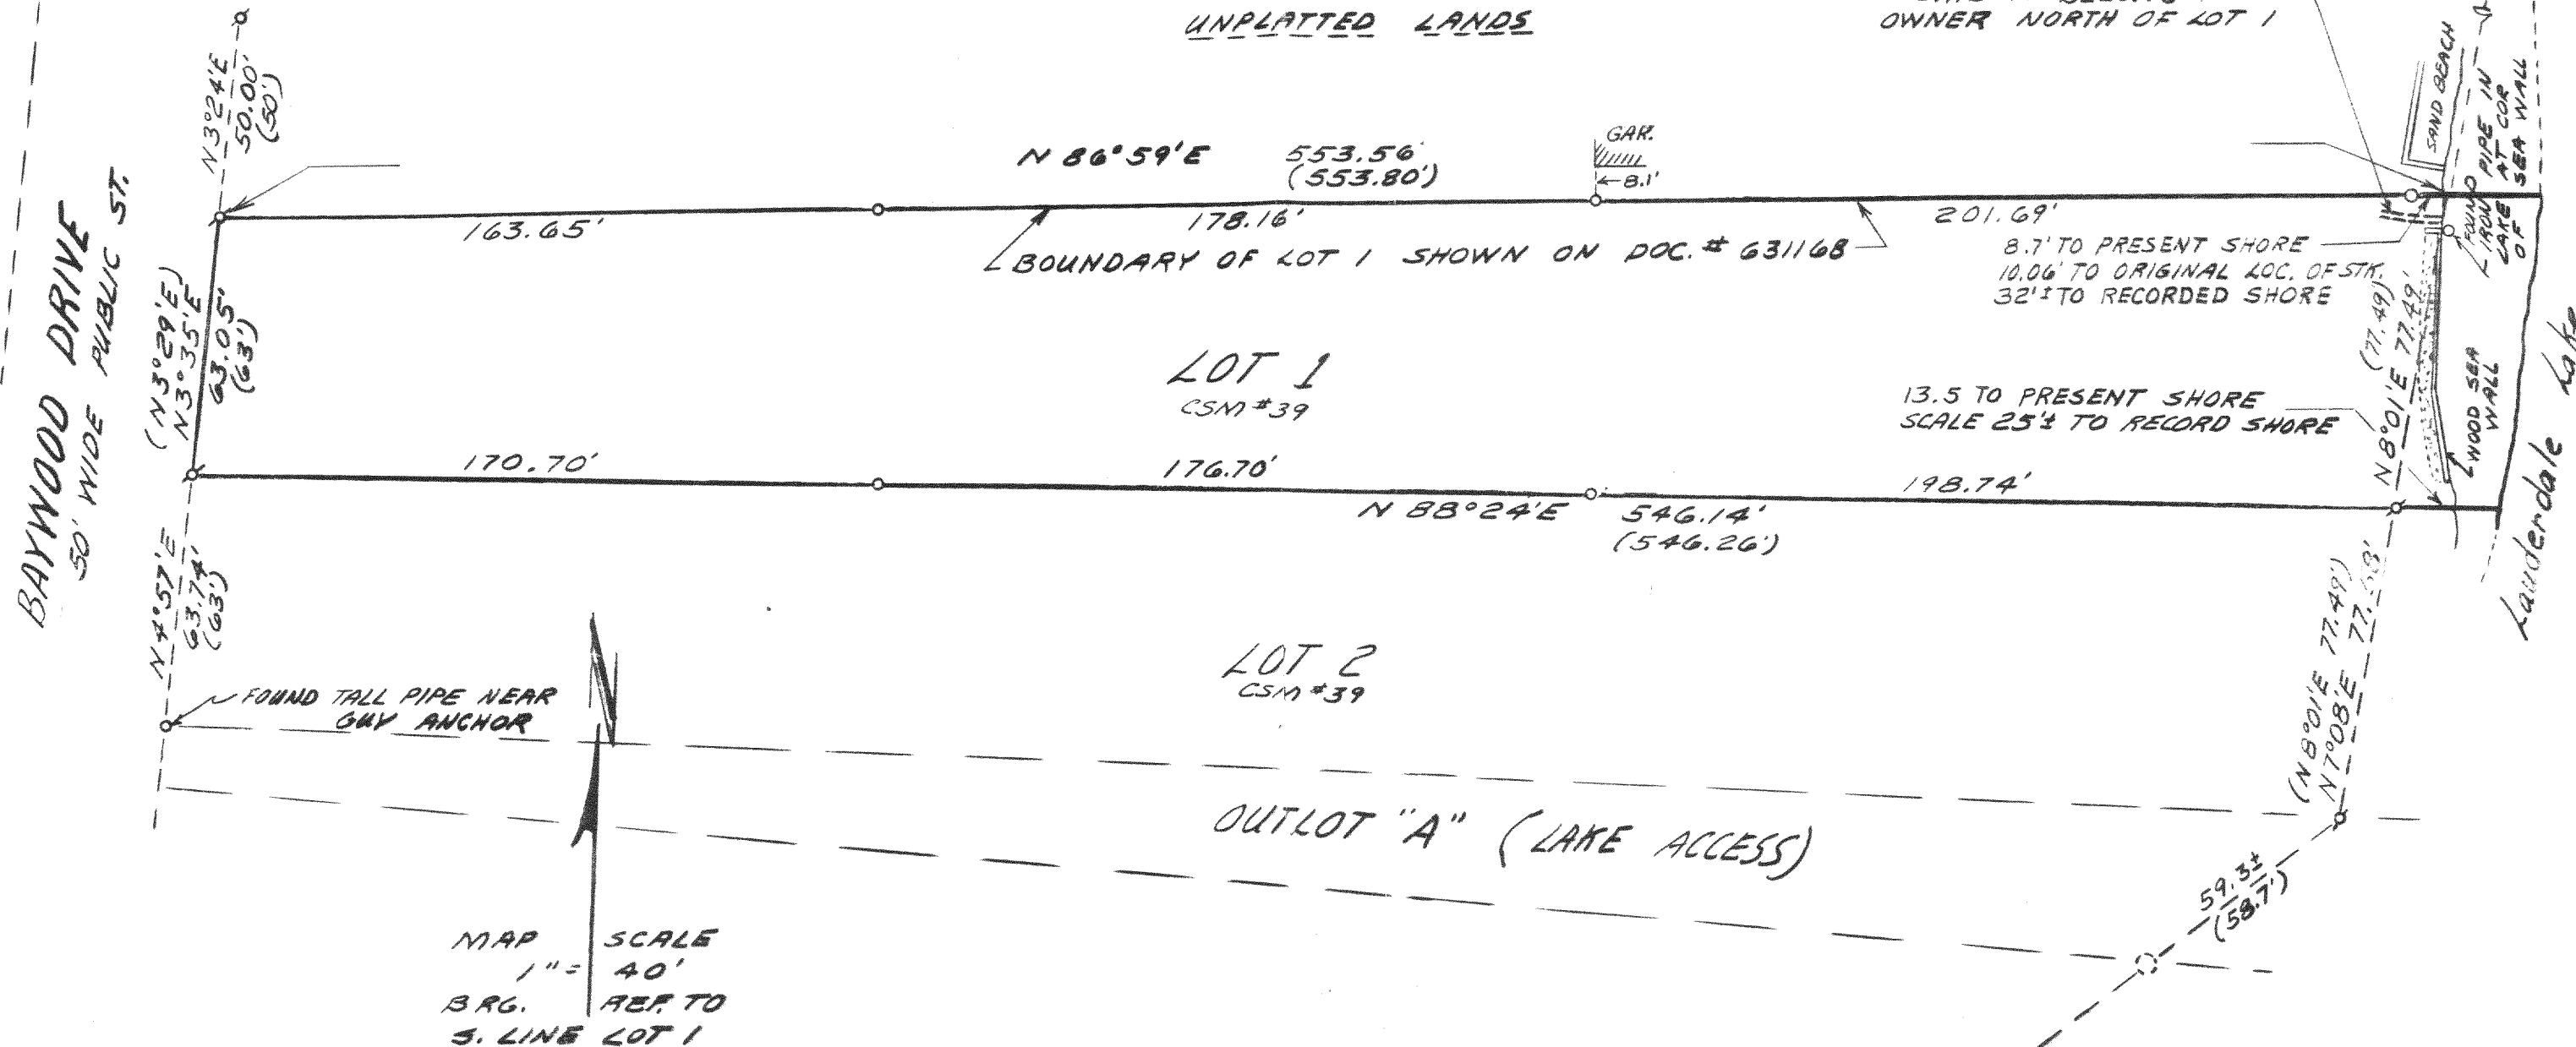


PLAT OF SURVEY LOT 1 CSM # 39 ACCORDING
TO THE ORIGINAL PLAT RECORDED IN VOL. 1 OF
CSM'S PAGE 39 AS DOC. # 631168

WORK ORDERED BY: FRANCES FLOOD

I HEREBY CERTIFY THAT THIS PLAT IS A TRUE AND ACCURATE
REPRESENTATION OF THE BOUNDARY LINES OF THE ABOVE
DESCRIBED PROPERTY TO THE BEST OF MY PROFESSIONAL
KNOWLEDGE AND BELIEF.

Robert A. Farris
DATED APR. 11, 1985

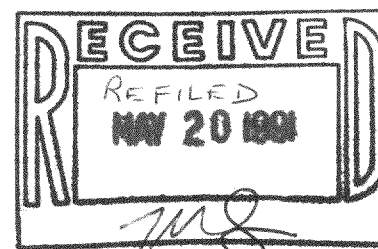

1ST COPY FILED ON 7-30-85 (LOST)

Legend
Ø = FOUND IRON PIPE STAKE
O = SET IRON PIPE STAKE 1"X24"
⊙ = METAL DETECTOR INDICATES IRON
OBJECT BENEATH SOO
(xxx) = RECORDED DIMENSION
xxx = MEASURED DIMENSION

TAX KEY # HA - 39 - 1

PROJECT NO. 2379

SURVEY # 416 - 340 F

RECEIVED
JUL 30 1985
GK. L

FOUND PIPE IN LAKE (DISTURBED) ~~OK~~

ENCROACHMENT
VISIBLE DRAIN TILE OUTLET
SAID TO BELONG TO _____
OWNER NORTH OF LOT 1

UNPLATTED LANDS

BAYWOOD DRIVE
50' WIDE PUBLIC ST.

FOUND TALL PIPE NEAR
GUY ANCHOR

MAP	SCALE
1" =	40'
B.R.G.	REF TO
S. LINE	LOT 1

PLAT OF SURVEY LOT 1 CSM # 39 ACCORDING
TO THE ORIGINAL PLAT RECORDED IN VOL. 1 OF
CSM'S PAGE 39 AS DOC. # 631168

WORK ORDERED BY: FRANCES FLOOD

I HEREBY CERTIFY THAT THIS PLAT IS A TRUE AND ACCURATE REPRESENTATION OF THE BOUNDARY LINES OF THE ABOVE DESCRIBED PROPERTY TO THE BEST OF MY PROFESSIONAL KNOWLEDGE AND BELIEF.

Robert A. Harris
DATED APR. 11, 1985

WISCONSIN
ROBERT A
FARRIS
S 1257
ELKHORN
WIS
LAND SURVEYOR

$$\begin{array}{r} 115.2^{\frac{1}{2}} \\ - 115 \\ \hline \end{array}$$

Legend

Ø = FOUND IRON PIPE STAKE
 O = SET IRON PIPE STAKE 1"X24"
 () = METAL DETECTOR INDICATES IRON
 OBJECT BENEATH SOD
 (xxx) = RECORDED DIMENSION
 xxx = MEASURED DIMENSION

PROJECT NO. 2379

416-340-F ✓ ✓

HA 39-1