

ABERNATHY and ASSOCIATES

Kenneth B. Abernathy, Jr.

Wisconsin Registered Land Surveyor S-1594

Rt. 3, Box 273

Elkhorn, Wisconsin 53121

Phone: (414) 723-4260 (office)

(414) 723-4813 (residence)


PLAT OF SURVEY

LOT 2 of BLOCK 1 of COOL HILL PARK SUBDIVISION LOCATED IN SECTION 35, TOWN 4 NORTH, RANGE 16 EAST, TOWN OF LAWRENCE, WALWORTH COUNTY, WISCONSIN.

Owner: Norman Leise

Rt. 1 box 549

Elkhorn, Wis. 53121

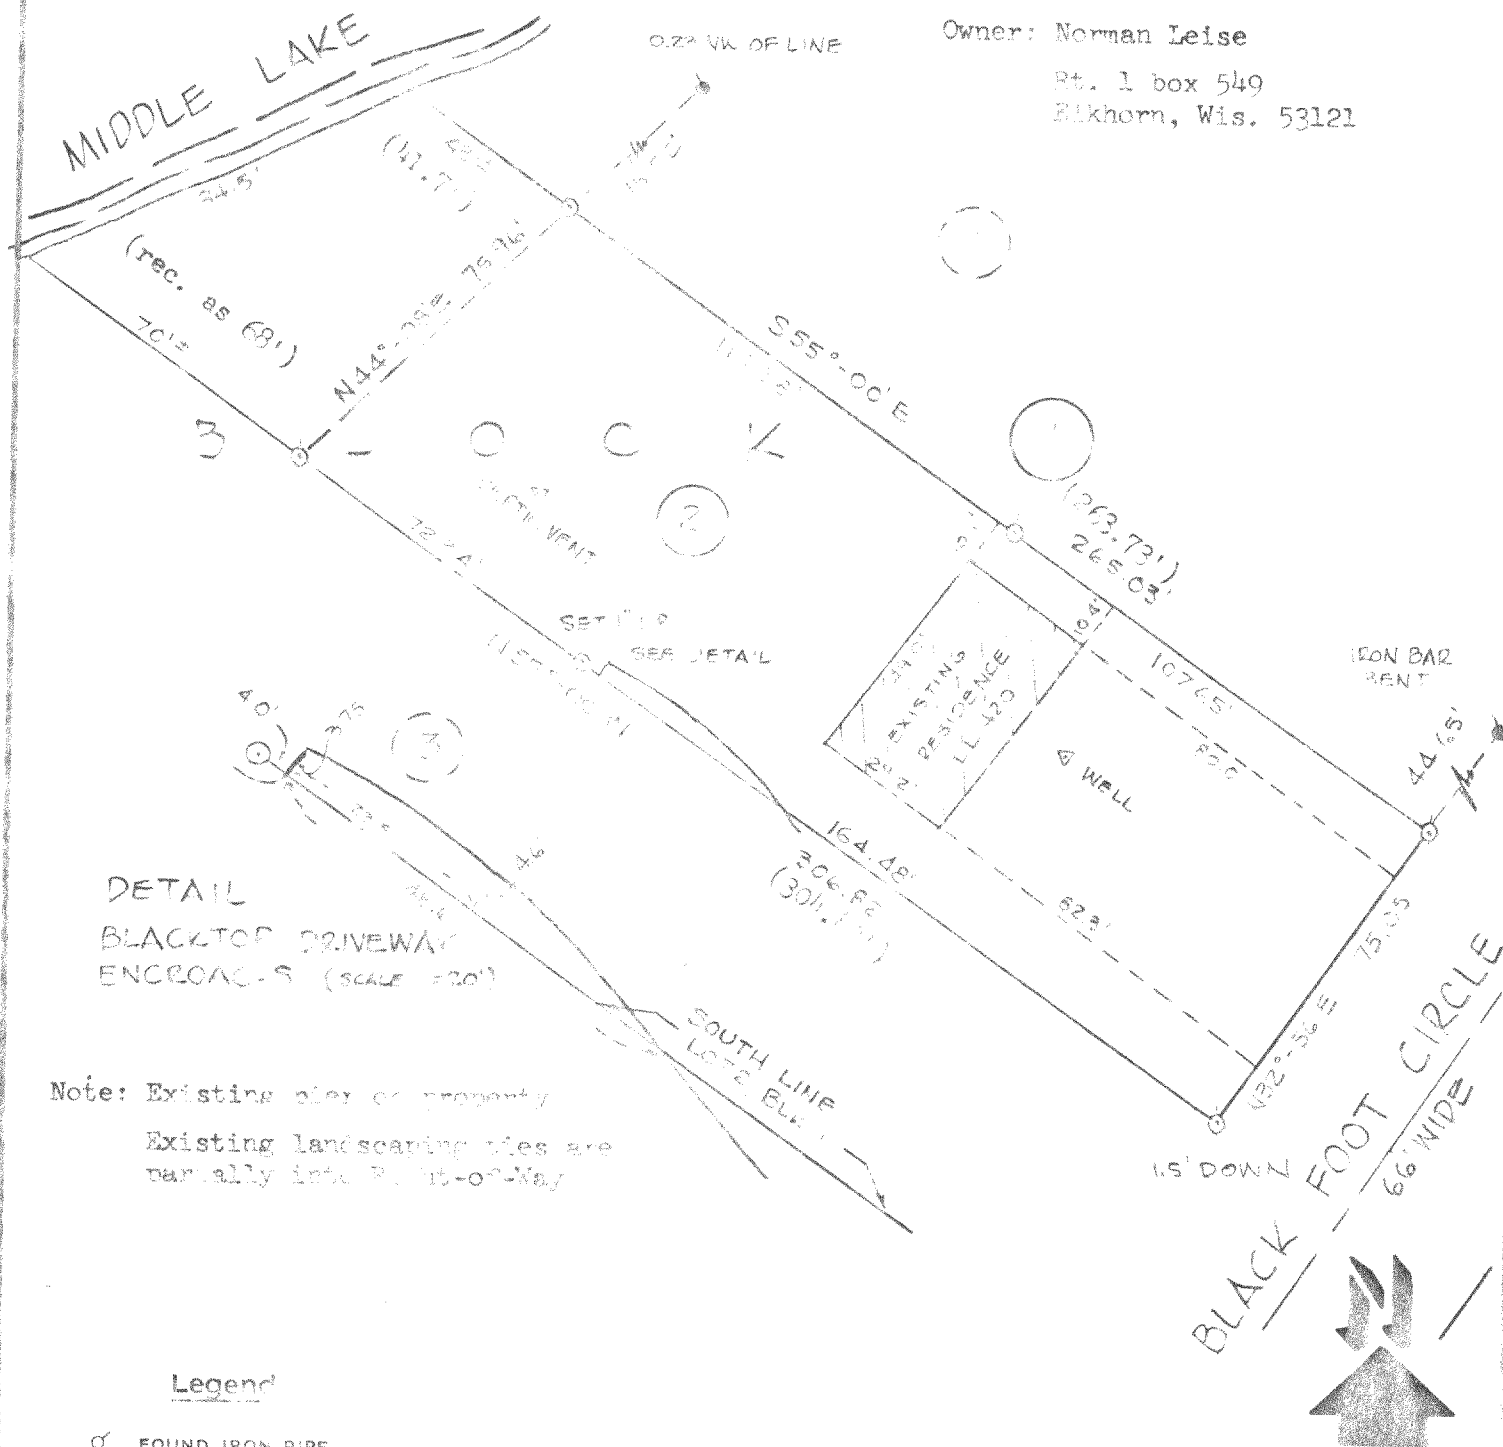

SCALE: 1" = 40' FEET


"I hereby certify that I have surveyed the above described property and that the above map is a true representation thereof and shows the size and location of the property, its exterior boundaries, the location of all visible structures and dimensions of all principal buildings thereon, boundary fences, apparent easements, roadways and visible encroachments, if any."

"This survey is made for the use of the present owners of the property, and also those who purchase, mortgage, or guarantee the title thereto within one year from date hereof."

Kenneth B. Abernathy, Jr.

KENNETH B. ABERNATHY, JR.
WISCONSIN REGISTERED LAND SURVEYOR,
S-1594

Date: 6/8/85 Job No. 1985-603

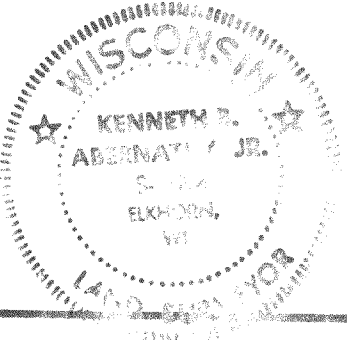

HC H-00009

416-345