
## N9330 Knuteson Drive LAND-MARK SURVEYING Whitewater, WI 53190 OWNER: Phone:(262)949-1239 Mark L. Miritz **N & L JOHNSON TRUST** MARKMIRITZ@ LAND-MARKSURVEYING.COM Wisconsin Professional Land Surveyor S-2582 **W5159 BAY SHORE DRIVE** ELKHORN, WI 53121 BAY VIEW BLK I MANOR 4.03') **62°**52°49'00" **E** 153.13' SEPTIC VENT (94.00') **93.89'** 132.80' BLACKTOP DRIVE DRIVE 3 59.7 00.04,00" (50' WIDE) RESIDENCE SHORE SEPTIC 100 YR. FLOOD ELEV=886.00' 10 BAY BAY WELL STERLINGWORTH (38.92') **38.90'** 28.1 SEPTIC STEPS UTILITY N 74°34'15" W 145.14' RIP RAP ENCROACHES 1'

## PLAT OF SURVEY

LOT 2 OF CERTIFIED SURVEY MAP NO. 575, LOCATED IN THE NORTHWEST 1/4 OF SECTION 36, TOWN 4 NORTH, RANGE 16 EAST, TOWN OF LAGRANGE, WALWORTH COUNTY, WISCONSIN.





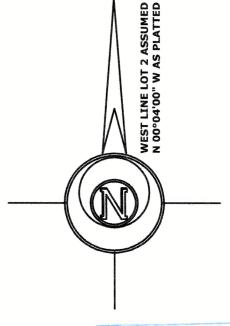

## LEGEND

FOUND IRON PIPE

FOUND IRON ROD

(XX) RECORDED AS DIMENSION

EXISTING SPLIT RAIL FENCE

## SCALE: 1 INCH = 20 FEET

"I hereby certify that the above described property has been surveyed by me or under my direction and that the above map is a true representation thereof and shows the size and location of the property, its exterior boundaries, the location of all visible structures and dimensions of all principal buildings thereon, boundary fences, apparent easements, roadways and visible encroachments, if any."

"This survey is made for the use of the present owners of the property, and also those who purchase, mortgage, or guarantee the title thereto within one year from date hereof."

MARK L. MIRITZ
WISCONSIN PROFESSIONAL
LAND SURVEYOR S-2582

DATE: JUNE 12, 2023 JOB NO. 23.601

116-3453