
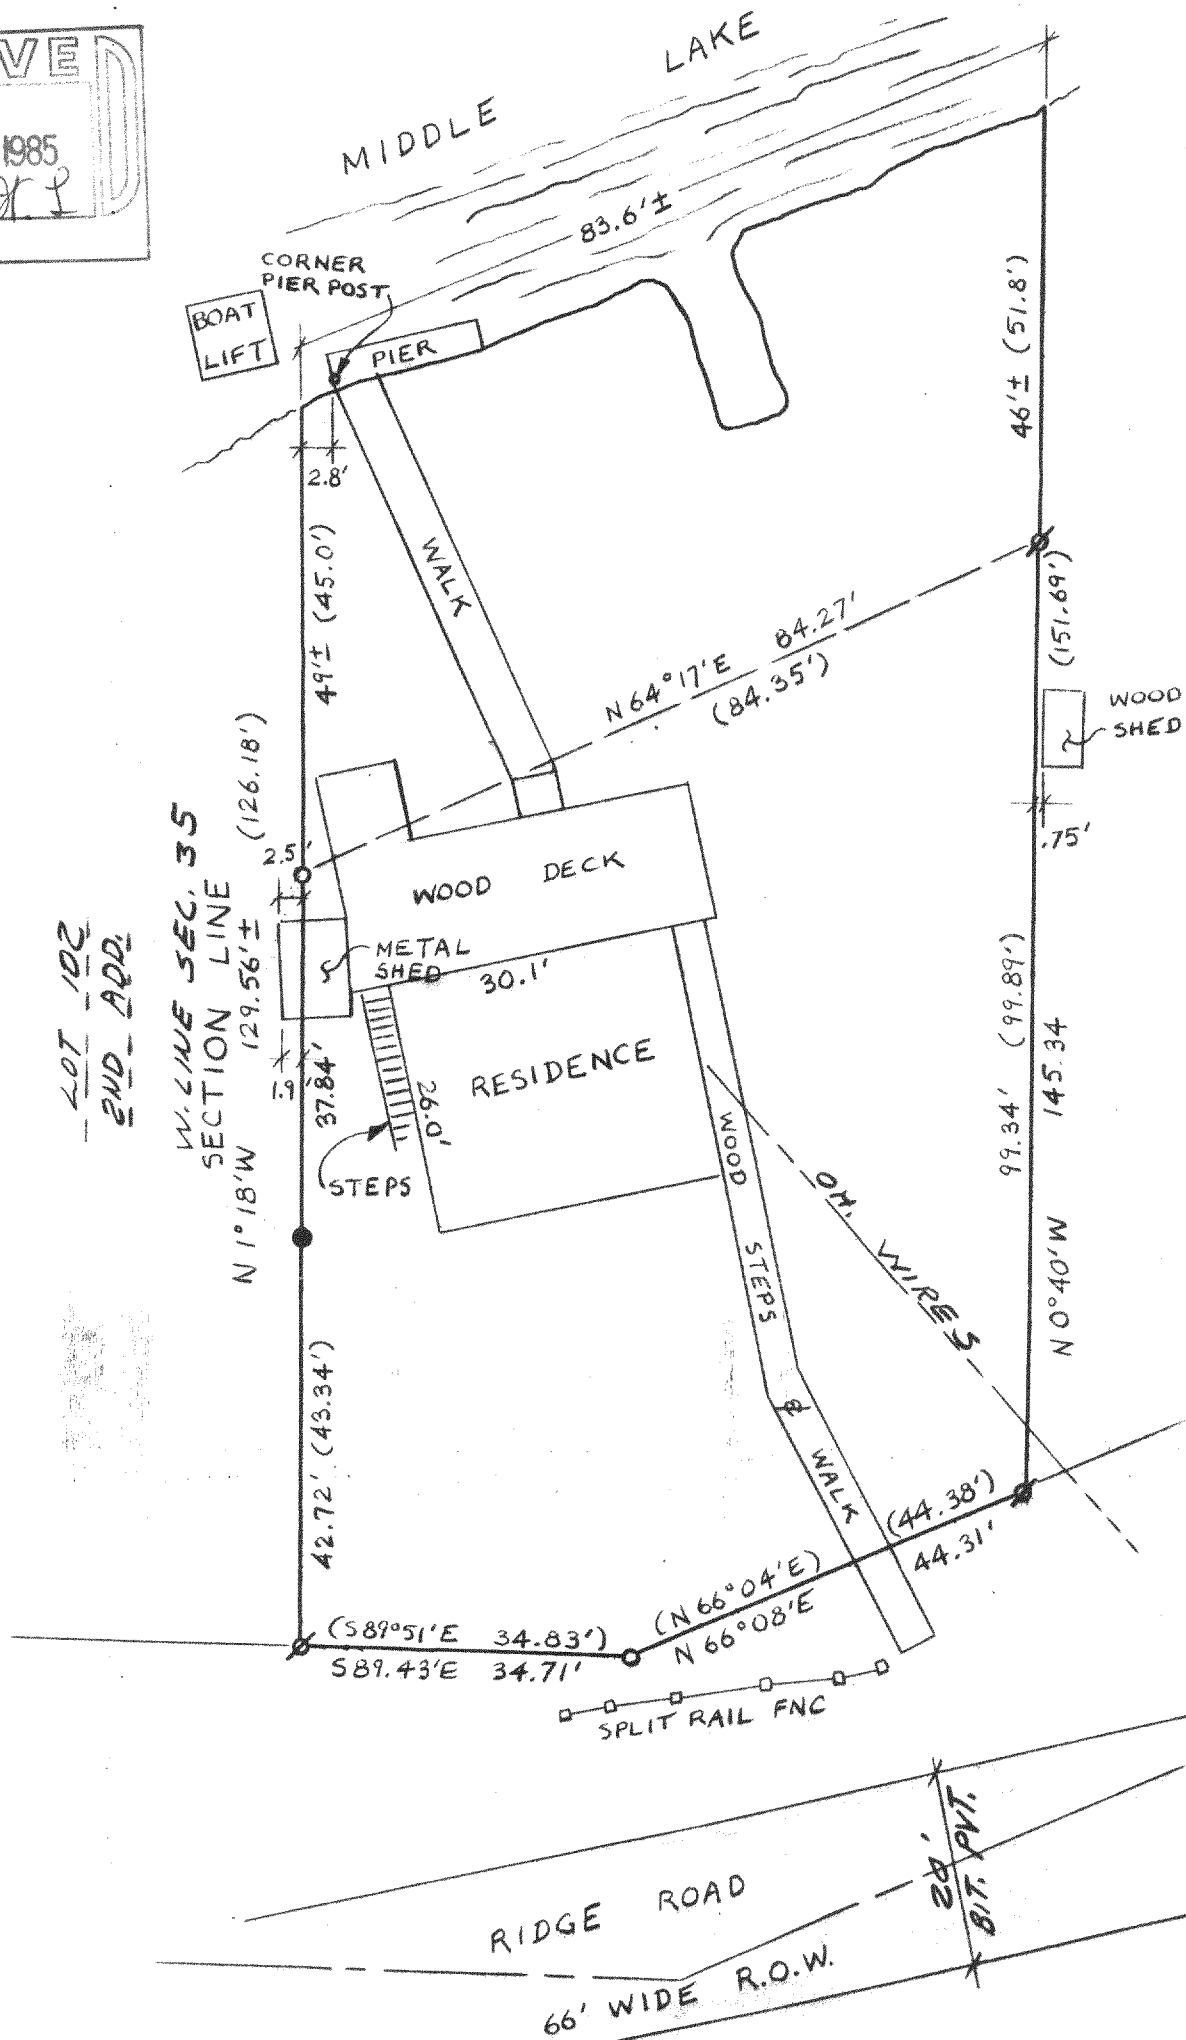



FARRIS HANSEN & ASSOCIATES, INC.
7 RIDGEWAY COURT, ELKHORN, WI
414-723-2098

PLAT OF SURVEY OF LOT 74 OF BUBBLING SPRINGS 1ST ADDITION LOCATED IN SECTION 35, TOWN 4 N., RANGE 16 EAST,
WALWORTH COUNTY, WISCONSIN

Work ordered by: Colony Realty

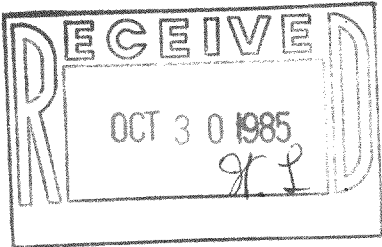

MAP SCALE
1" = 20'

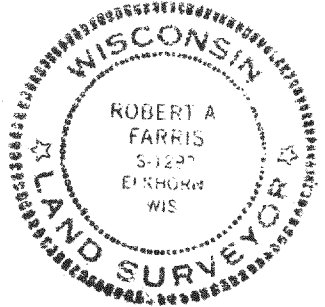

I hereby certify that I have surveyed the above described property and that the above map is a true representation thereof and shows the size and location of the property, its exterior boundaries, the location of all visible structures and dimensions of all principal buildings thereon, boundary fences, apparent easements, roadways and visible encroachments, if any.
This survey is made for the use of the present owners of the property, and also those who purchase, mortgage, or guarantee the title thereto within one (1) year from the date hereof.

Robert A. Farris
OCT. 7, 1985

Legend

- Ø = Iron pipe survey stake found
- = Iron pipe survey stake set
- = concrete survey monument found
- (xxx) = record dimension

PROJECT NO. 2477