

PLAT OF SURVEY

of

Lot 14 Block 1 Bay View Manor, Located in Government
lot 1 (Fractional W 1/2 of the NW 1/4, And the NE 1/4 of the NW 1/4,
and the SE 1/4 of the NW 1/4, Section 36, T4N, R16E, Walworth
County, Wisconsin.

Surveyed by: JENSEN SURVEYING &
MAPPING S.C.


45 S. Wisconsin
Elkhorn, WI 53121.

Surveyed for: Colony Realty
16 E. Walworth
Elkhorn, WI 53121

Mapping date: May 9, 1985

Mill
LAKE



Sterlingworth Bay

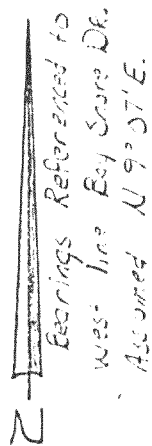

Scale 1" = 30'

Legend

- ~ 1 1/4" Found iron pipe
- o ~ 1 1/4" Found iron rod
- ~ 1 3/4" Found iron pipe
- ~ 1 1/4" Set iron rod

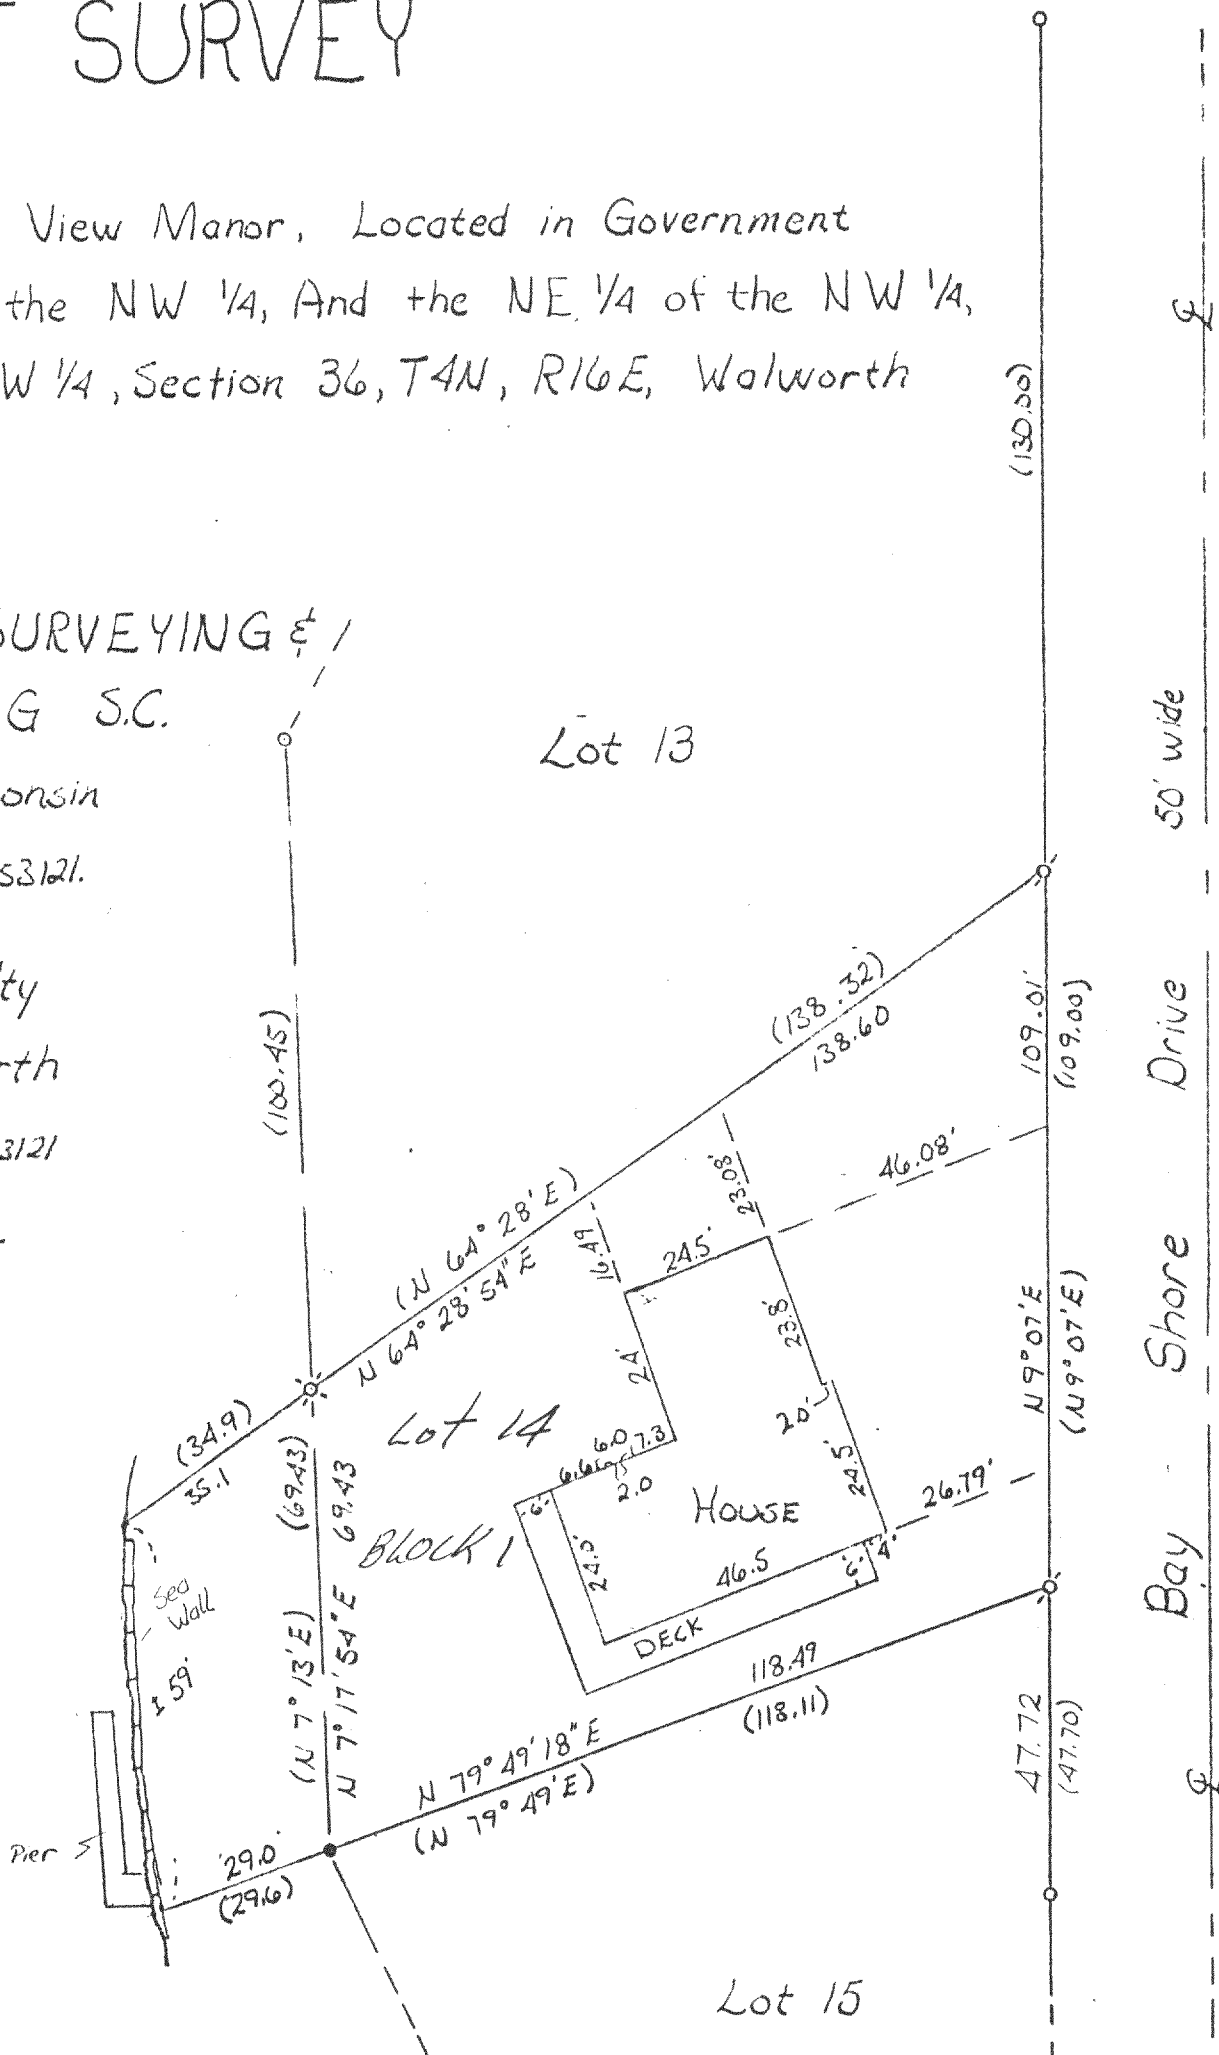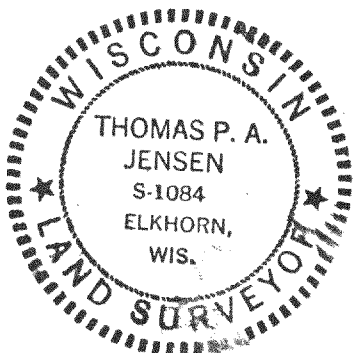

I, Thomas P.A. Jensen, Wis. Registered Land
Surveyor, do hereby certify that this survey was done
by me, or under my direction, in full compliance with
the owner's/agent's instructions and chapter A-E 5 of
the Wis. Admin. Code "Minimum Standards For Property
Surveys"; and that this map is an accurate representa-
tion thereof to the best of my knowledge and belief.

Thomas P.A. Jensen
Thomas P.A. Jensen

S-1084

416-355

1985.026

1985.026

NB-14