

PLAT OF SURVEY OF
LOT 1 OF CSM No. 575 LOCATED IN
THE NE 1/4 OF THE NW 1/4 OF SECTION 36,
T4N, R16E, TOWN OF LAGRANGE,
WALWORTH, COUNTY, WISC.

JENSEN SURVEYING & MAPPING S.C.

P.O. BOX 322 ELKHORN, WISC.

45 S. WISCONSIN ST.

53121

PHONE ~ (414) 723-3434

SURVEYED FOR: COLDEN REALTY
16 EAST WALWORTH ST.
ELKHORN, WISC.
53121

BEARINGS REFERENCED TO EAST R.O.W. OF
BAY SHORE DRIVE ~ N00°04'00"W


SCALE ~ 1"=40'

LEGEND


- ~ FOUND 1 1/4" IRON BAR
- ~ FOUND IRON PIPE
- ⊙ ~ POWER POLE
- ~ UTILITY FED.
- ~ SHRUB LINE

MILL LAKE OF
LAUDERDALE LAKES


STERLINGWORTH BAY

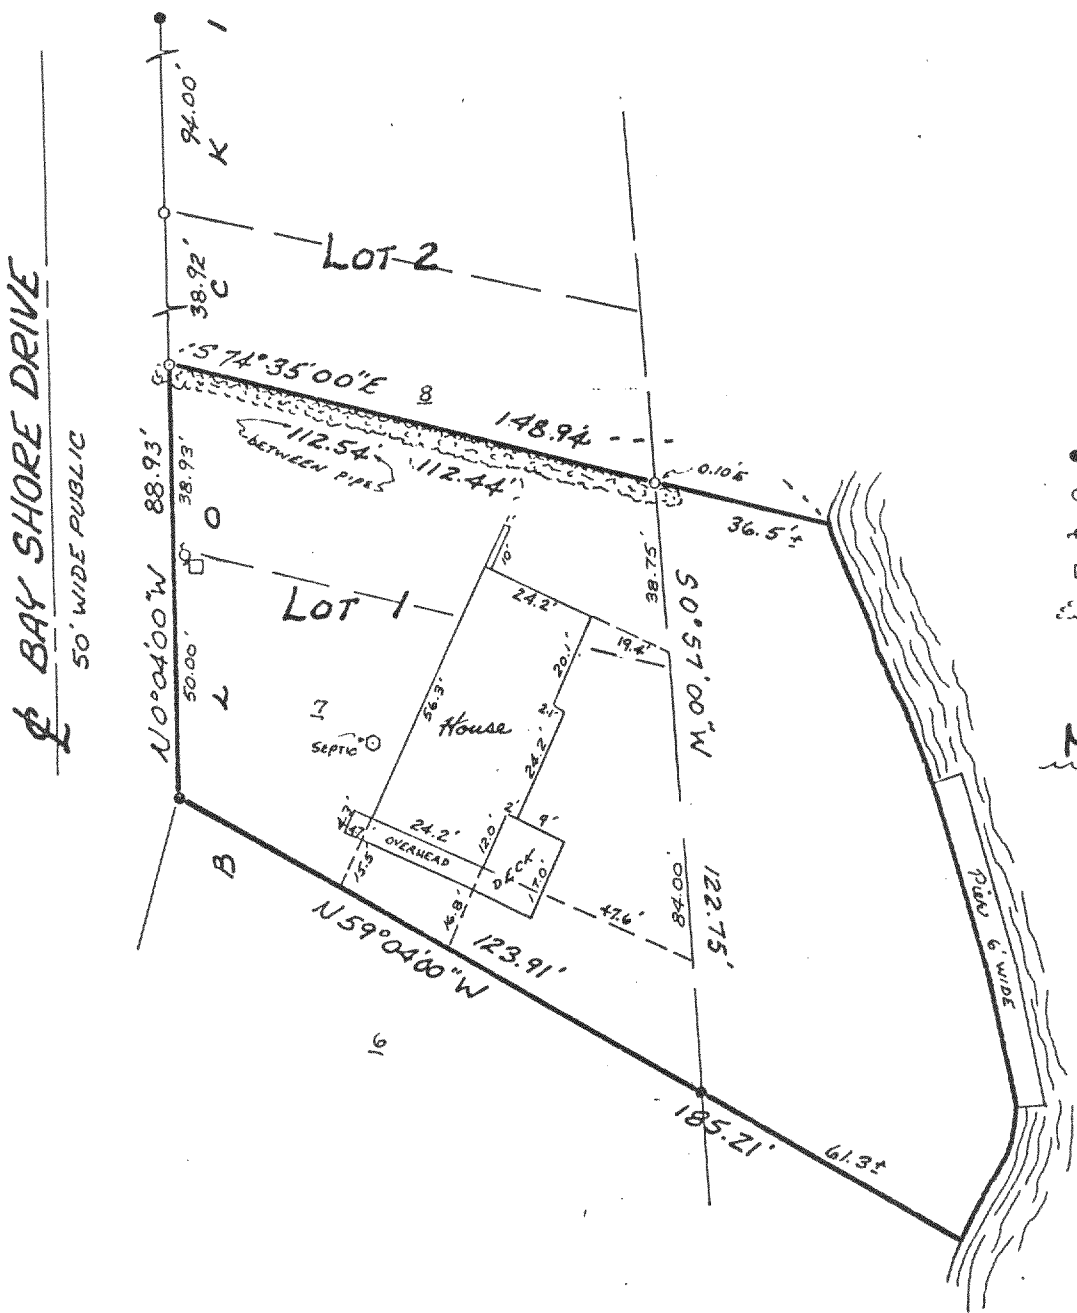

I HEREBY CERTIFY THAT THE ABOVE DESCRIBED PROPERTY
HAS BEEN SURVEYED UNDER MY DIRECTION THAT THE PLAT
HEREON IS AN ACCURATE SURVEY A TRUE REPRESENTATION
THEREOF, CORRECTLY SHOWS THE EXTERIOR BOUNDARY LINES
ON SAID PROPERTY AND THE CORRECT MEASUREMENTS THEREOF
AND BUILDINGS THEREON.

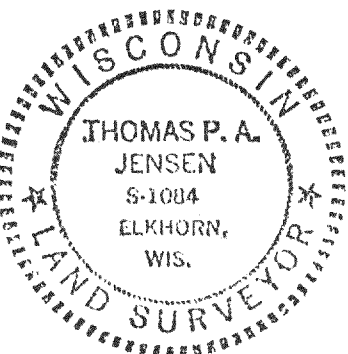

Thomas P.A. Jensen
THOMAS P.A. JENSEN RLS-1084
MAPPING DATE ~ 11 JAN 85

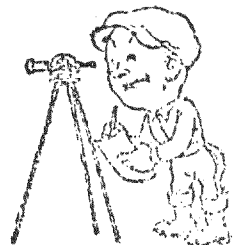

416-357
1985.002

WA 575-1