

PLAT OF SURVEY OF LOTS 9, 10 & 11 OF BLOCK 1 OF
THAN'SLAND SUBDIVISION A SUBDIVISION LOCATED IN SECTION 35, T4N, R16E WALWORTH COUNTY
WISCONSIN, EXCEPTING THEREFROM A PARCEL OF LAND LOCATED IN LOT 9 OF SAID SUBDIVISION
MORE PARTICULARLY DESCRIBED AS FOLLOWS; BEGIN AT THE NW CORNER OF LOT 9; THENCE
S 3° 36' 21" E 94.36 FEET; THENCE N 16° 02' 08" E 84.49 FEET; THENCE N 66° 10' 21" W 32.00 FEET
TO THE POINT OF BEGINNING.



P.O. Box 322

45 S. WISCONSIN ST.

ELKHORN, WISCONSIN

PHONE (414) 723-3434

SURVEYED FOR; ROY FORTI
2517 N. NORDICA AVE.
CHICAGO, ILL. 60635

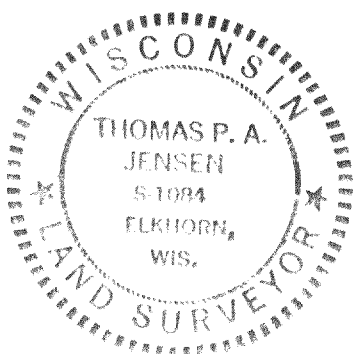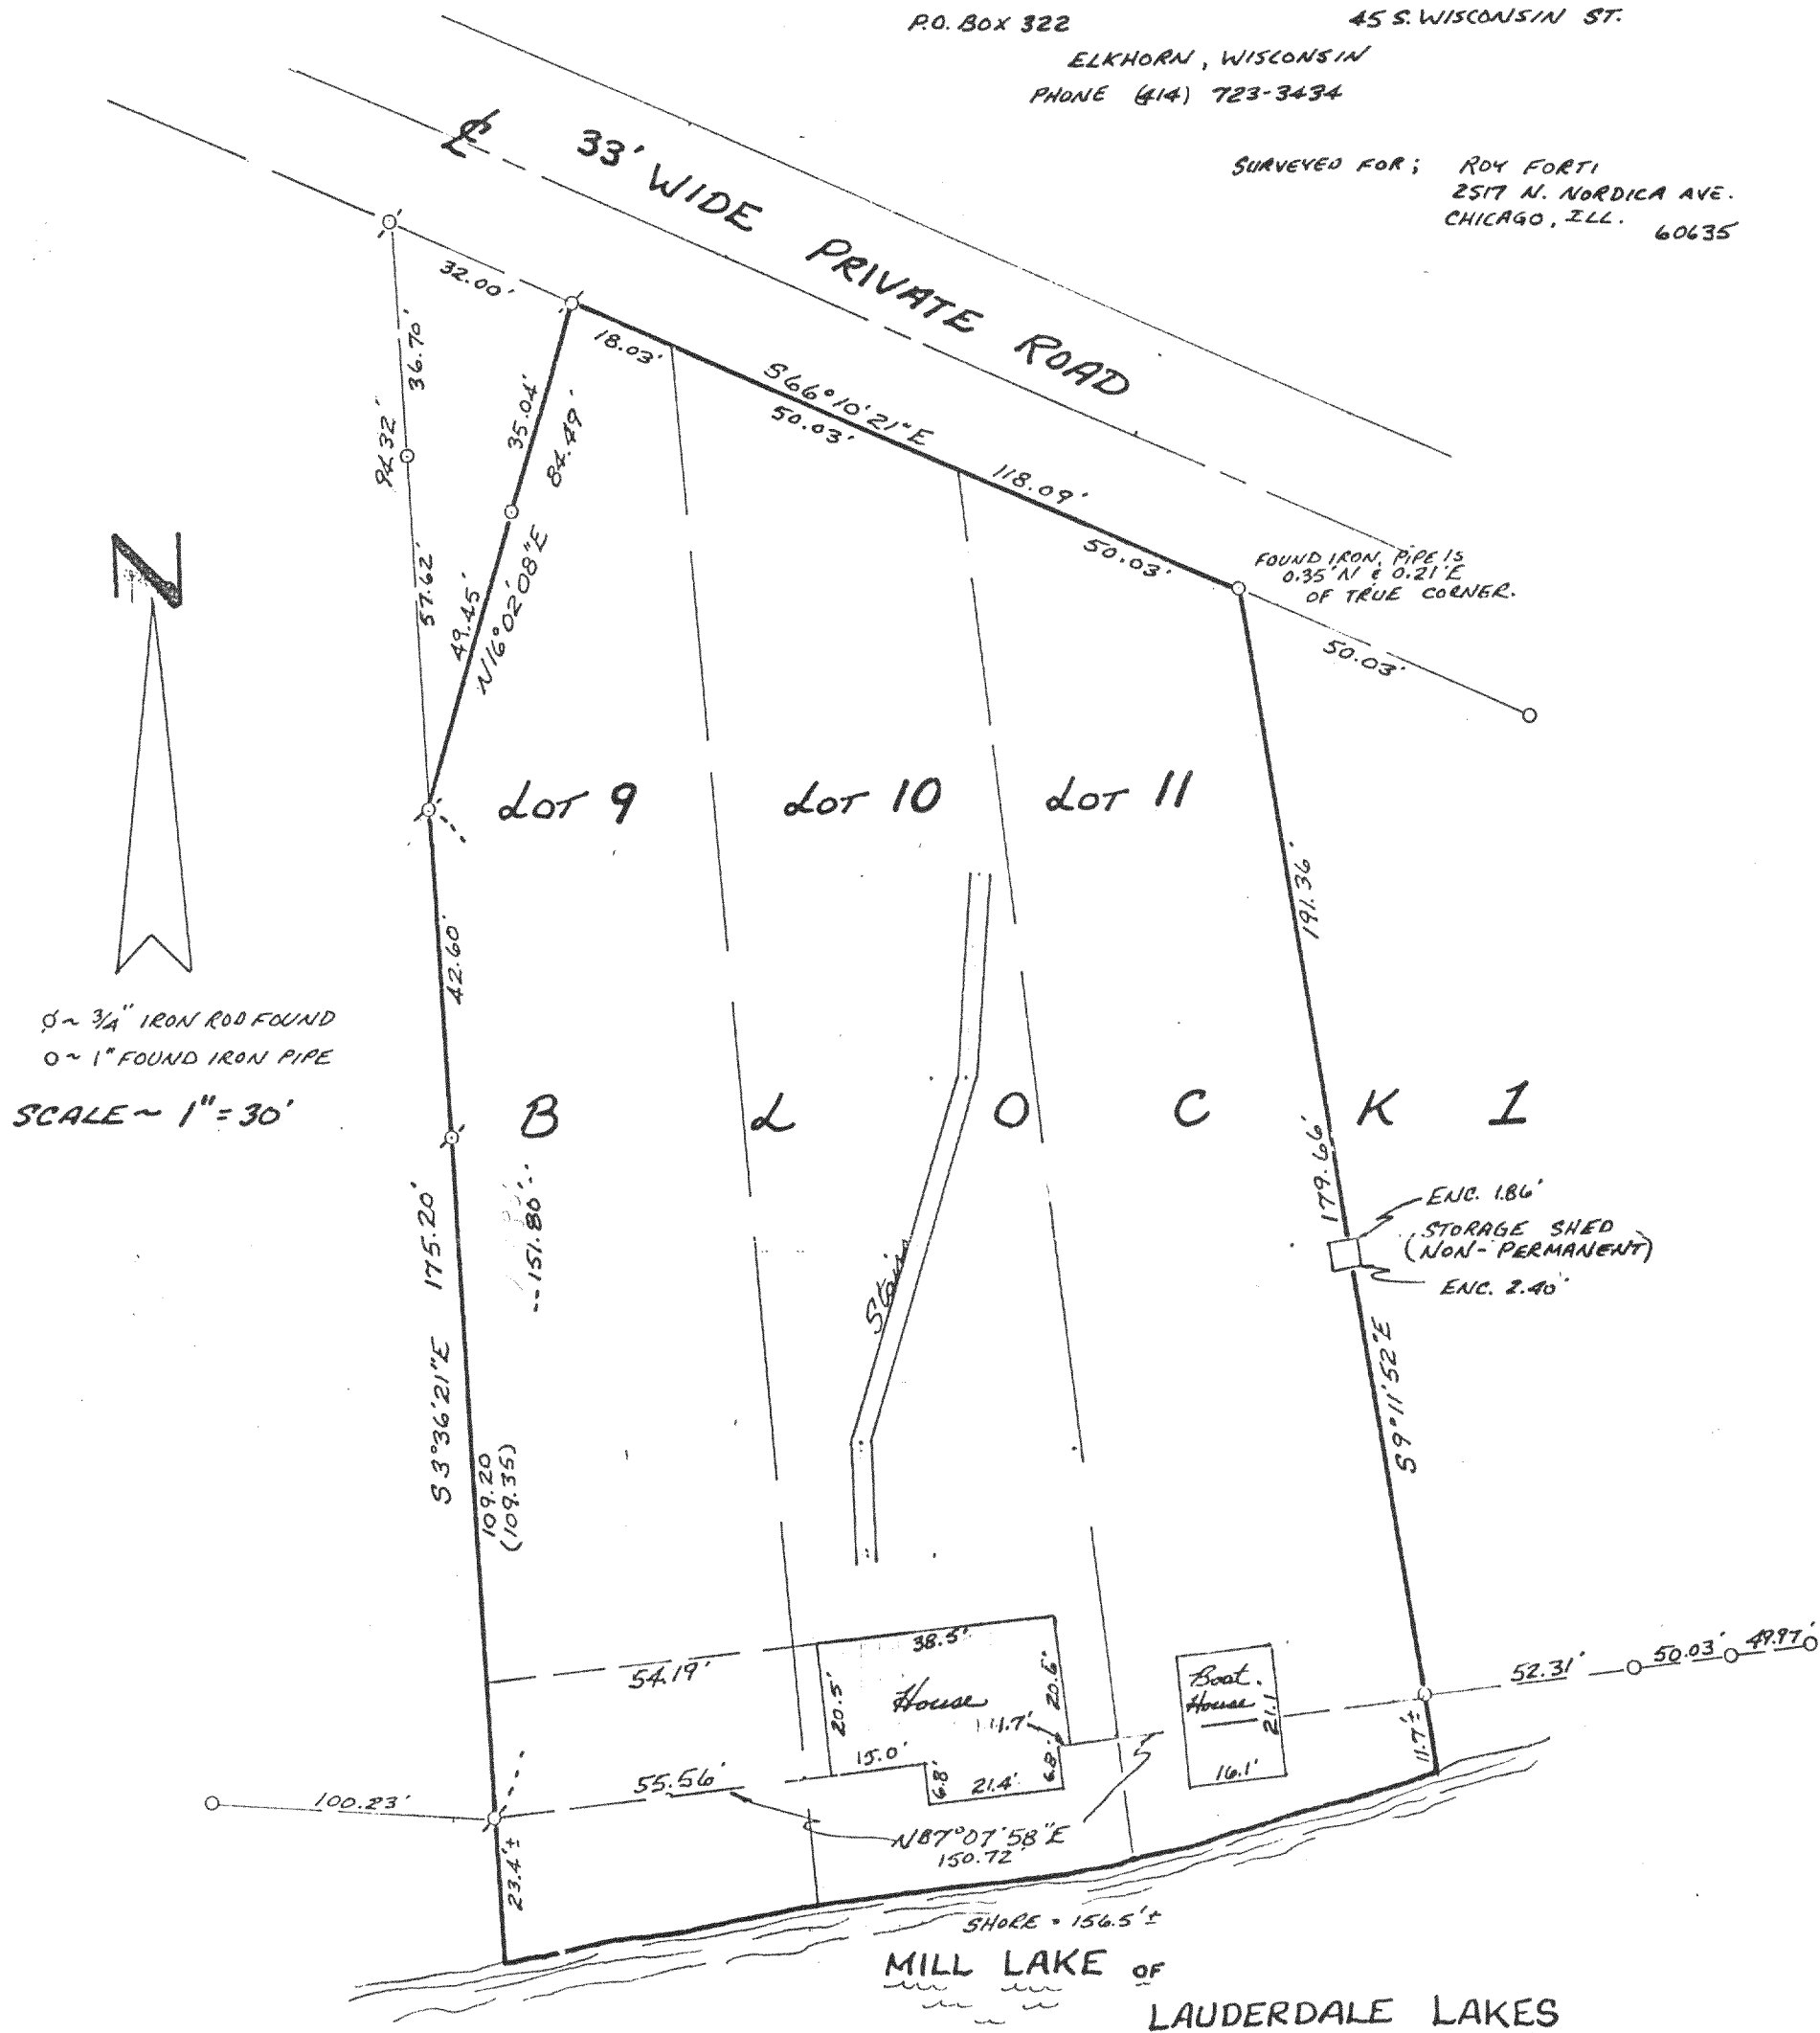

I, THOMAS P.A. JENSEN, WIS. REGISTERED LAND SURVEYOR,
DO HEREBY CERTIFY THAT THIS SURVEY WAS PERFORMED BY ME,
OR UNDER MY DIRECTION, IN FULL COMPLIANCE WITH THE OWNER'S/
AGENT'S INSTRUCTIONS AND CHAPTER A-ES OF THE WIS. ADMIN.
CODE "MINIMUM STANDARDS FOR PROPERTY SURVEYS"; AND THAT
THIS MAP IS AN ACCURATE REPRESENTATION THEREOF TO THE
BEST OF MY KNOWLEDGE AND BELIEF.

THOMAS P.A. JENSEN S-1084

DATE ~ Nov. 25, 1985

1985.017