


D.D. COOPER & CO. INC.


Route 4 Box 508B
Elkhorn WI 53121
Phone-414-723-6265

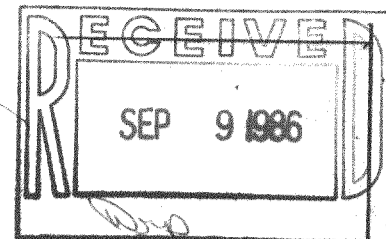

LAUDERDALE
LAKE

EXISTING PIER

LOT 39

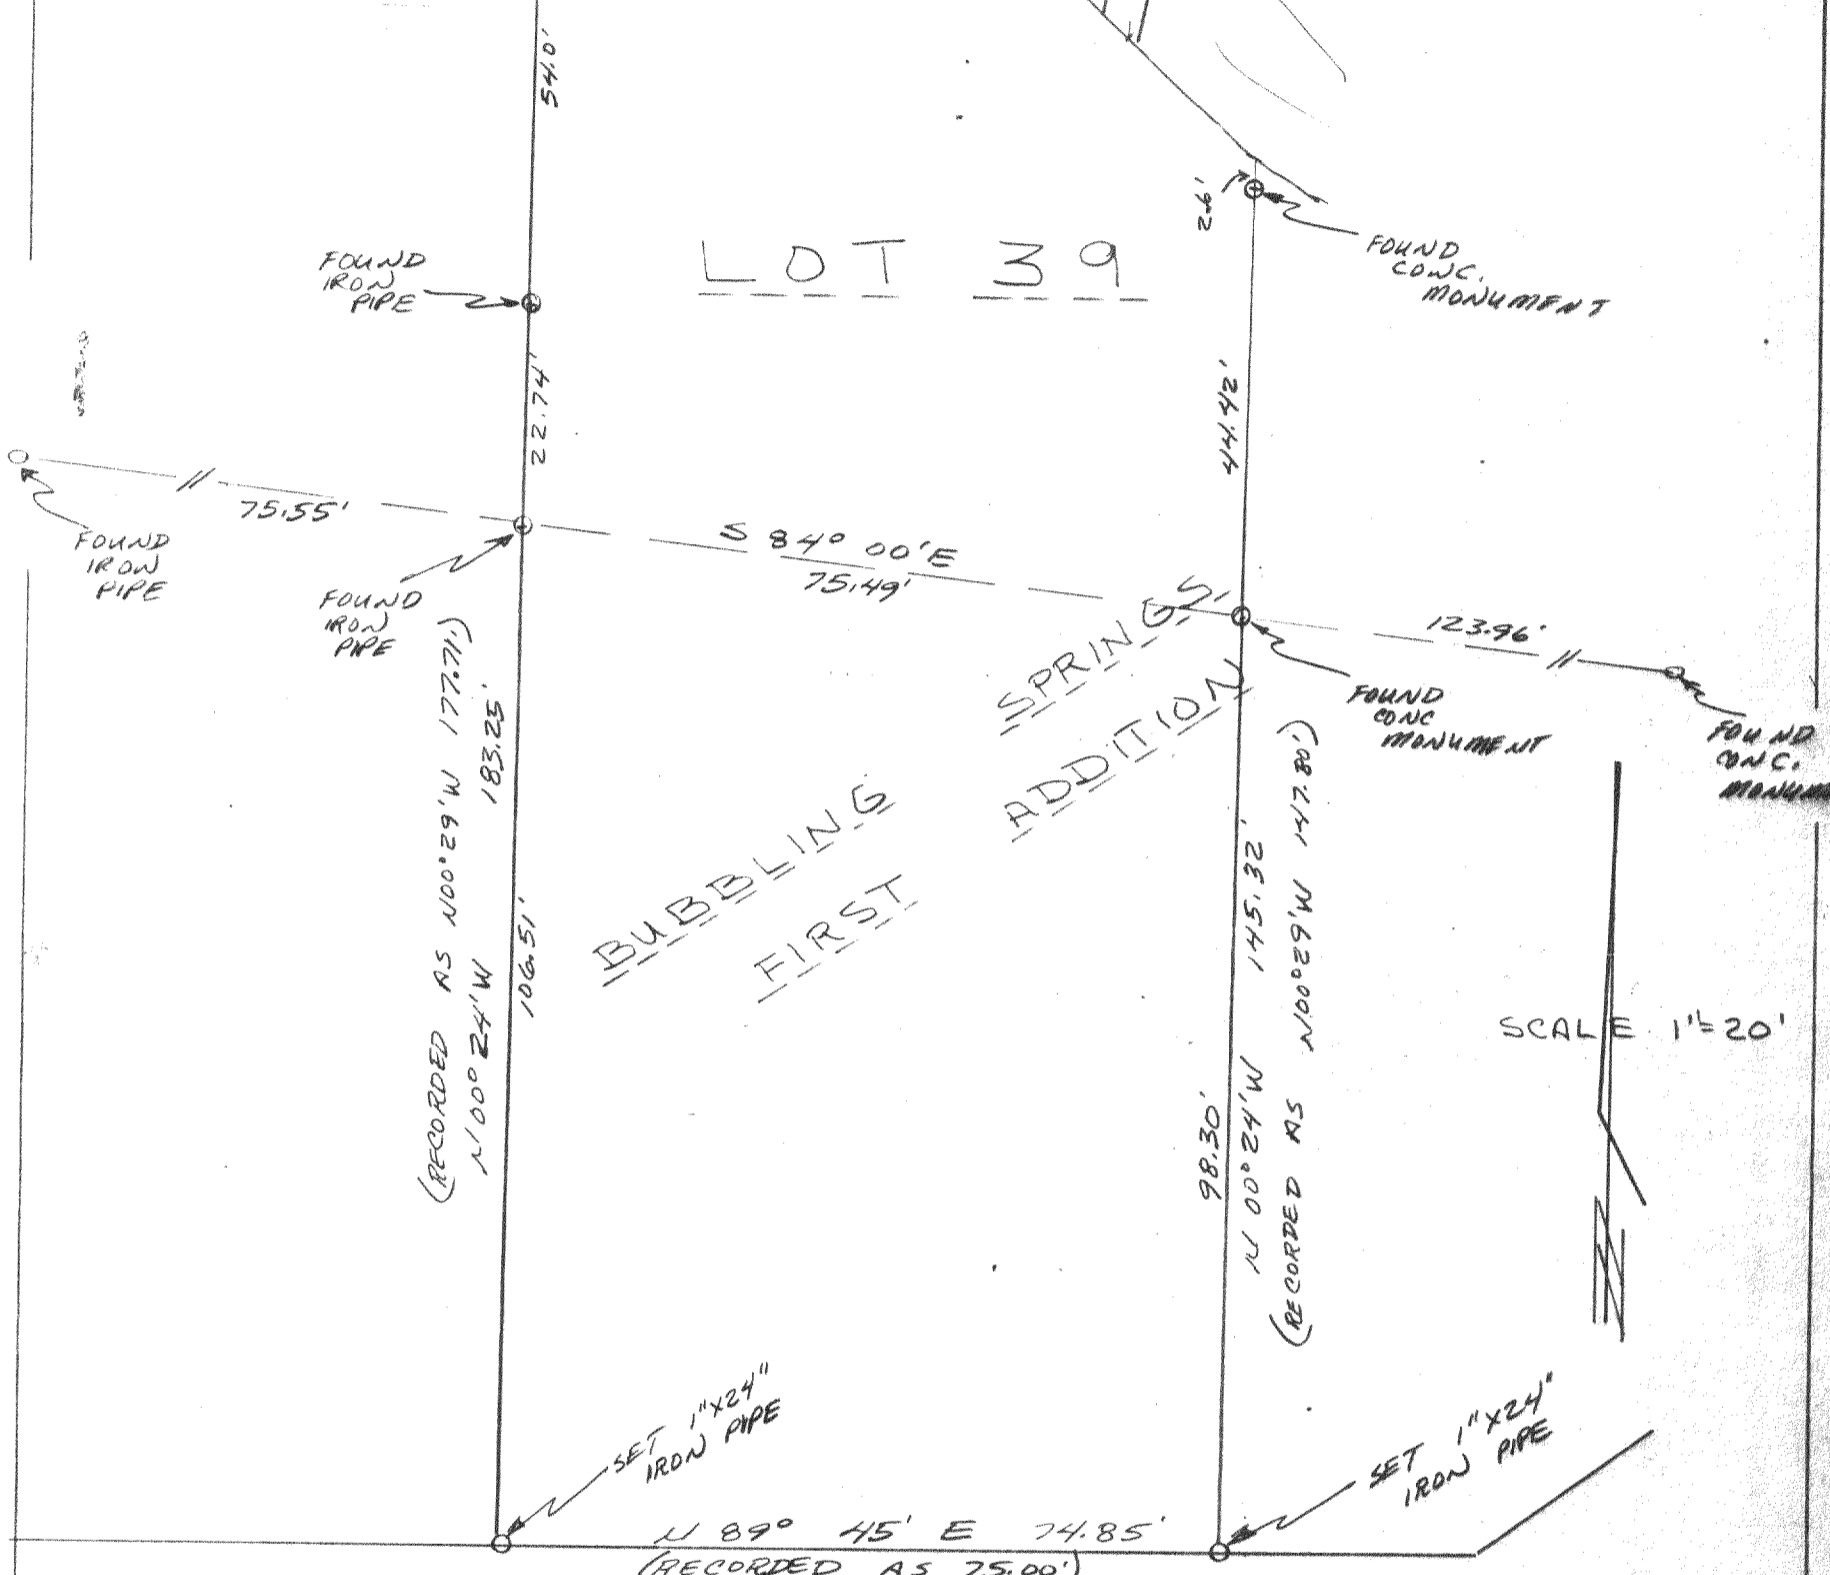

Plat of survey of lot 39 Bubbling Springs First Addition
being in the Town of Lagrange Walworth County Wisconsin

Survey ordered by Modern Realty - Elkhorn


Bearing reference: Westerly line
of parcel assumed to bear N00°24'W

BUBBLING
SPRINGS
DRIVE

I, Daniel D. Cooper, Registered Land Surveyor do hereby certify that
I have surveyed the property described hereon and that the map shown
hereon is a true and accurate representation thereof to the best of my
professional knowledge and belief.

Dated this 10th day of July, 1986

Daniel D. Cooper
Daniel D. Cooper, RLS NO. S-1464

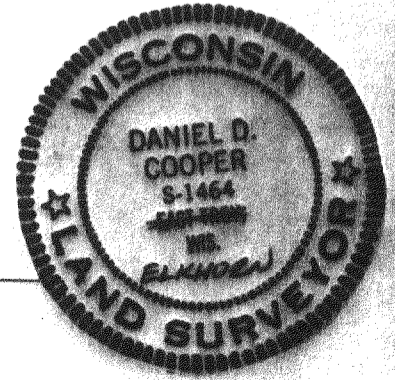

DRAWING NO. 2255-5-3

HBSI-8

TAX NO. HBSI - 00008