

WEST SHORE DRIVE
N 51° 02' E
N 46° 00' E
GARAGE
FOUND IRON PIPE
CHAIN LINK FENCE ON LINE


RECEIVED
APR 9 1987
D.D.

D. D. COOPER & CO., INC.
Daniel D. Cooper
Rt. 4 Box 508B
Elkhorn, WI 53121

Plat of survey of the Northerly 60 ft. excepting there from the Northerly 10 ft. of lot 14 Morris Park subdivision, being located in town 4 North range 16 East, Walworth County Wisconsin.

SCALE 1" = 20'

BEARING REFERENCE: EASTERLY LINE OF WEST SHORE DRIVE ASSUMED TO BEAR N 46° 00' E

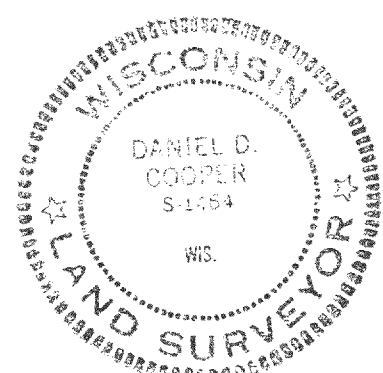

I, Daniel D. Cooper, Registered Land Surveyor do hereby certify that I have surveyed the property described hereon and that the map shown hereon is a true and accurate representation thereof to the best of my professional knowledge and belief.

Dated this 24 day of MAR., 1987

HMD-11A

Daniel D. Cooper
Daniel D. Cooper, RLS NO. S-1464

PART OF LOT 14 MORRIS PARK

NORTHERLY LINE
S 54° 14' E
(RECORDED)
5.7
190.78'

CHAIN LINK FENCE 0.4' INSIDE LINE
4.4'

SOUTHERLY LINE
(RECORDED)
LOT 14
S 56° E 14'

204.93'

WIRE FENCE 0.9' INSIDE LINE

224.10' (RECORDED 220')

SET 1" x 24" IRON PIPE

LAUDERDALE LAKES

N 30° 03' E
50.93' (RECORDED 50')

FOUND IRON PIPE

DRAWING NO 3048-5-3

416-426