


of

Surveyed for: Colony Realty
16 East Walworth Street
Elkhorn, Wisconsin 53121

Mapping date: September 4, 1987

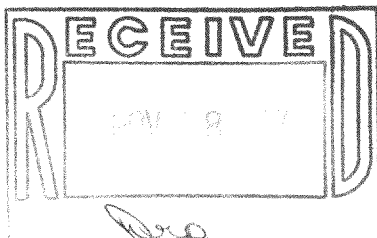


SCALE: 1" = 30'

LEGEND

0 ~ FOUND IRON PIPE

BEARINGS REFERENCED TO
THE SUBDIVISION PLAT

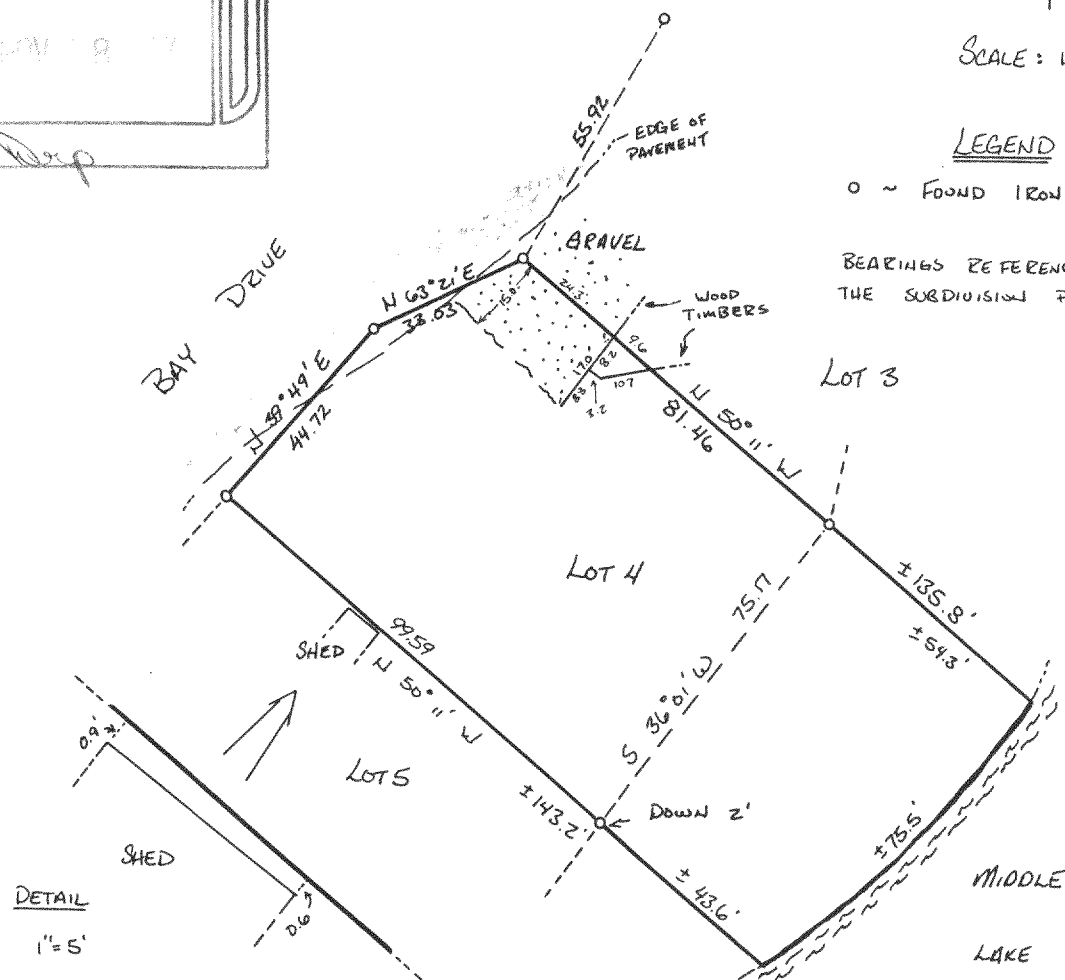

All rights reserved. No part of this survey plat may be reproduced or transmitted in any form by any means - graphic, electronic, or mechanical, including photocopying, tracing, or information storage and retrieval systems - without permission in writing from Thomas P.A. Jensen, Jensen Surveying & Mapping S.C.

Note: This survey plat is not
certified unless signed
and sealed in red ink.

Thomas P.A. Jensen R.L.S-1084
Jensen Surveying & Mapping S.C.

JOB REFERENCE NO. 1987.101

416-470