





SCALE - 1"=40'

LEGEND

- Ø - IRON PIPE FOUND  
● - IRON ROD FOUND  
( ) - RECORDED AS

ORDERED BY: COLONY REALTY  
16 E. WALWOATH ST.  
ELKHORN, WI. 53121

SURVEYED BY: ABELL SURVEYING & MAPPING  
1140 SEQUOIA ST.  
DELAVAN, WI. 53115  
414-728-6737

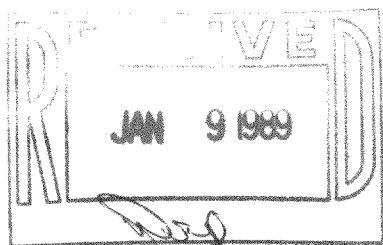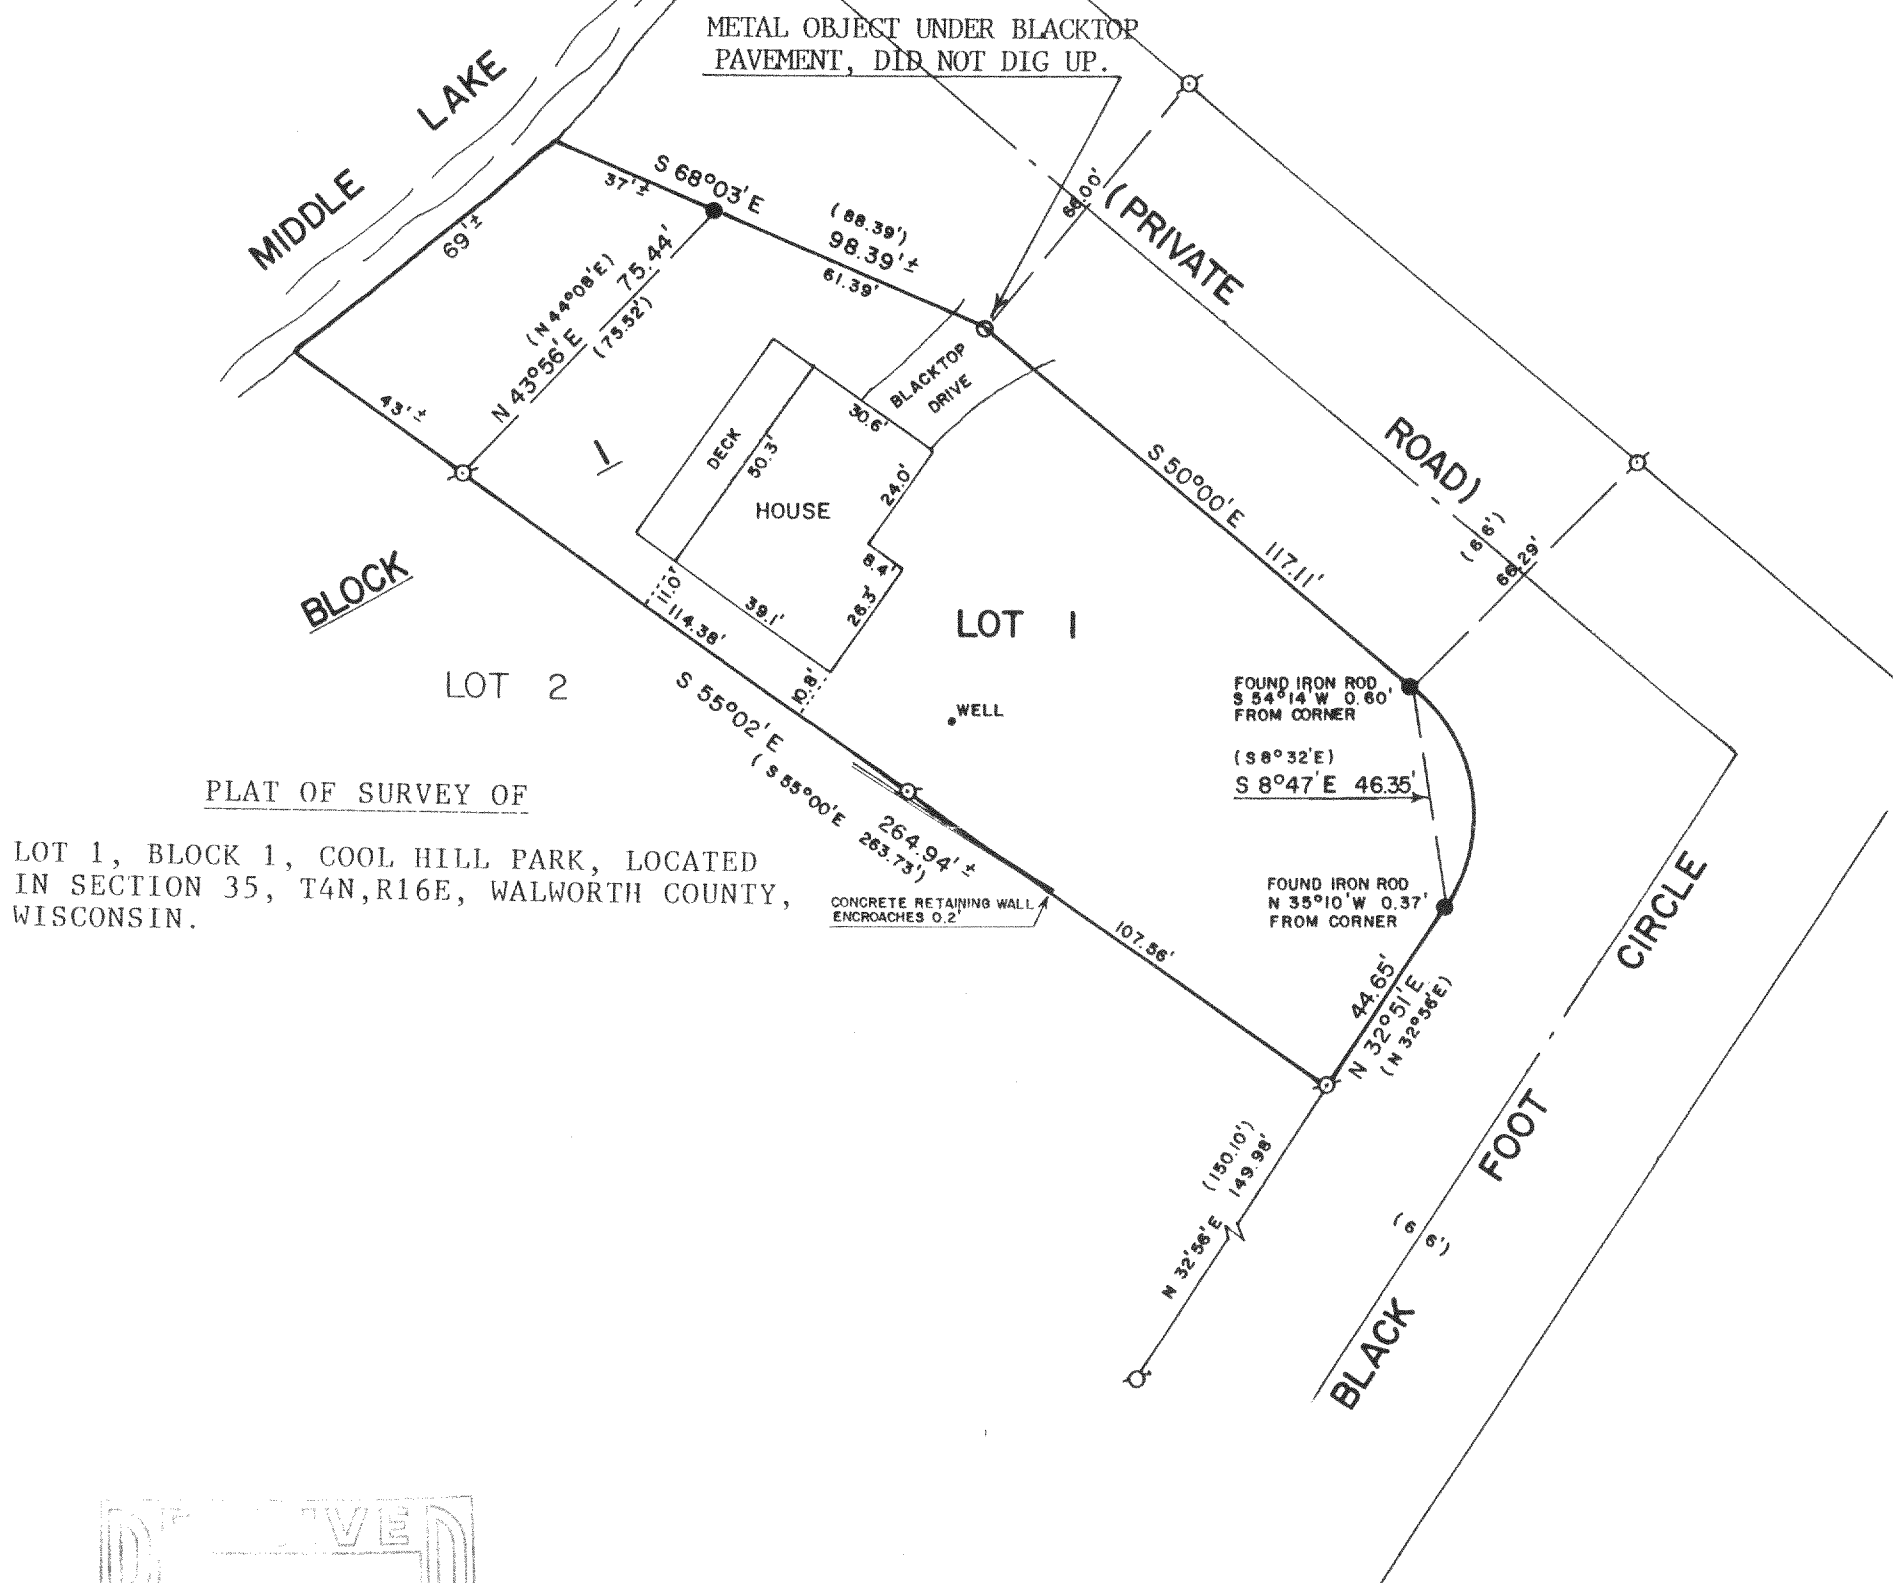

I HEREBY CERTIFY THAT I HAVE SURVEYED THE ABOVE DESCRIBED PROPERTY AND THAT THE ABOVE MAP IS A TRUE REPRESENTATION THEREOF AND SHOWS THE SIZE AND LOCATION OF THE PROPERTY, ITS EXTERIOR BOUNDARIES, THE LOCATION OF ALL VISIBLE STRUCTURES AND DIMENSIONS OF ALL PRINCIPAL BUILDINGS THEREON, BOUNDARIES FENCES, APPARENT EASEMENTS, ROADWAYS AND VISIBLE ENCROACHMENTS, IF ANY, TO THE BEST OF MY KNOWLEDGE AND BELIEF.

THIS SURVEY IS MADE FOR THE USE OF THE PRESENT OWNERS OF THE PROPERTY, AND ALSO THOSE WHO PURCHASE, MORTGAGE, OR GUARANTEE THE TITLE THERETO WITHIN ONE (1) YEAR FROM DATE HEREOF.

*David F. Abell*

DAVID F. ABELL  
WISCONSIN REGISTERED LAND SURVEYOR, S-1596

DATE: *December 2, 1988*

JOB NUMBER - 88273

NOTE: THIS IS NOT A CERTIFIED COPY UNLESS SEALED.

416-541