


PLAT OF SURVEY OF LOT 16, BUBBLING SPRINGS SUBDIVISION,
LOCATED IN SECTION 34, T4N, R16E, WALWORTH COUNTY, WISCONSIN.

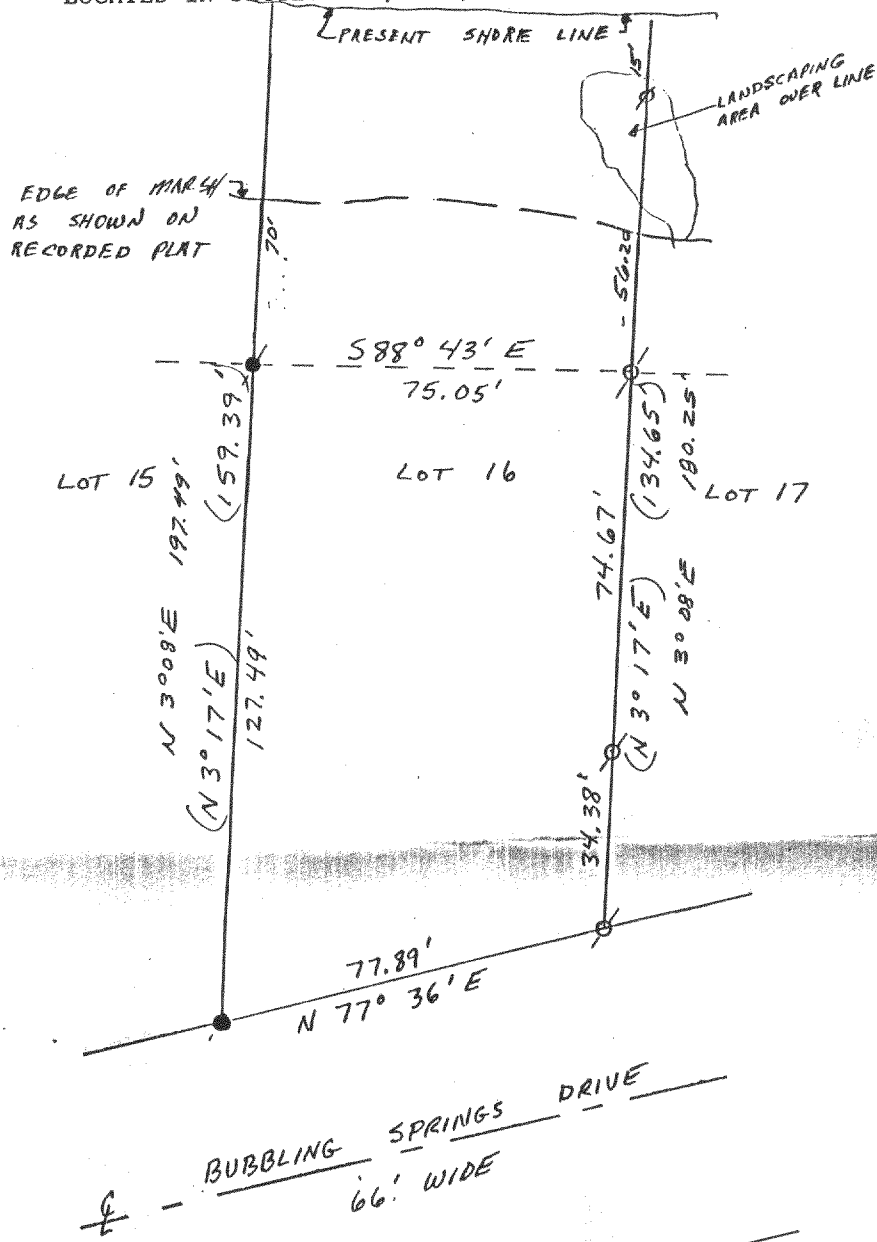


I hereby certify that I have surveyed the property described hereon and that the map shown hereon is a true and accurate representation thereof to the best of my professional knowledge and belief.

Dated this 9th day of NOVEMBER, 1989

Daniel D Cooper

Daniel D. Cooper, RLS No. S-1464

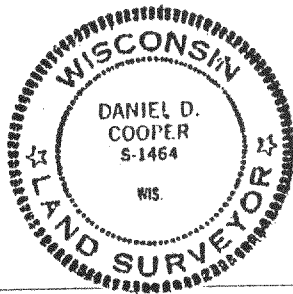


Legend

- Indicates county monument
- Ø Indicates iron pipe found
- Indicates 5/8" di. x 24" iron rod set
- Indicates iron rod found

Scale: 1" = 30'

Date: Nov. 9, 1989

Drawing No: 3544-20

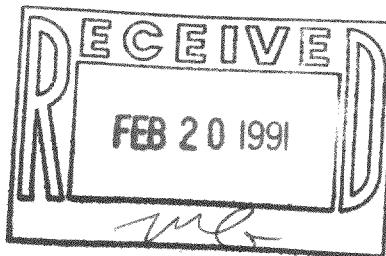

Reduced

TAX KEY # HBS 00016

416-639