

HAROLD H. KOLB

REGISTERED PROFESSIONAL LAND SURVEYOR
LAKE GENEVA, WISCONSIN

PLAT OF SURVEY OF

A parcel of land located in the Southwest 1/4 of Section 15, T 4 N, R 16 E, Walworth County, Wisconsin and described as follows: Commencing at the Southwest corner of said Section 15; thence North 602.58 feet, along the centerline of Kettle Moraine Drive, to the place of beginning; thence continue North 496.53 feet along said centerline; thence N 54°34' E 273.54 feet along the centerline of Greening Road; thence South 647.96 feet; thence S 88°07' W 223.00 feet to the place of beginning.

Containing 2.93 Acres.



NOTE: bearings are assumed, from description of Kettle Moraine Drive.



SCALE: 1" = 100'

LEGEND

- ⊗ — IRON PIPE FOUND
- — IRON PIPE PLACED
- — CONCRETE MONUMENT
- X— Fence

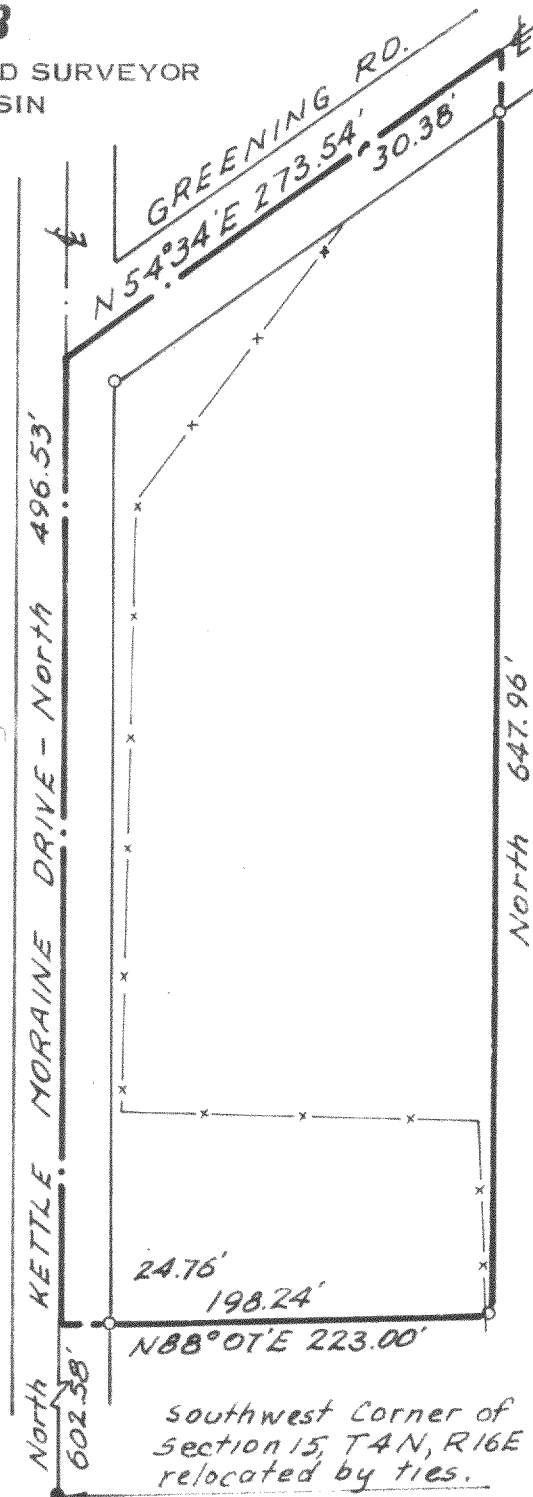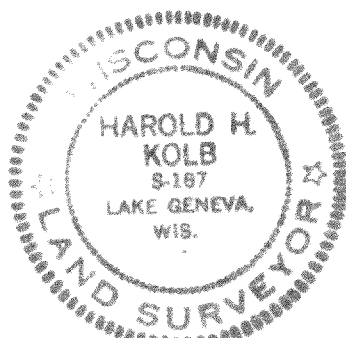

I, HAROLD H. KOLB, DO HEREBY CERTIFY THAT I HAVE SURVEYED THE PROPERTY HEREON DESCRIBED ACCORDING TO THE OFFICIAL RECORDS, AND THAT THE PLAT HEREON IS A CORRECT REPRESENTATION OF THE LOT LINES.

Harold H. Kolb

HAROLD H. KOLB
WISCONSIN REGISTERED LAND SURVEYOR, S-187
DATE August 13, 1970

LG-15-7

416-73