

PLAT OF SURVEY OF LOTS 9, 10 & 11 OF BLOCK 1 OF
 THANSLAND SUBDIVISION A SUBDIVISION LOCATED IN SECTION 35, T4N, R16E WALWORTH COUNTY
 WISCONSIN, EXCEPTING THEREFROM A PARCEL OF LAND LOCATED IN LOT 9 OF SAID SUBDIVISION
 MORE PARTICULARLY DESCRIBED AS FOLLOWS; BEGIN AT THE NW CORNER OF LOT 9; THENCE
 S3°36'21"E 94.36 FEET; THENCE N16°02'08"E 84.49 FEET; THENCE N66°10'21"W 32.00 FEET
 TO THE POINT OF BEGINNING.

JENSEN SURVEYING & MAPPING S.C.




P.O. Box 322

45 S. WISCONSIN ST.


ELKHORN, WISCONSIN

PHONE (414) 723-3434

SURVEYED FOR; ROY FORTI
 2517 N. NORDICA AVE.
 CHICAGO, ILL. 60635

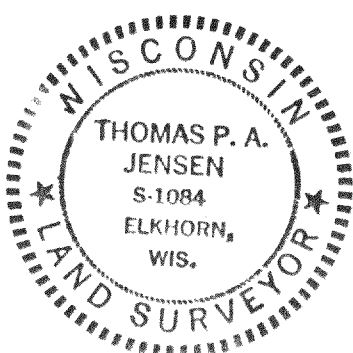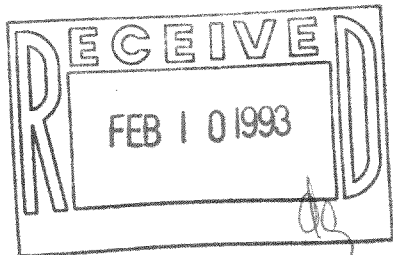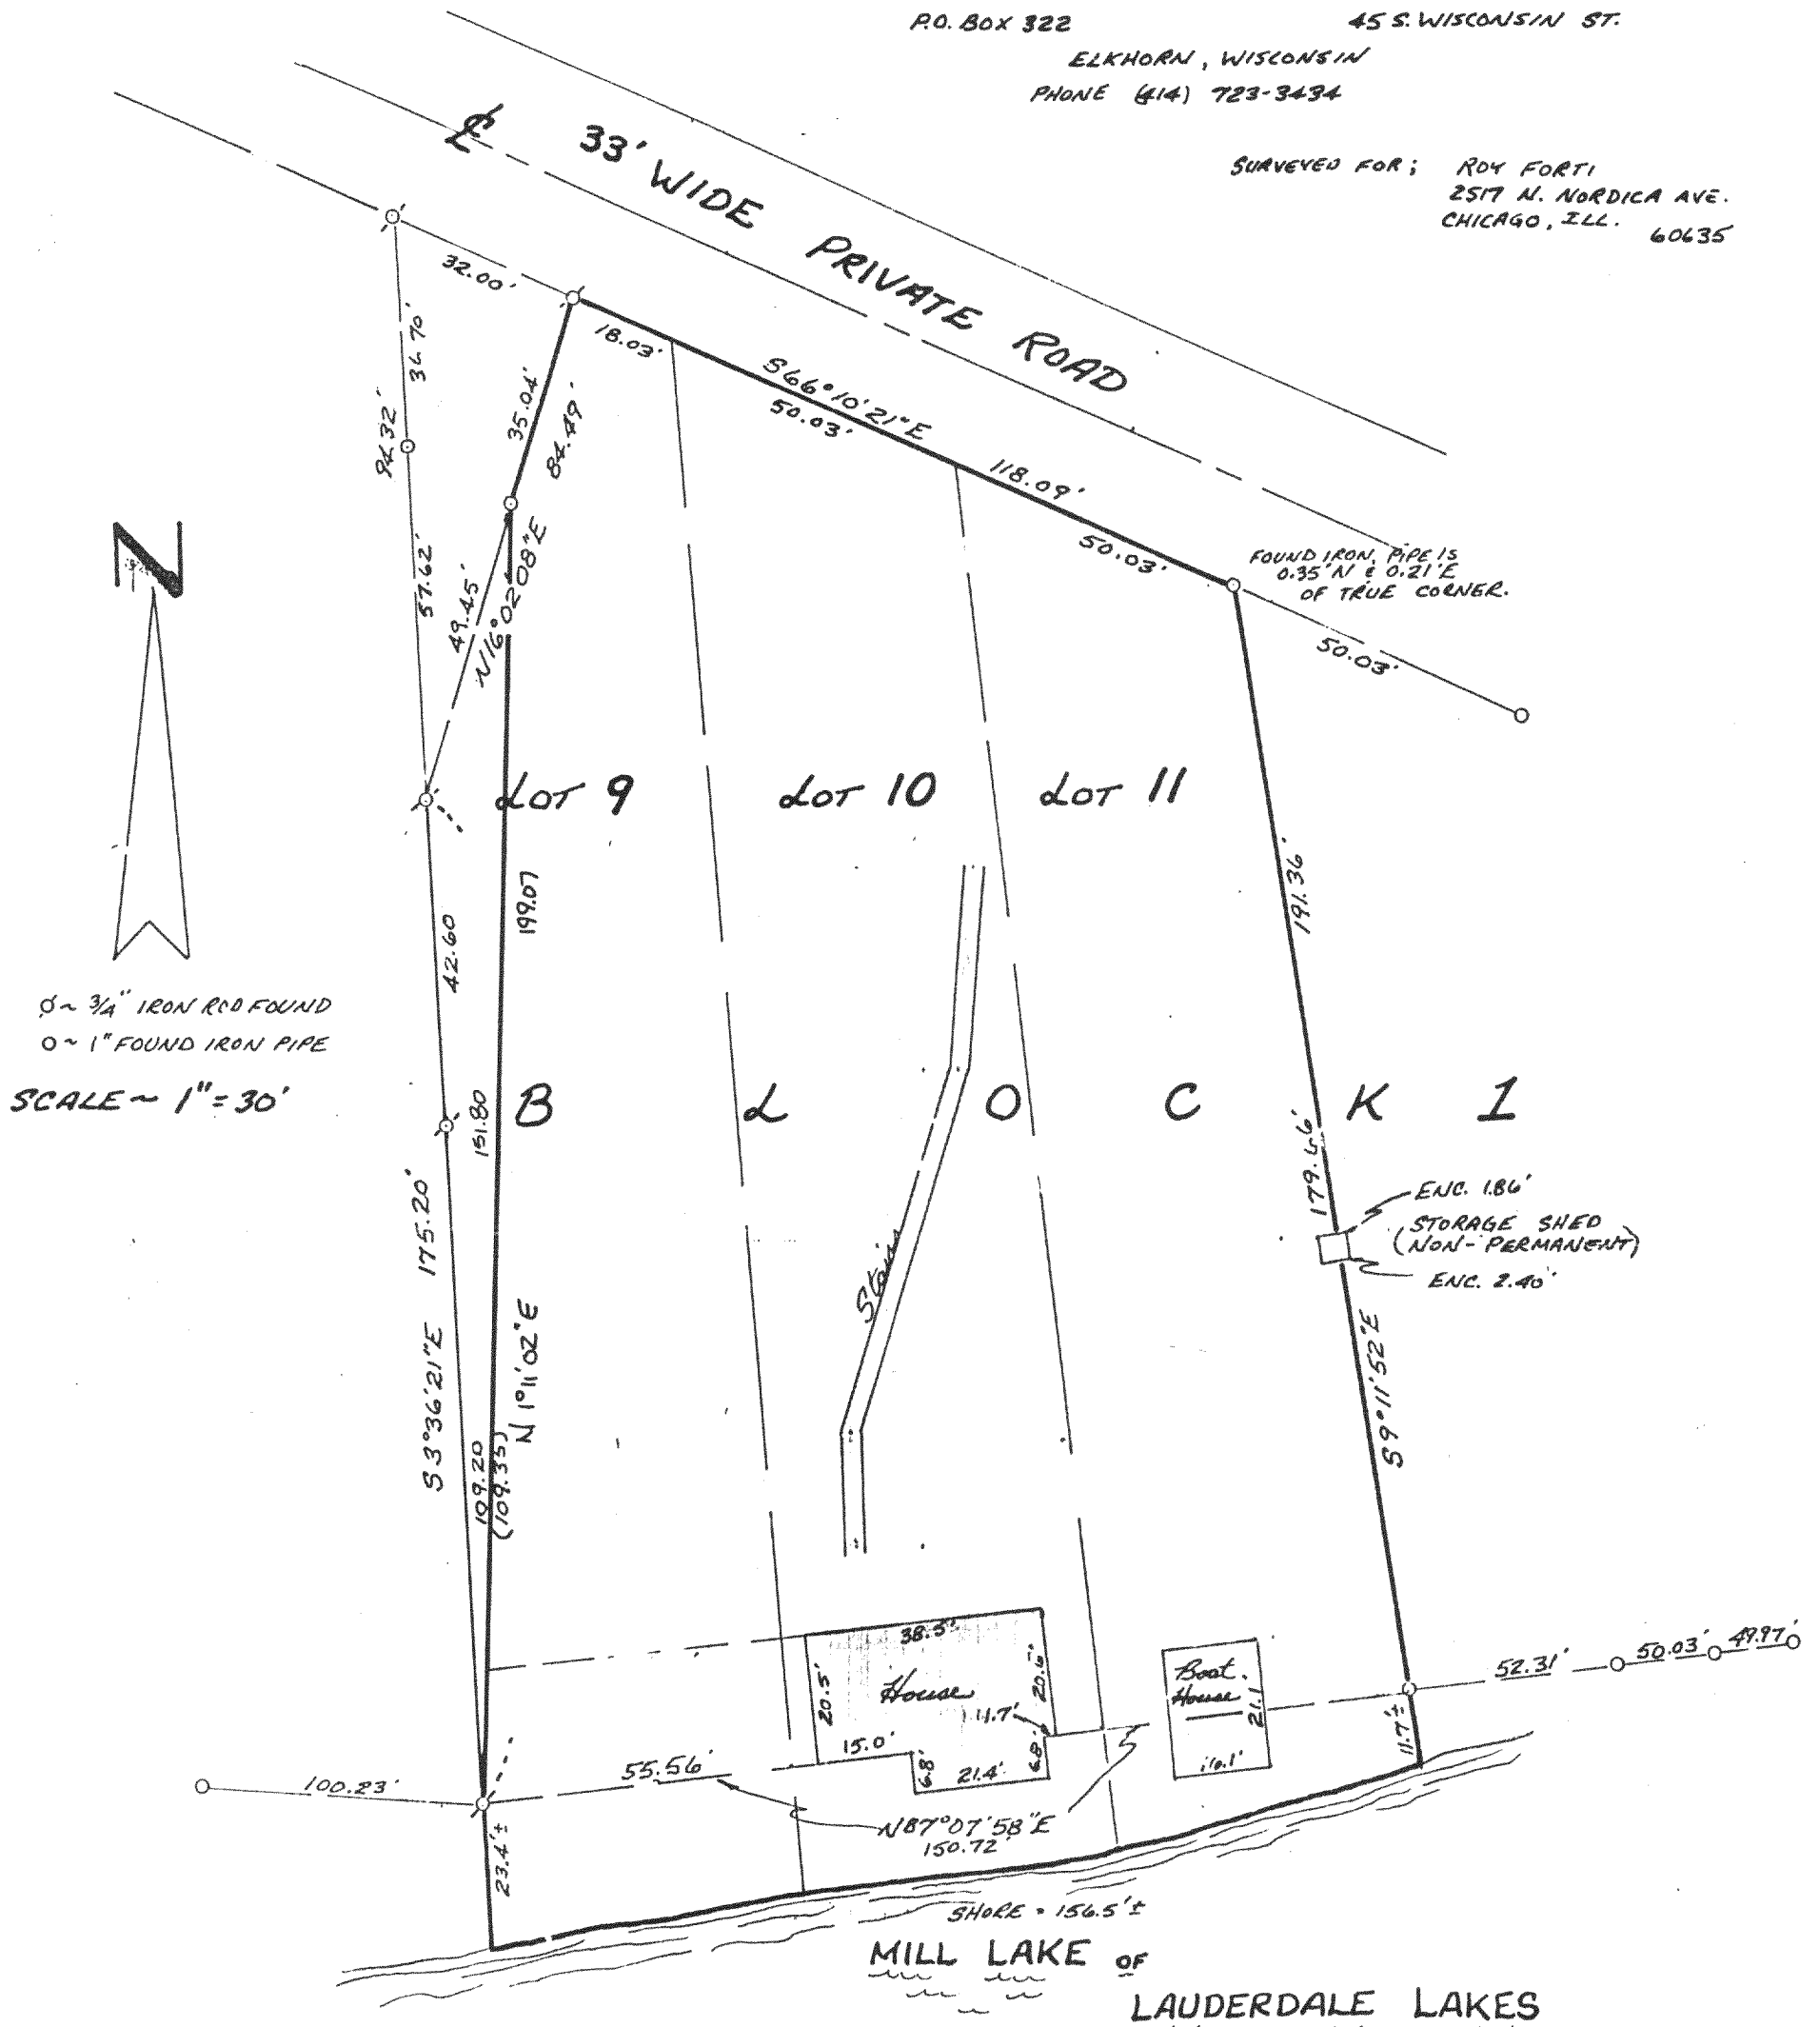

I, THOMAS P. A. JENSEN, WIS. REGISTERED LAND SURVEYOR, DO HEREBY CERTIFY THAT THIS SURVEY WAS PERFORMED BY ME, OR UNDER MY DIRECTION, IN FULL COMPLIANCE WITH THE OWNER'S/ AGENTS' INSTRUCTIONS AND CHAPTER A-ES OF THE WIS. ADMIN. CODE "MINIMUM STANDARDS FOR PROPERTY SURVEYS"; AND THAT THIS MAP IS AN ACCURATE REPRESENTATION THEREOF TO THE BEST OF MY KNOWLEDGE AND BELIEF.

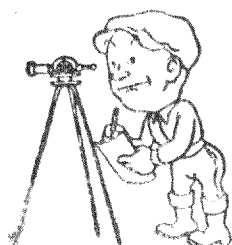

Thomas P. A. Jensen
 THOMAS P. A. JENSEN S-1084

DATE ~ Apr. 25, 1985

REVISED 9-9-92 1992.112

HTL-14

1985.017

416-876