
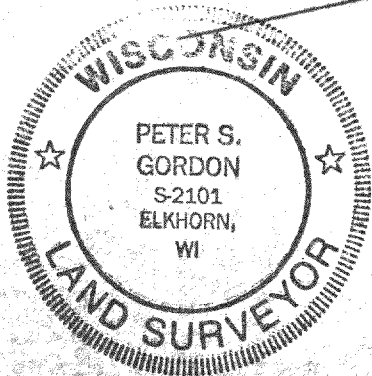


FARRIS, HANSEN & ASSOCIATES, INC.

7 RIDGEWAY COURT, P.O. BOX 437
ELKHORN, WISCONSIN 53121

PLAT OF SURVEY

PHONE: (414) 723-2098
FAX: (414) 723-5886

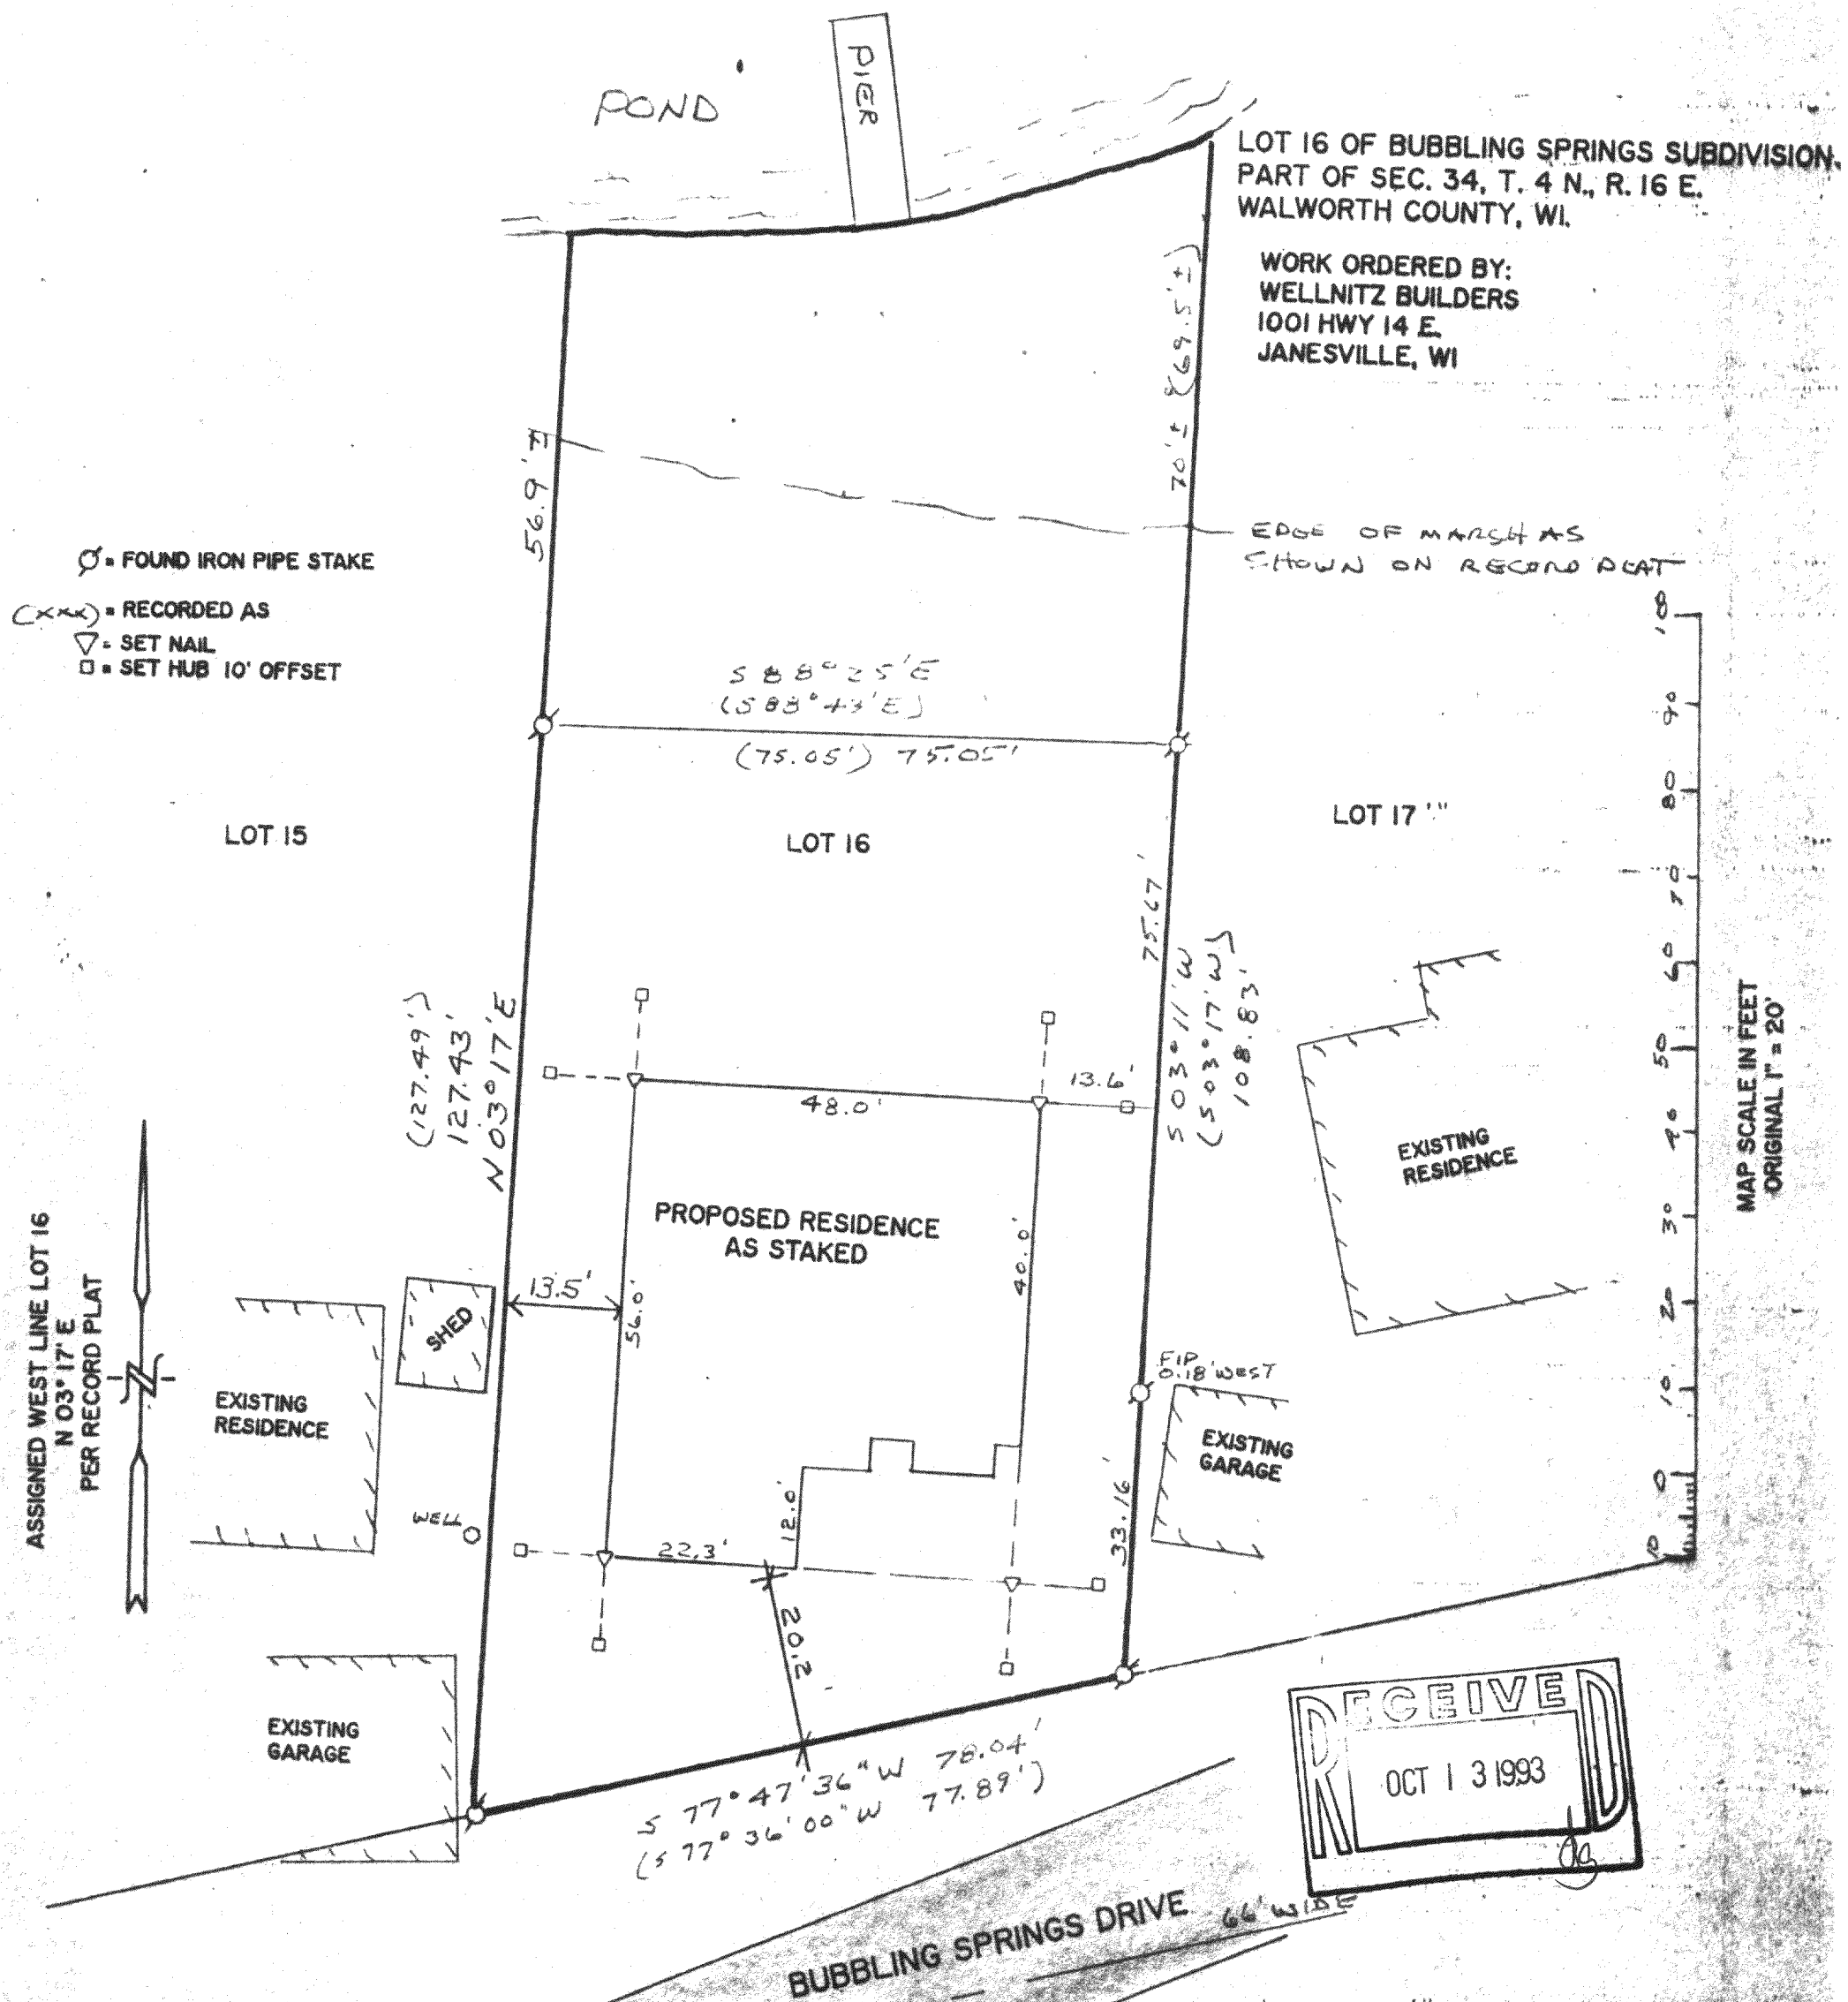

DATED: 08/20/93

PETER S. GORDON RLS 2101

HBS-16

P. 3875

416-5961