


O=INDICATES IRON PIPE

DESCRIPTION: Lot #20 of Strawberry Banke Plantation, a subdivision located in the SW $\frac{1}{4}$  of Section 36 Town 4 North, Range 16 East, and the NW $\frac{1}{4}$  of Section 1 Town 3 North, Range 16 East, Walworth County, Wisconsin.

CERTIFICATE: I, James F. Biagi, surveyor do hereby certify that I have surveyed the property hereon described, and that the location of the improvements are as shown on the drawing.

May 13, 1963.

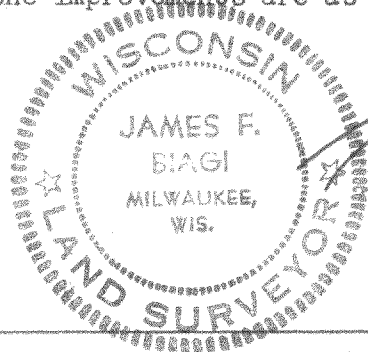

James F. Biagi ILS 272